


Grebe Plat rec. in Vol. 8 Pg 17 L.C.P.R.

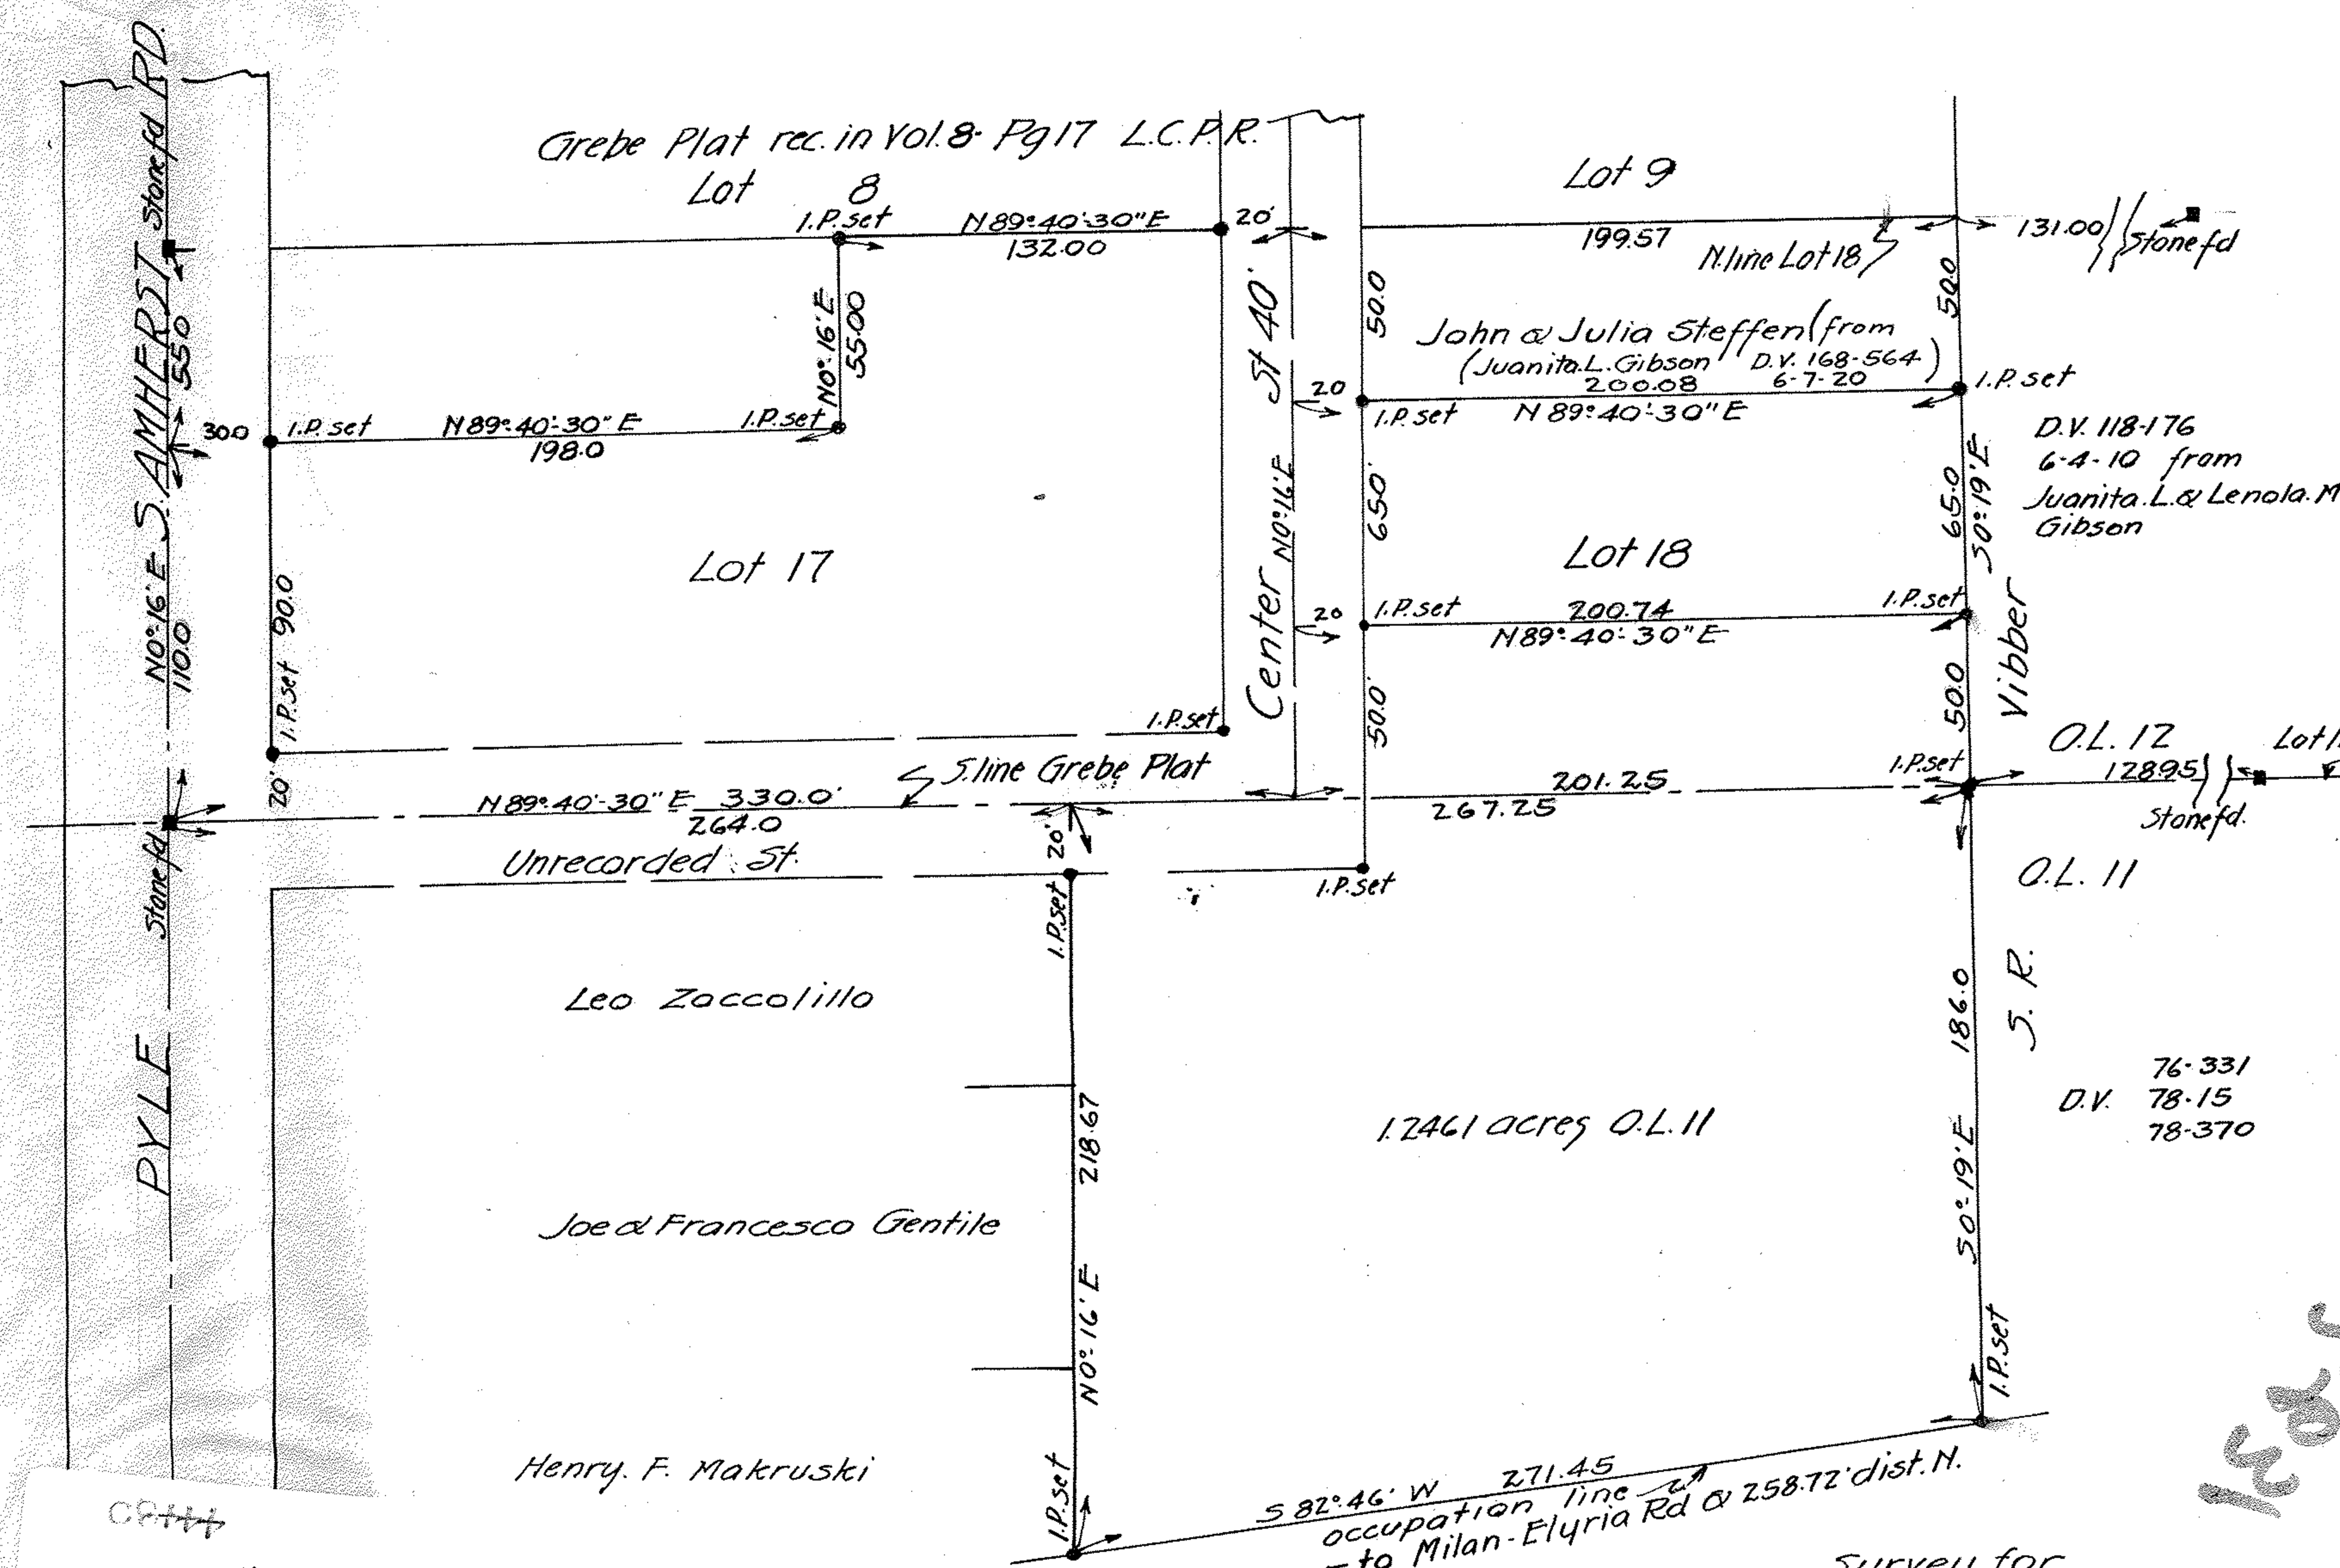

MAP PG 05-00-011-A

PPN 05-00-011-101-222

400541

Survey for
 Ben & Victoria Asziyczik
 Parts of Lots 17 & 18 Grebe Plat &
 Part of Orig Lot 11 Amherst Twp.
 So. Amherst Village, Lorain Co. Ohio.
 Scale 1"=50'
 Sept 26, 1927
 Warden & Laundon, Civil Engineers.

16231