


CLETUS P. AND DOROTHY GILGENBACH  
D-VOL 533 PG. 175 DEC. 27, 1951

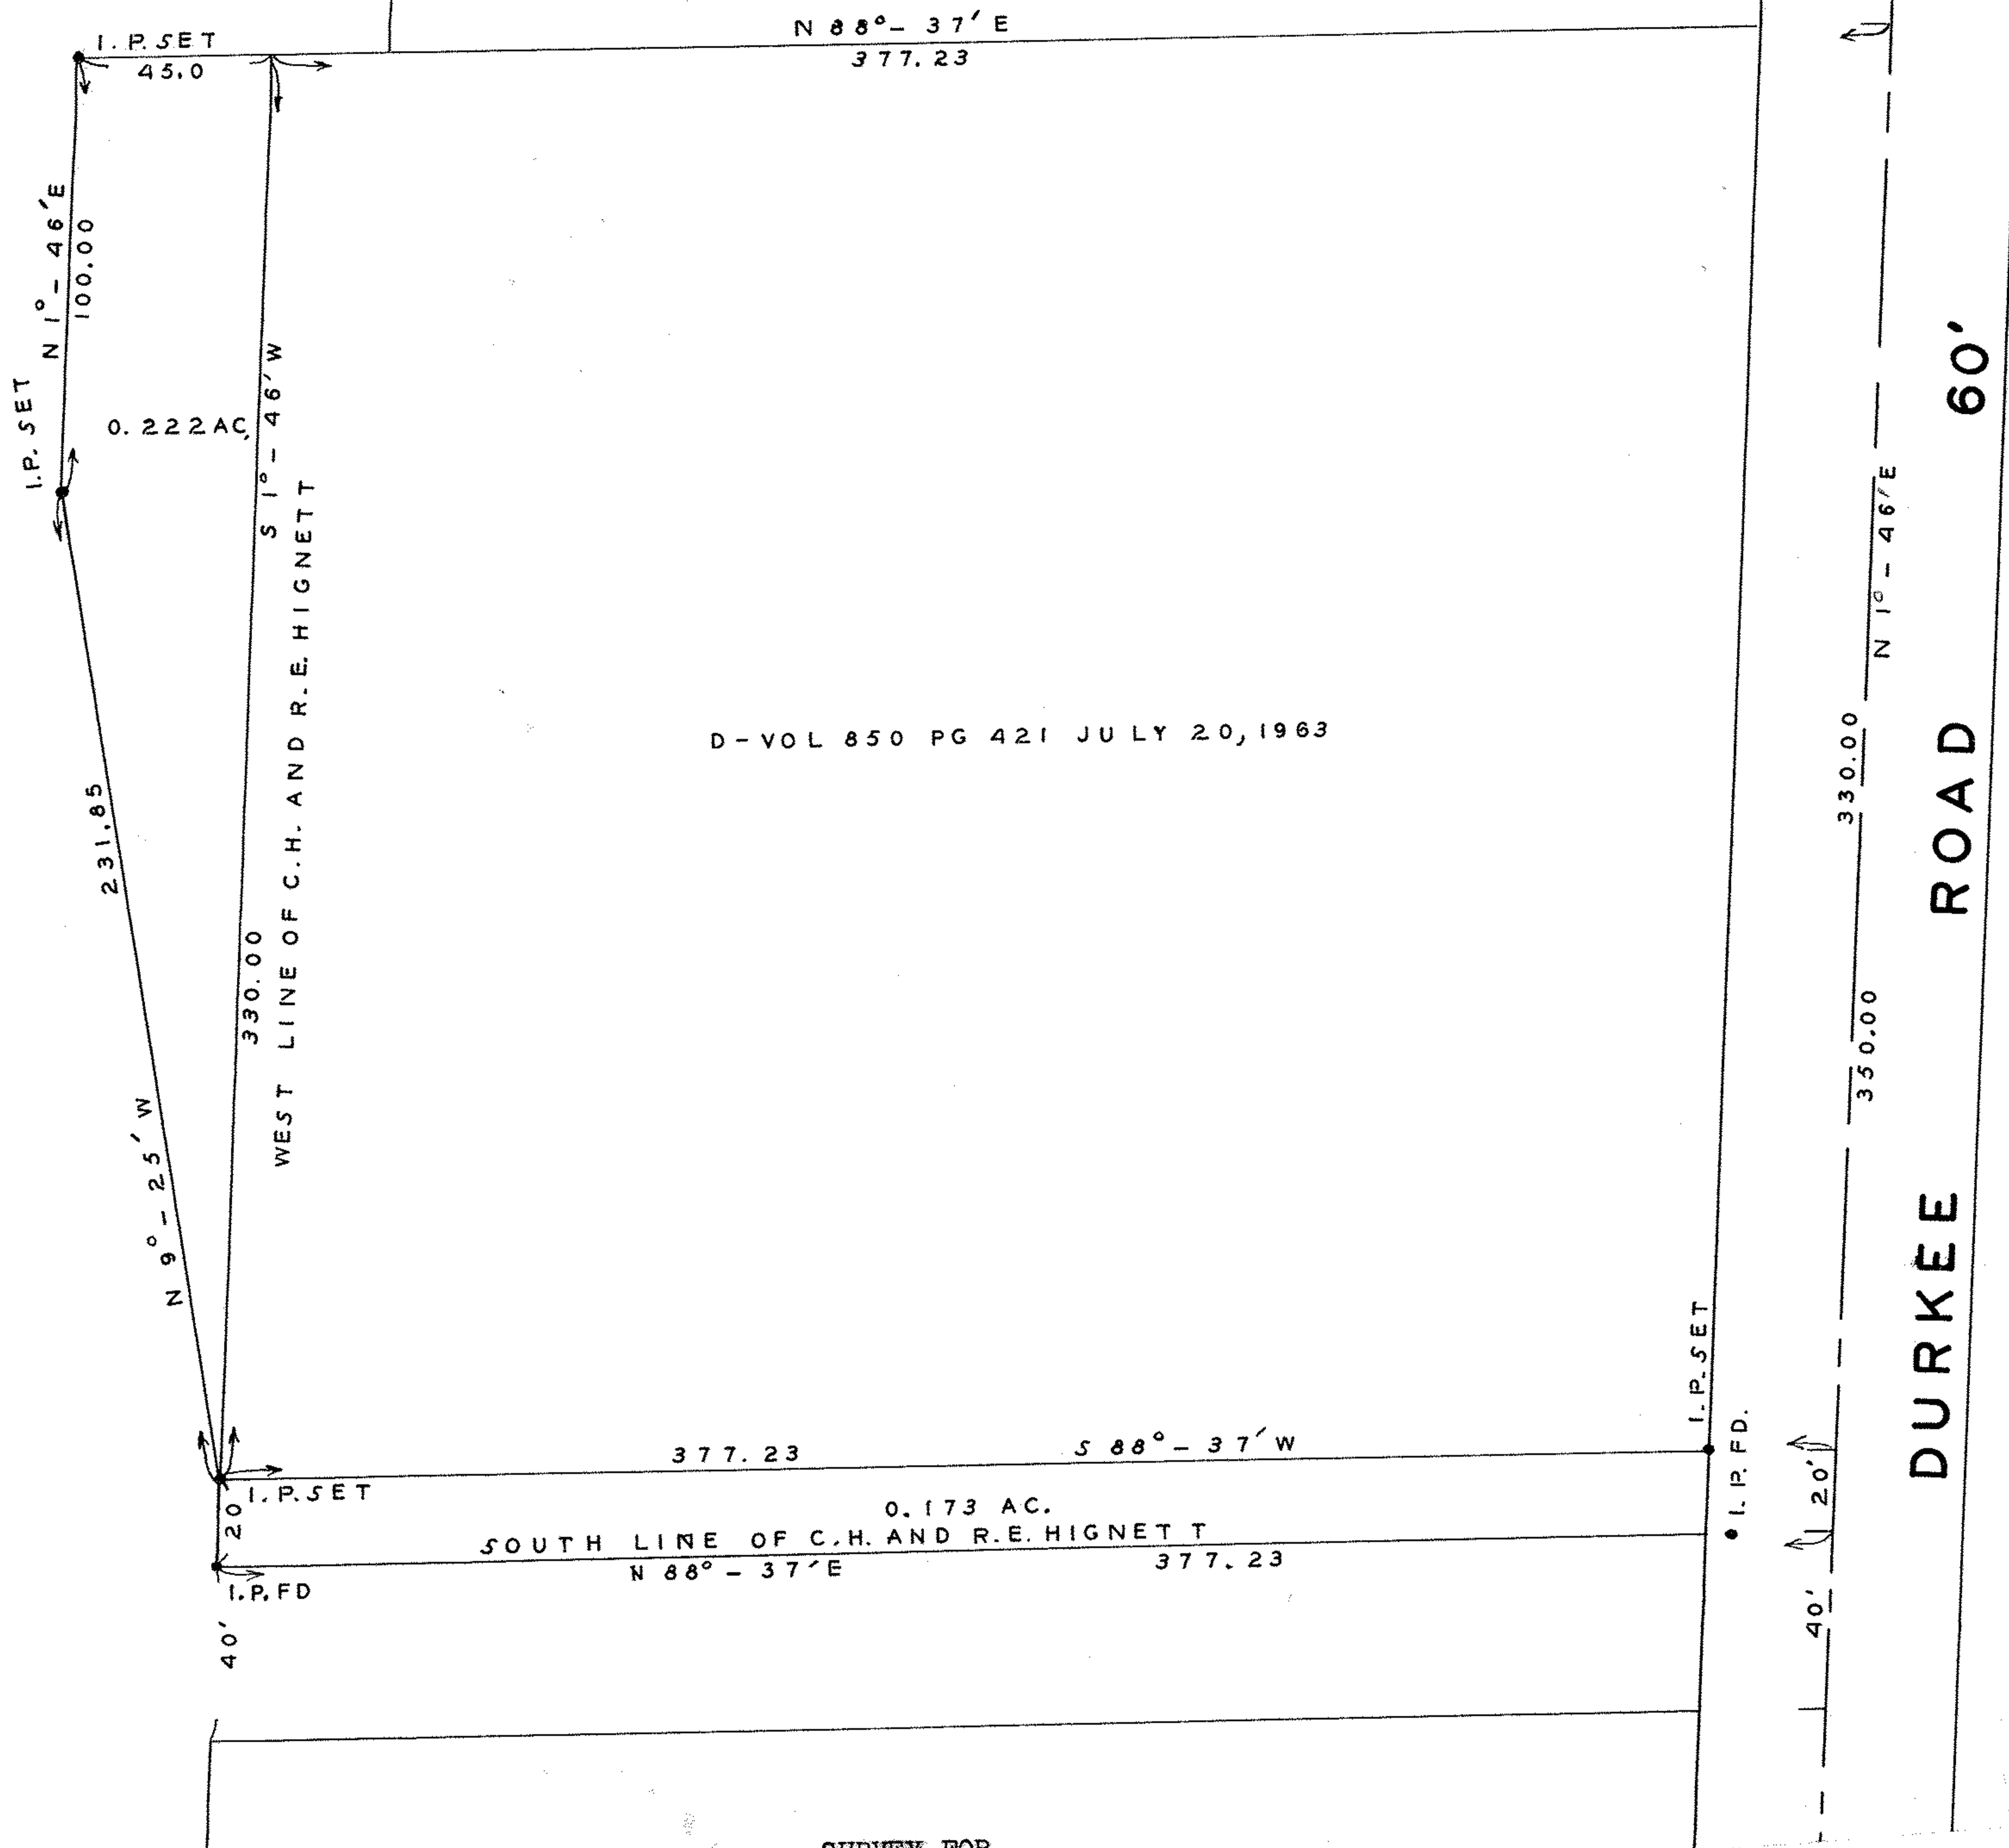

D-VOL 850 PG 421 JULY 20, 1963

SURVEY FOR  
CLYDE H. AND RUTH E. HIGNETT  
LOT 88 EATON TOWNSHIP  
LORAIN COUNTY, OHIO  
SCALE 1" = 40' NOV. 25, 1963  
J. W. WARDEN AND ASSOCIATES  
REG. SURVEYORS

PPN 11-00-088-000-???

mnp pg 11-00-088-B  
44486

501423

2501-2

Z

2

4