Map of Survey for
ELYRIA TWP. BOARD OF EDUCATION

Original Lot #16- Brace Tract.

Elyria Twp. Lorain Co.,

Ohio.

Jan. 22. 1914. T. L. Gibson C.E.

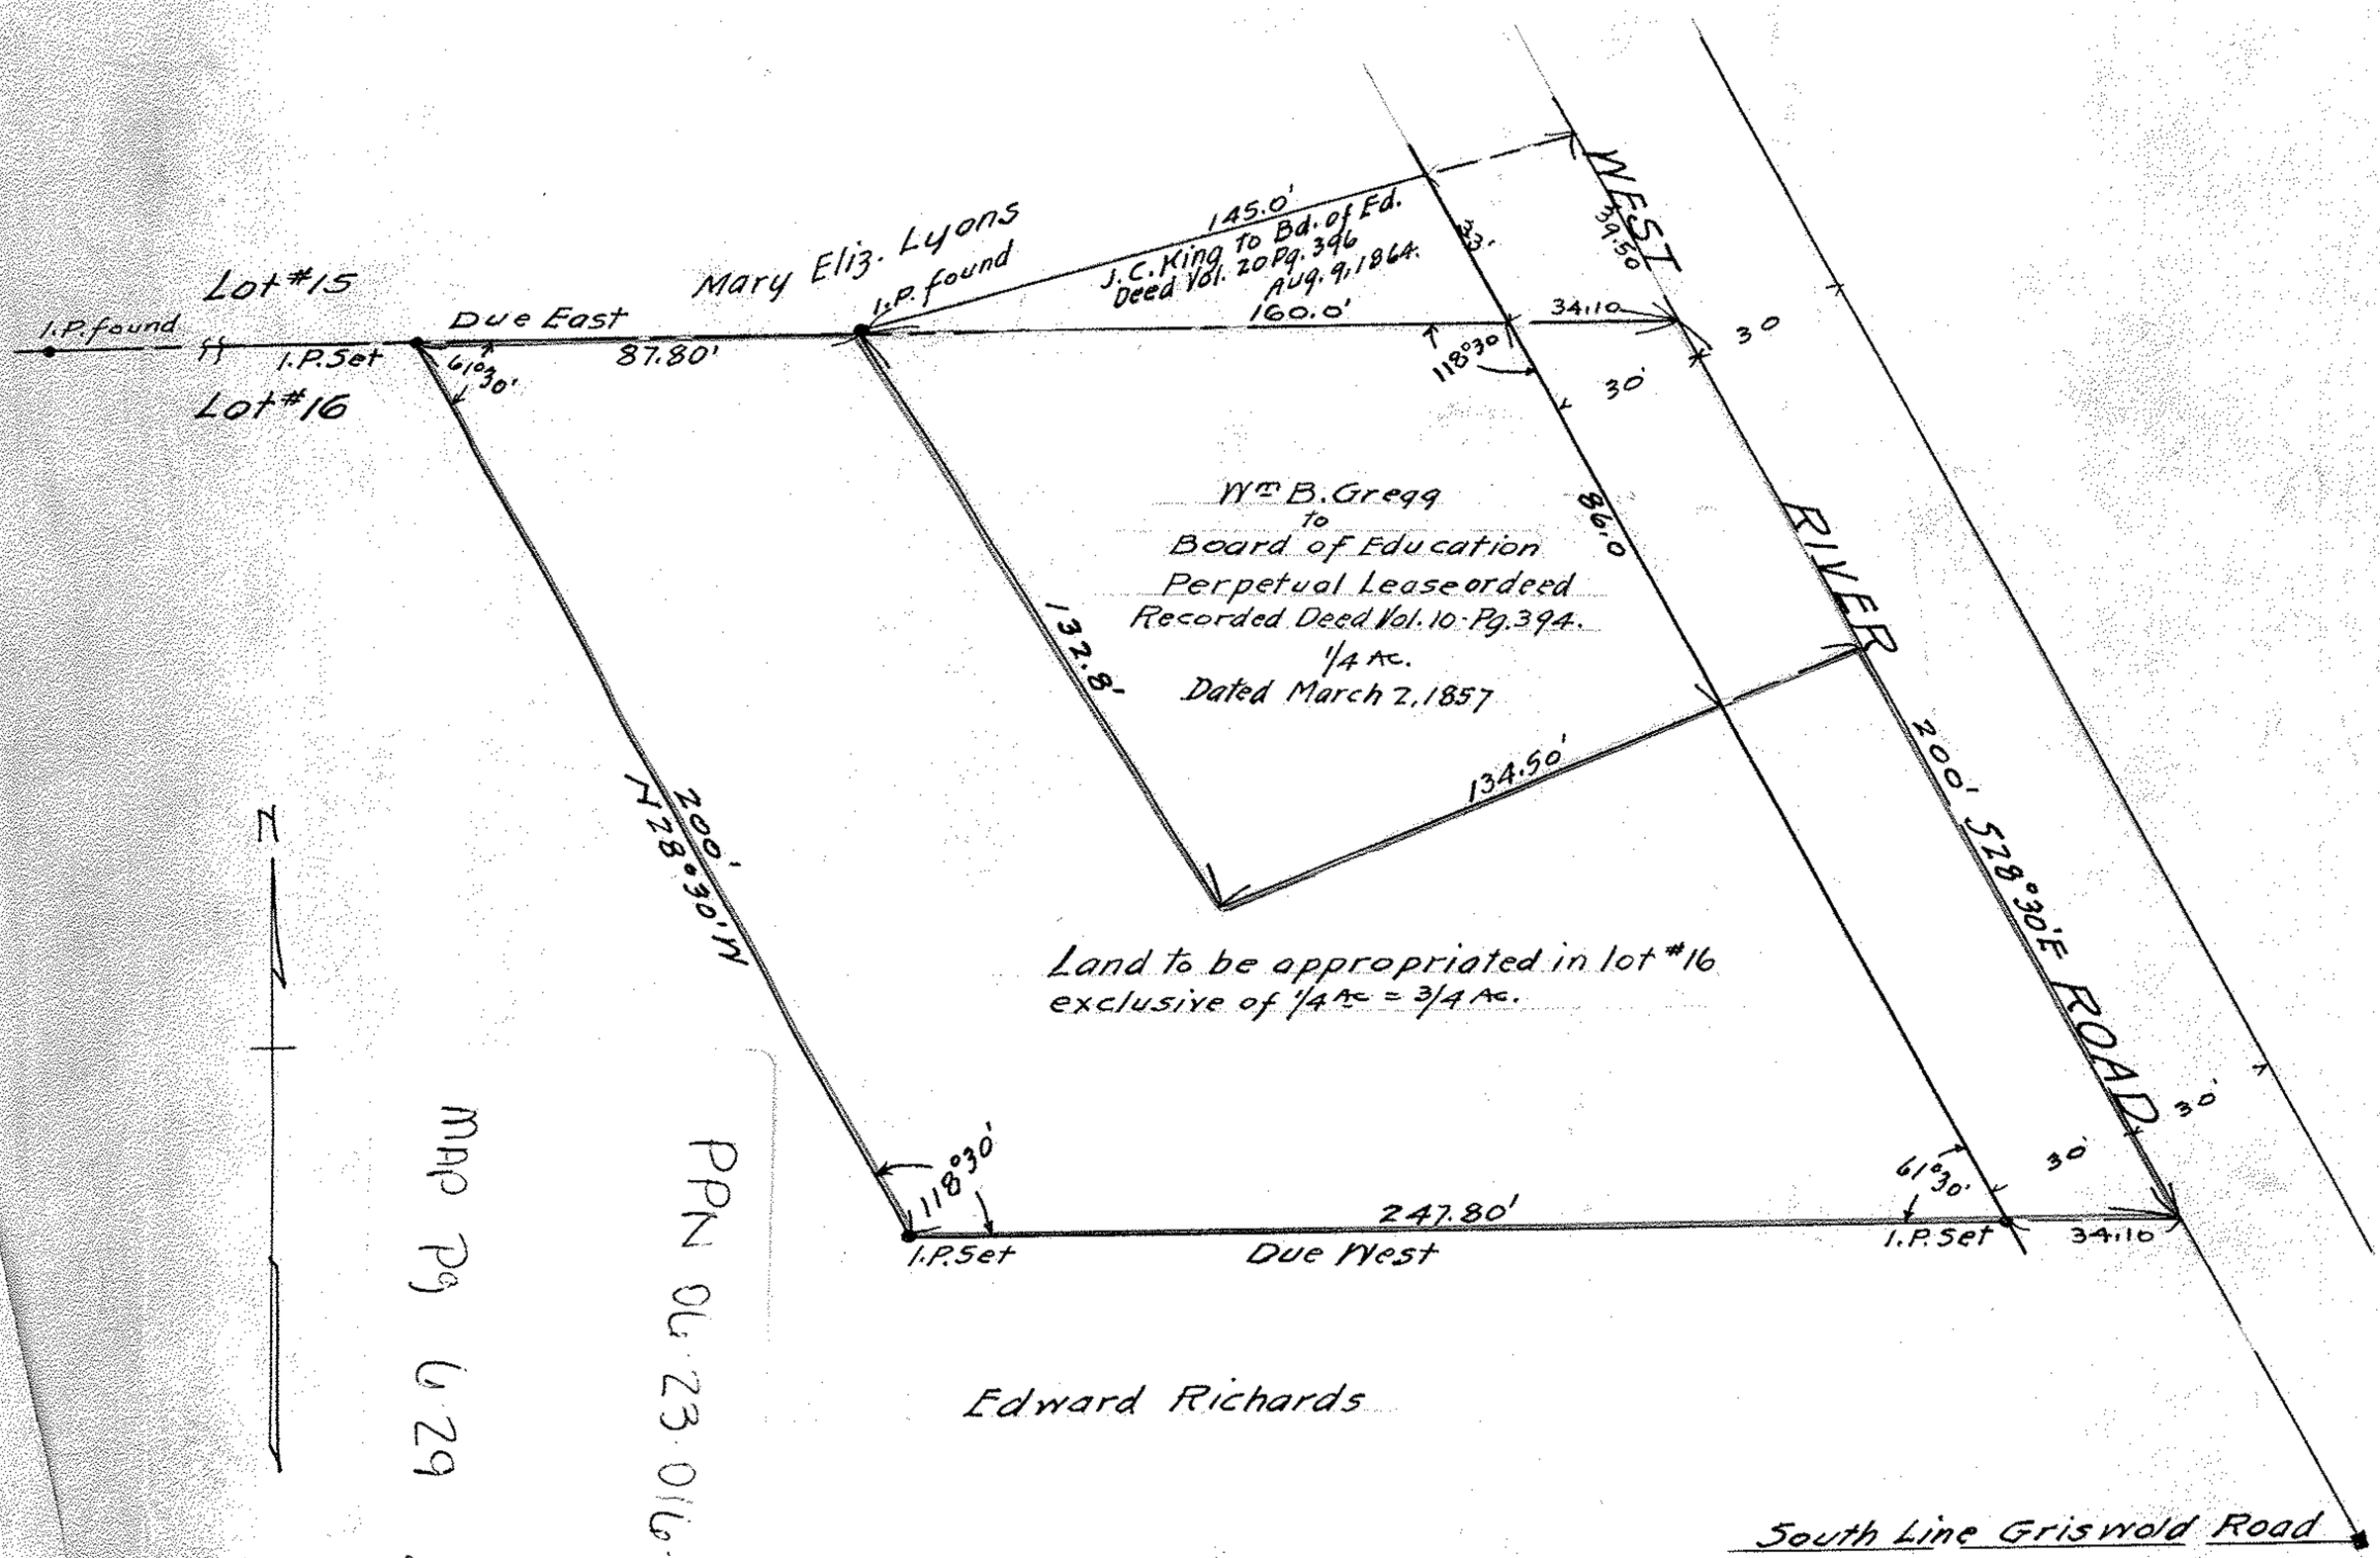

Map Pg 629 4449

PPN 04-23-016-102-222

522258

2