MAP OF SURVEY MADE FOR

R. S. Silsbee, Architect

Part of Lot 128 Block 63. Orig. Vill. Plat

Elyria City

Lorain County, Ohio

Distances are given in feet and decimal parts

Scale, 1 in. 20 Feet
Elyria, O.,
Order No.,
F. B. 4 Pg., 19-21

Warden & Laundon, C. E.
403 ELYRIA BLOCK
9-25-'24.

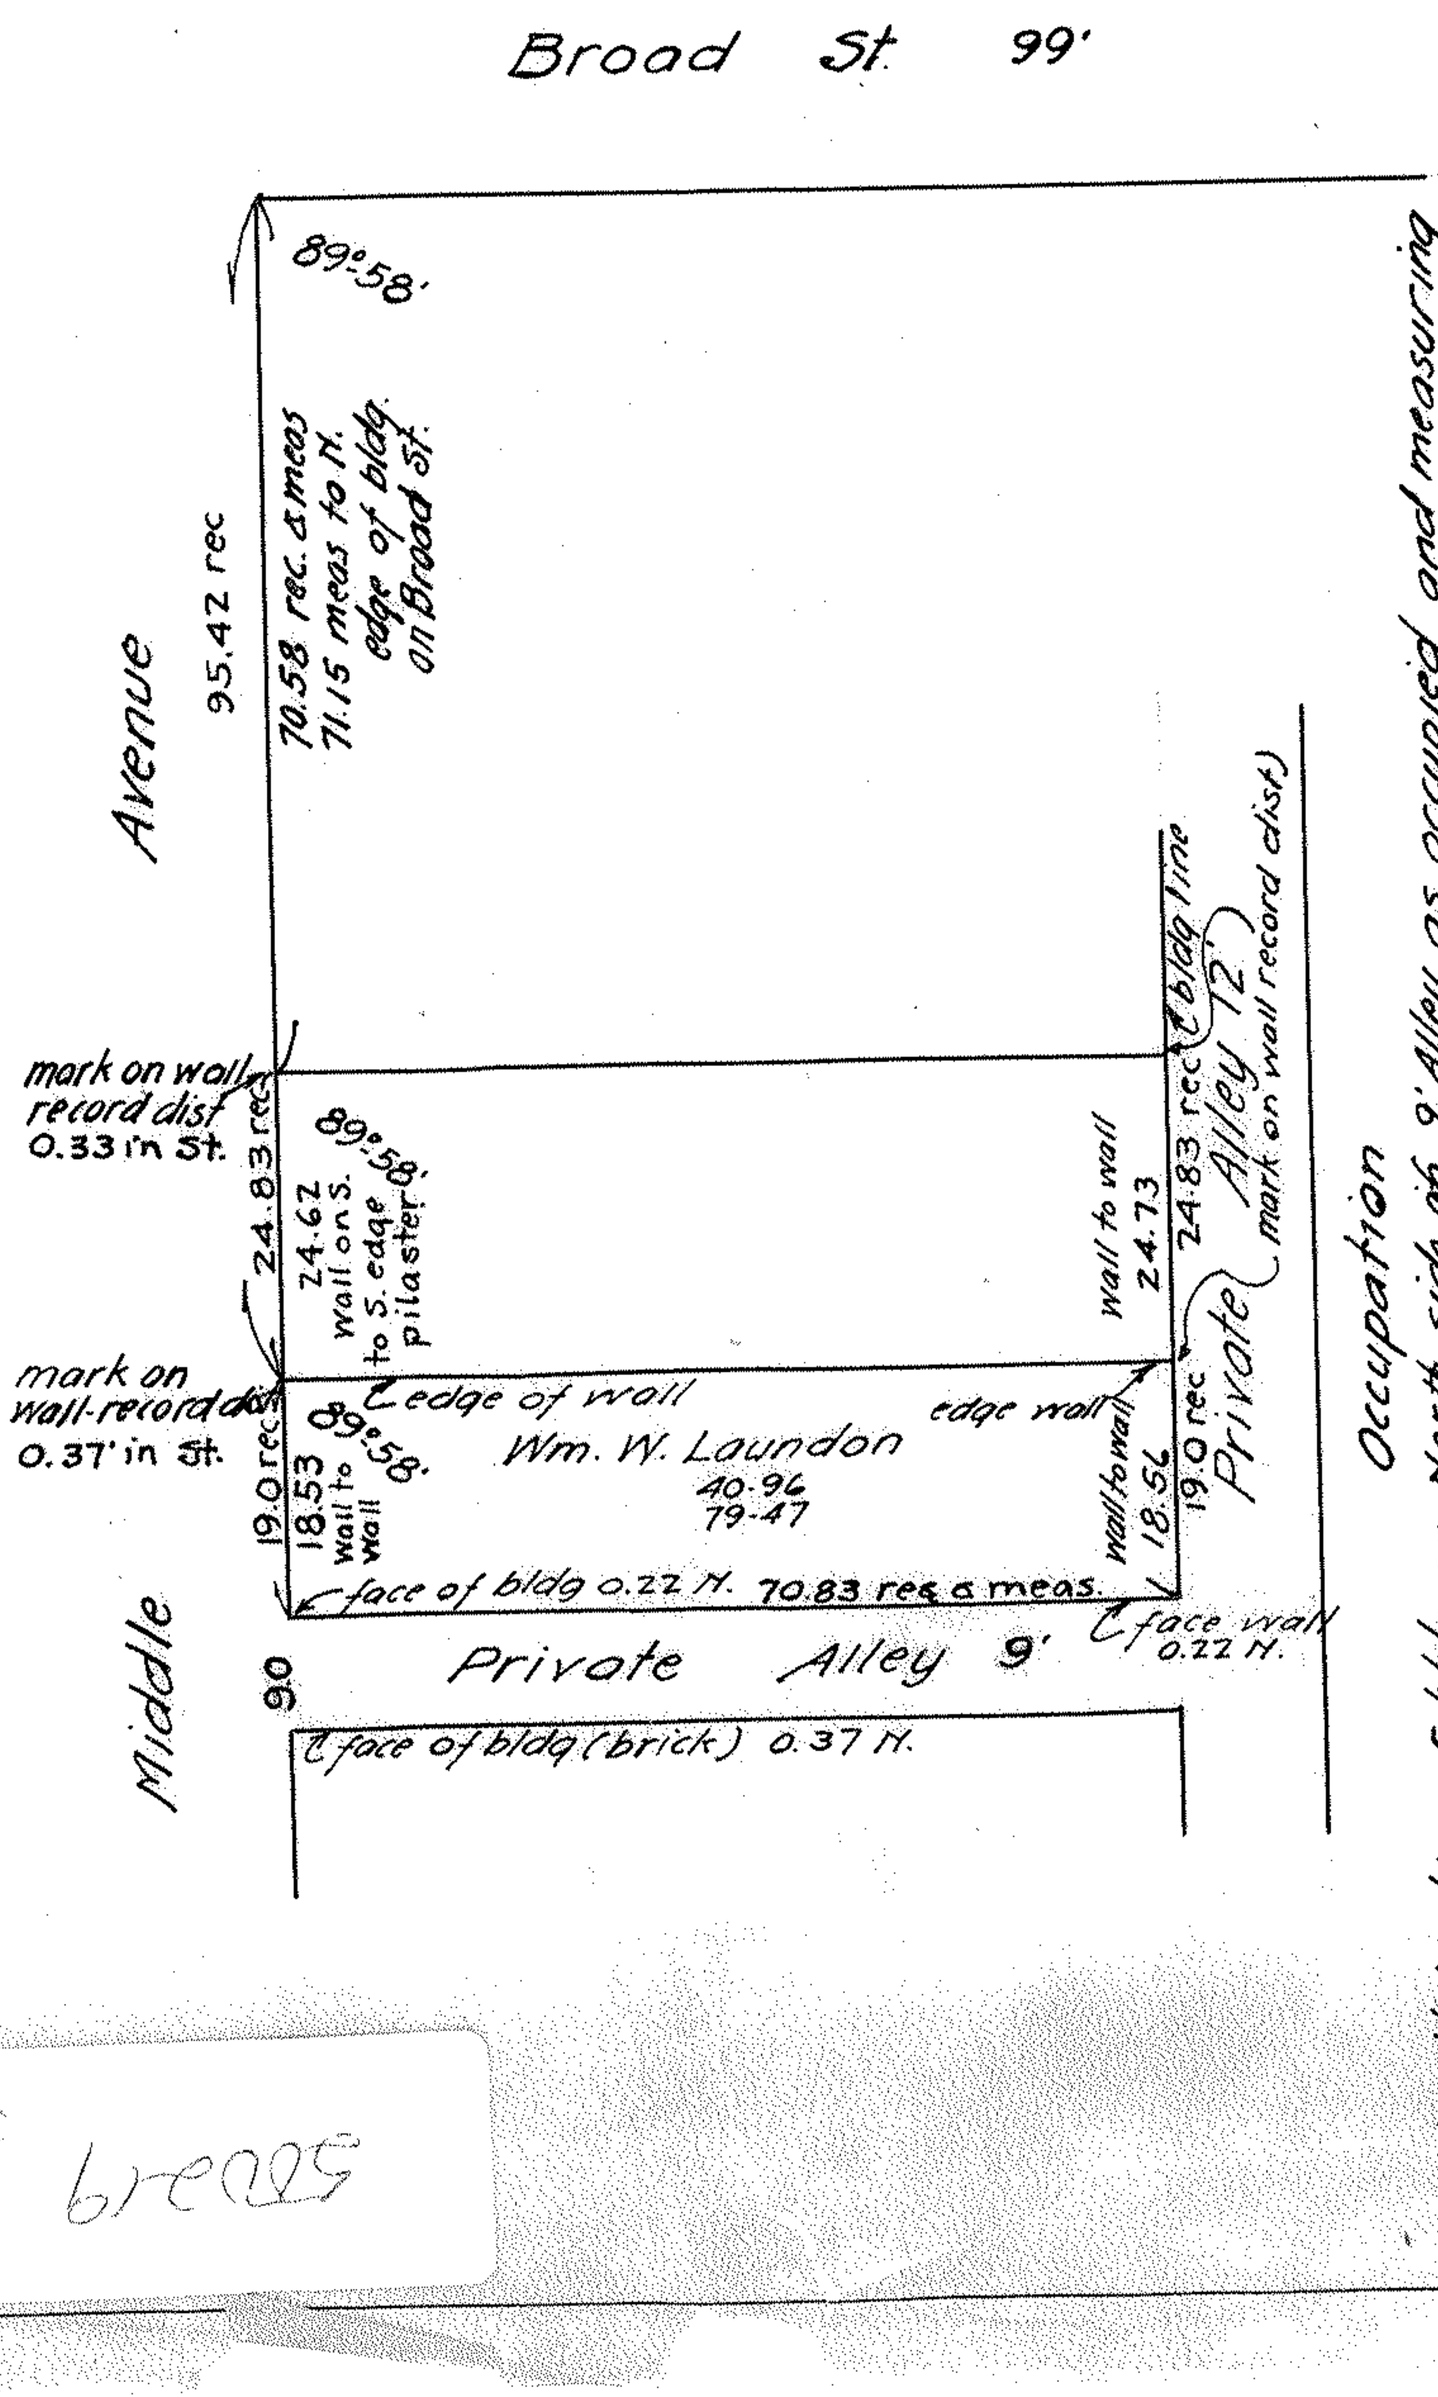

℄ brecks