MUNICIPAL ENGINEERING SUBDIVISIONS CITY AND FARM SURVEYS

J. W. WARDEN & ASSOCIATES

CIVIL ENGINEERS AND SURVEYORS

STATE OF OHIO

REGISTERED { PROFESSIONAL ENG. / SURVEYOR

D. D. ANDRUS, PRESIDENT

405 ELYRIA BLOCK

ELYRIA, OHIO

TELEPHONES 3211
42871

M. W. JACKSON
SECRETARY

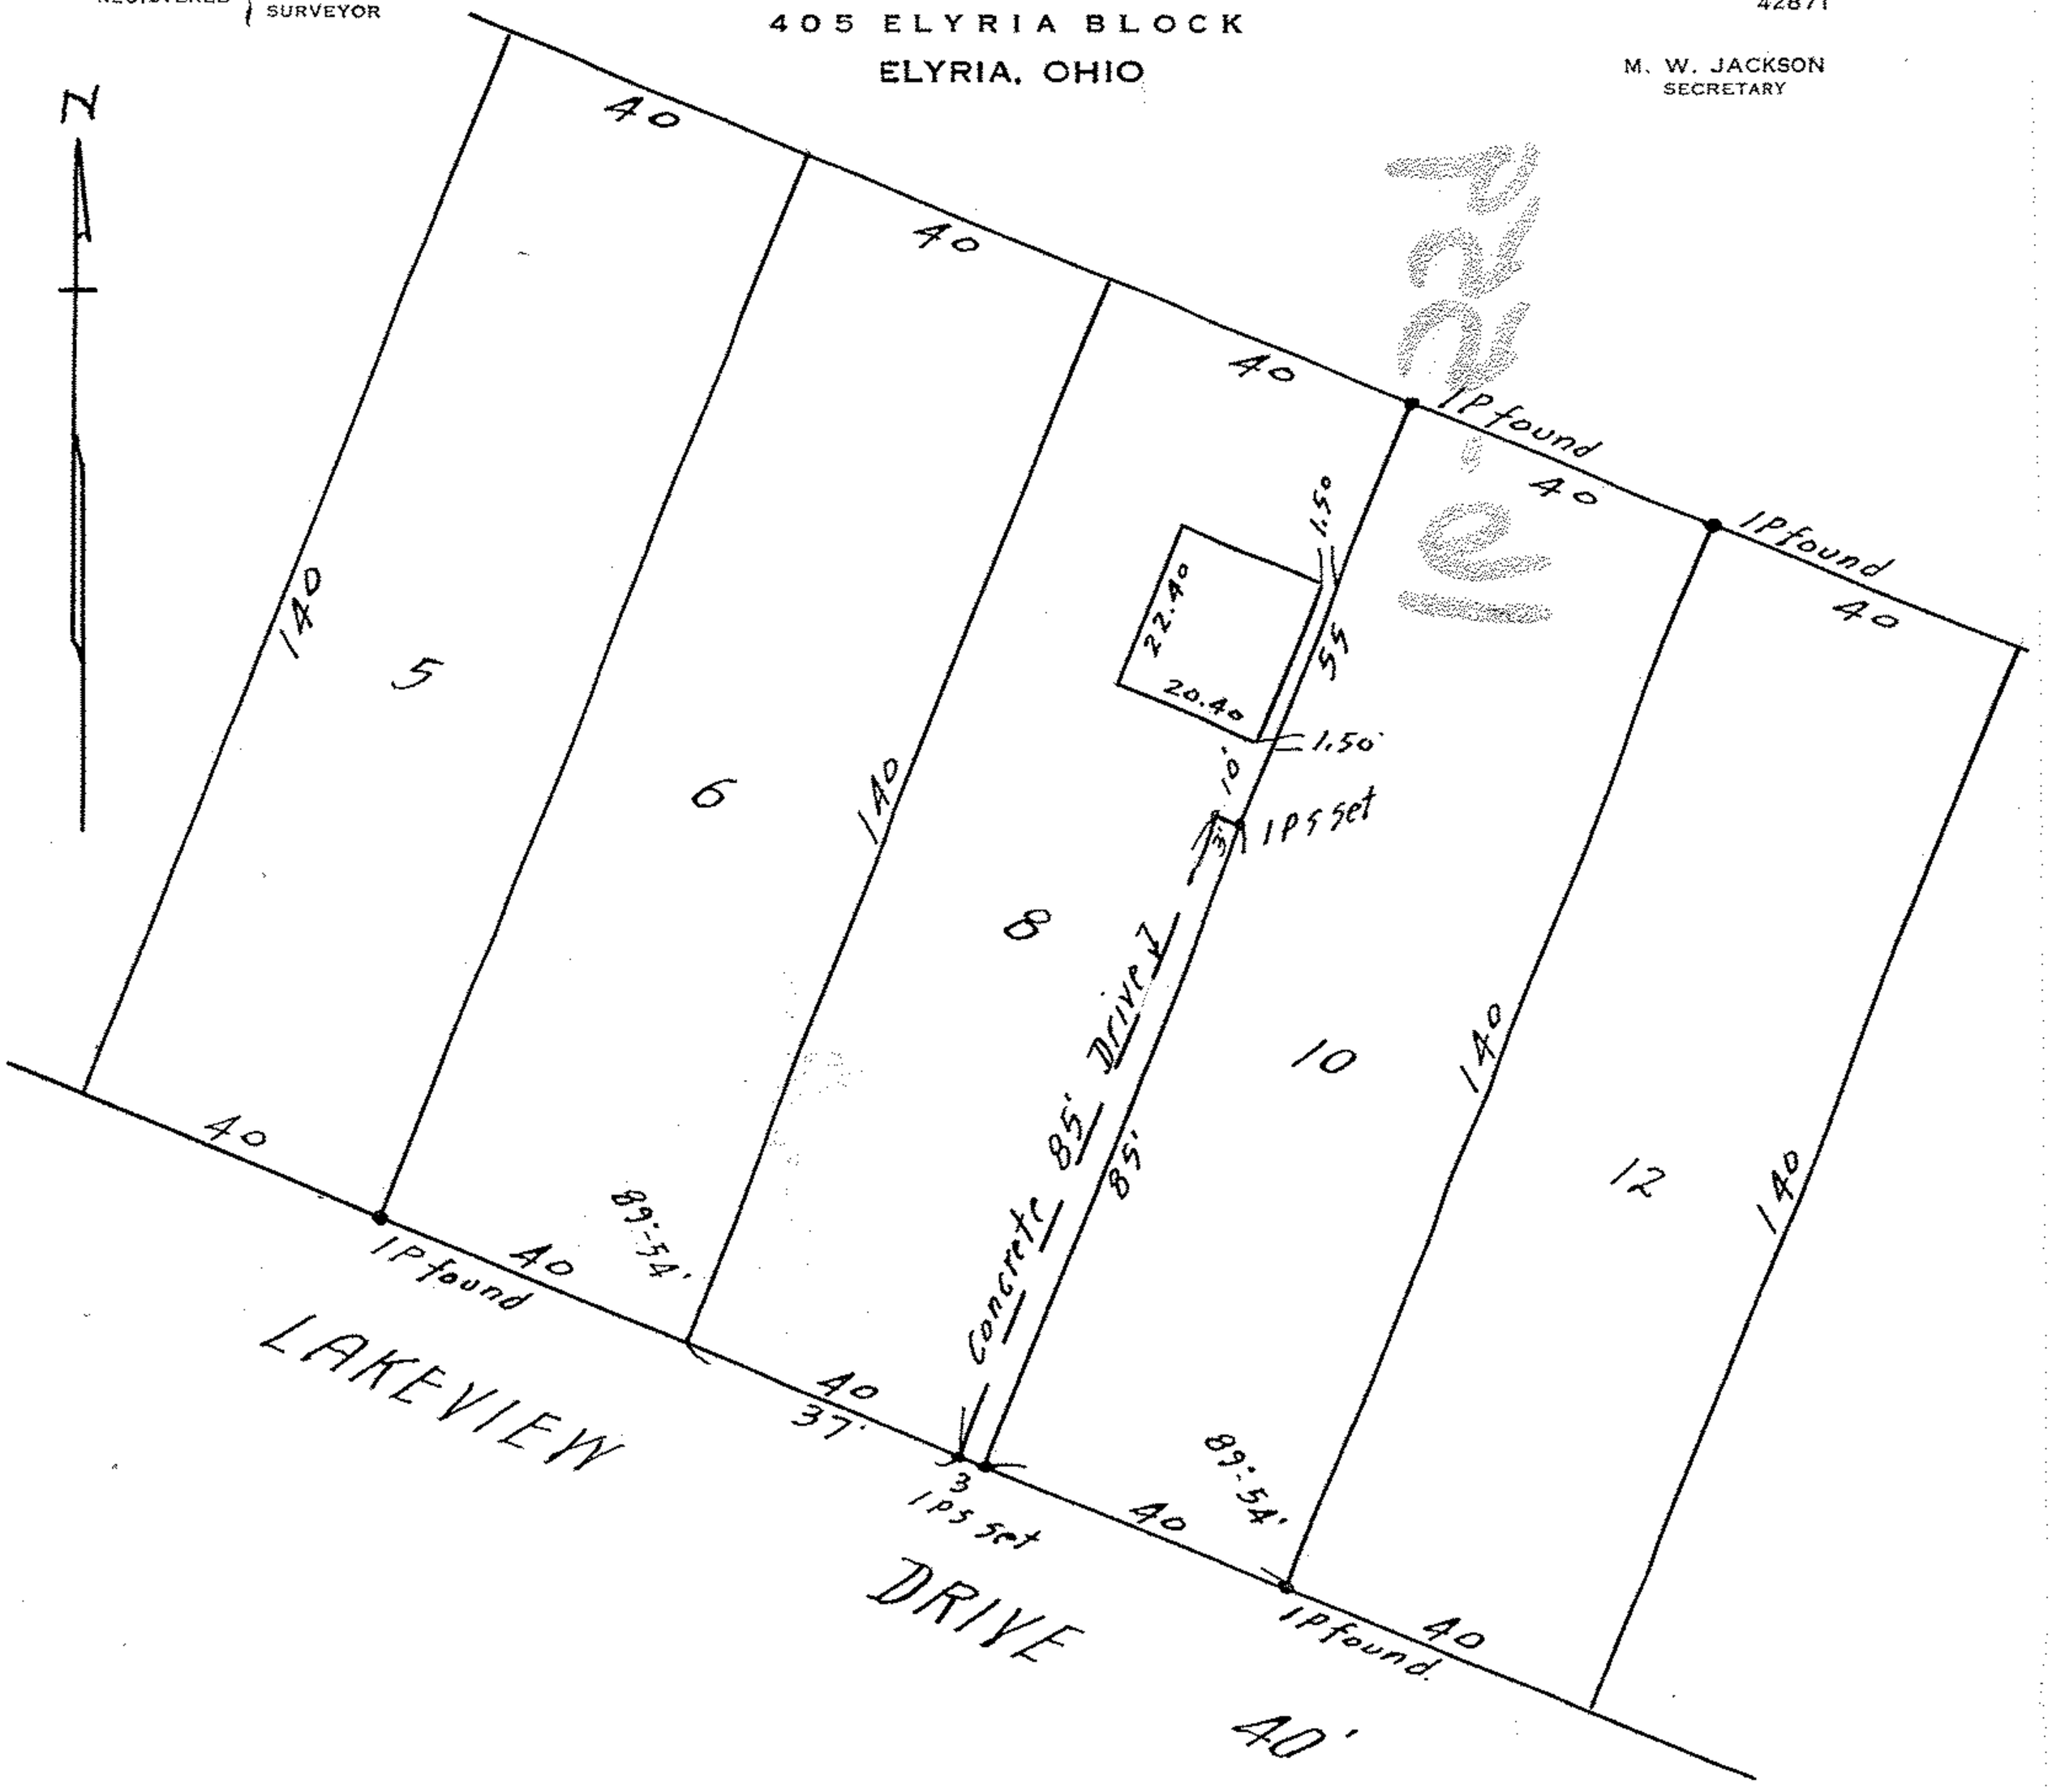

SURVEY FOR
HARRY C. & EVANGELINE M. McNAMARA
D-VOL. 397 PG. 507 AUG. 23, 1946
BLOCK 1 LOTS 6-8-10 AVON-DOVER BEACH SUBN.
MAP VOL. 11 PG. 27
SECTION 30 AVON LAKE VILLAGE
LORAIN COUNTY, OHIO
SCALE 1" = 30' JUNE 22, 1953

16-0559