


Survey for
 HYGRADE FOOD PRODUCTS CO.,
 Lot 76, Sheffield Twp.,
 Lorain Co., Ohio.
 Deed Vol-335- Page 292-June 20, 1944,
 August 25-1944. Scale 1"=100'.
 J.W.Warden. Registered Surveyor

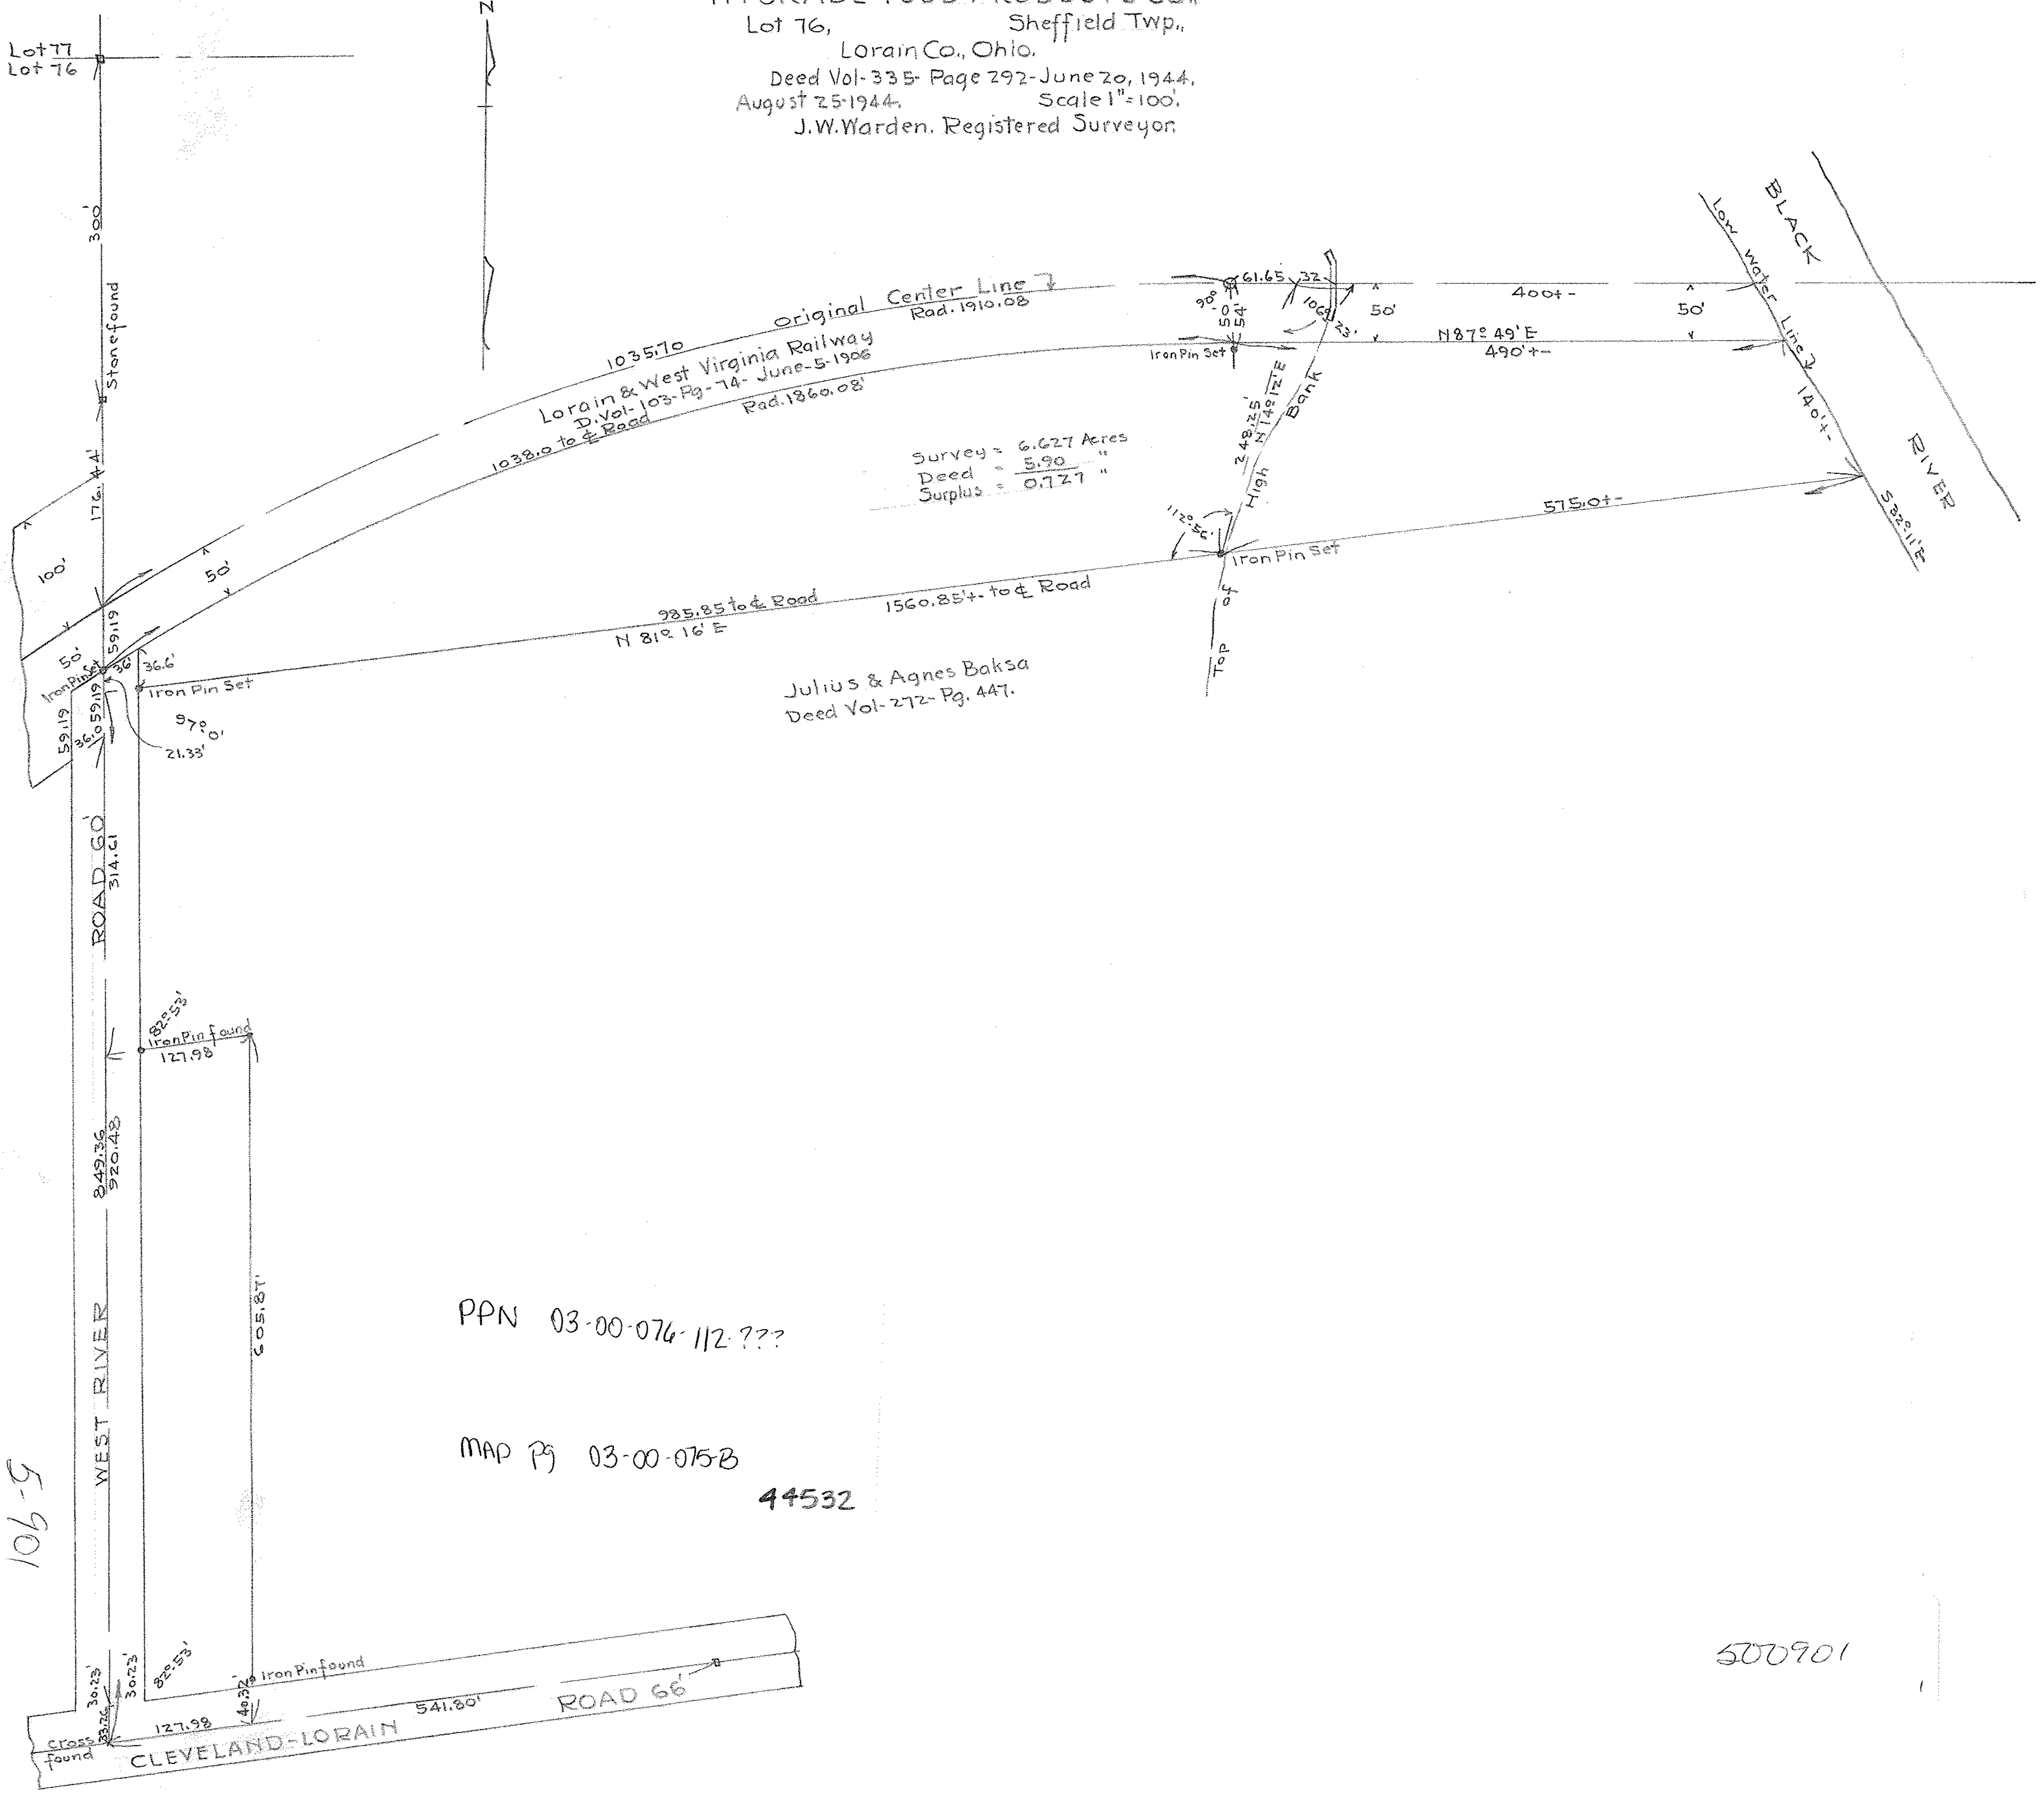

Survey = 6.627 Acres
 Deed = 5.90 "
 Surplus = 0.727 "

Julius & Agnes Baksa
 Deed Vol-272- Pg. 447.

PPN 03-00-076-112-???

MAP Pg 03-00-075-B

44532

5-901

500901