PPN 12-00-069-000-003

MAP Pg 12-F 44534

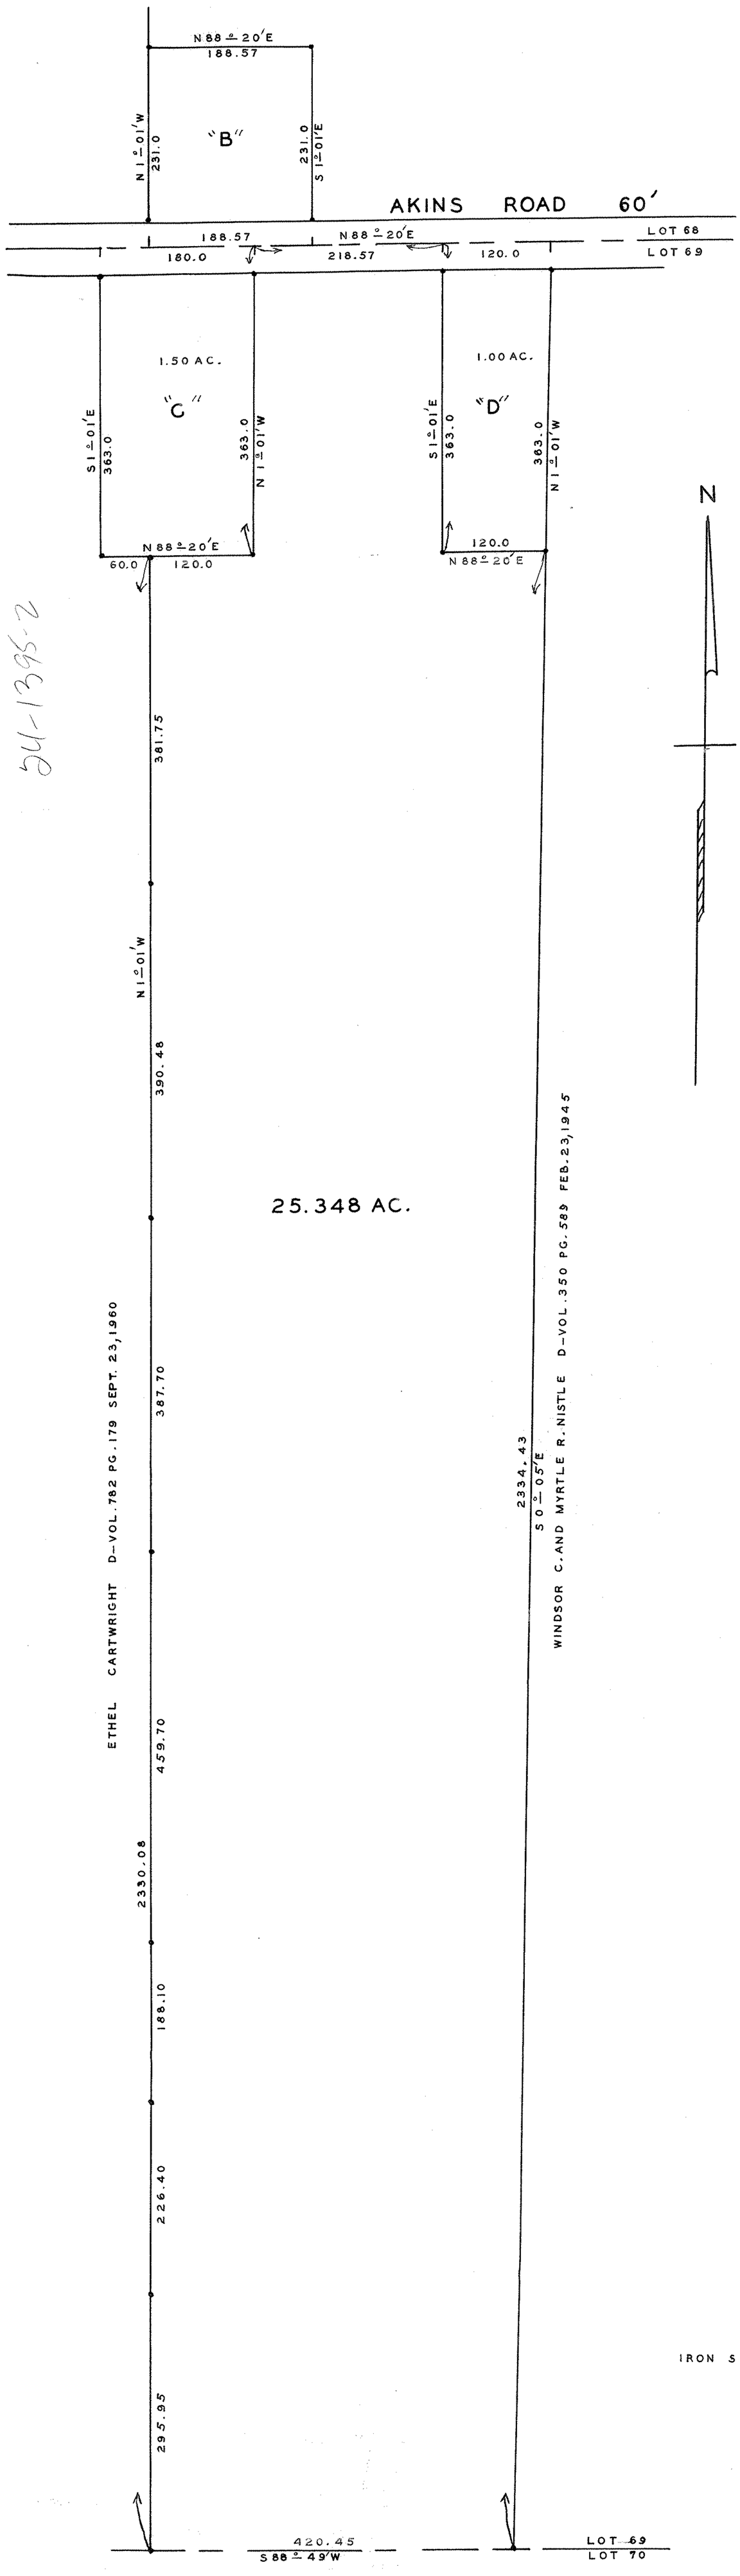

SCALE 1"=100'

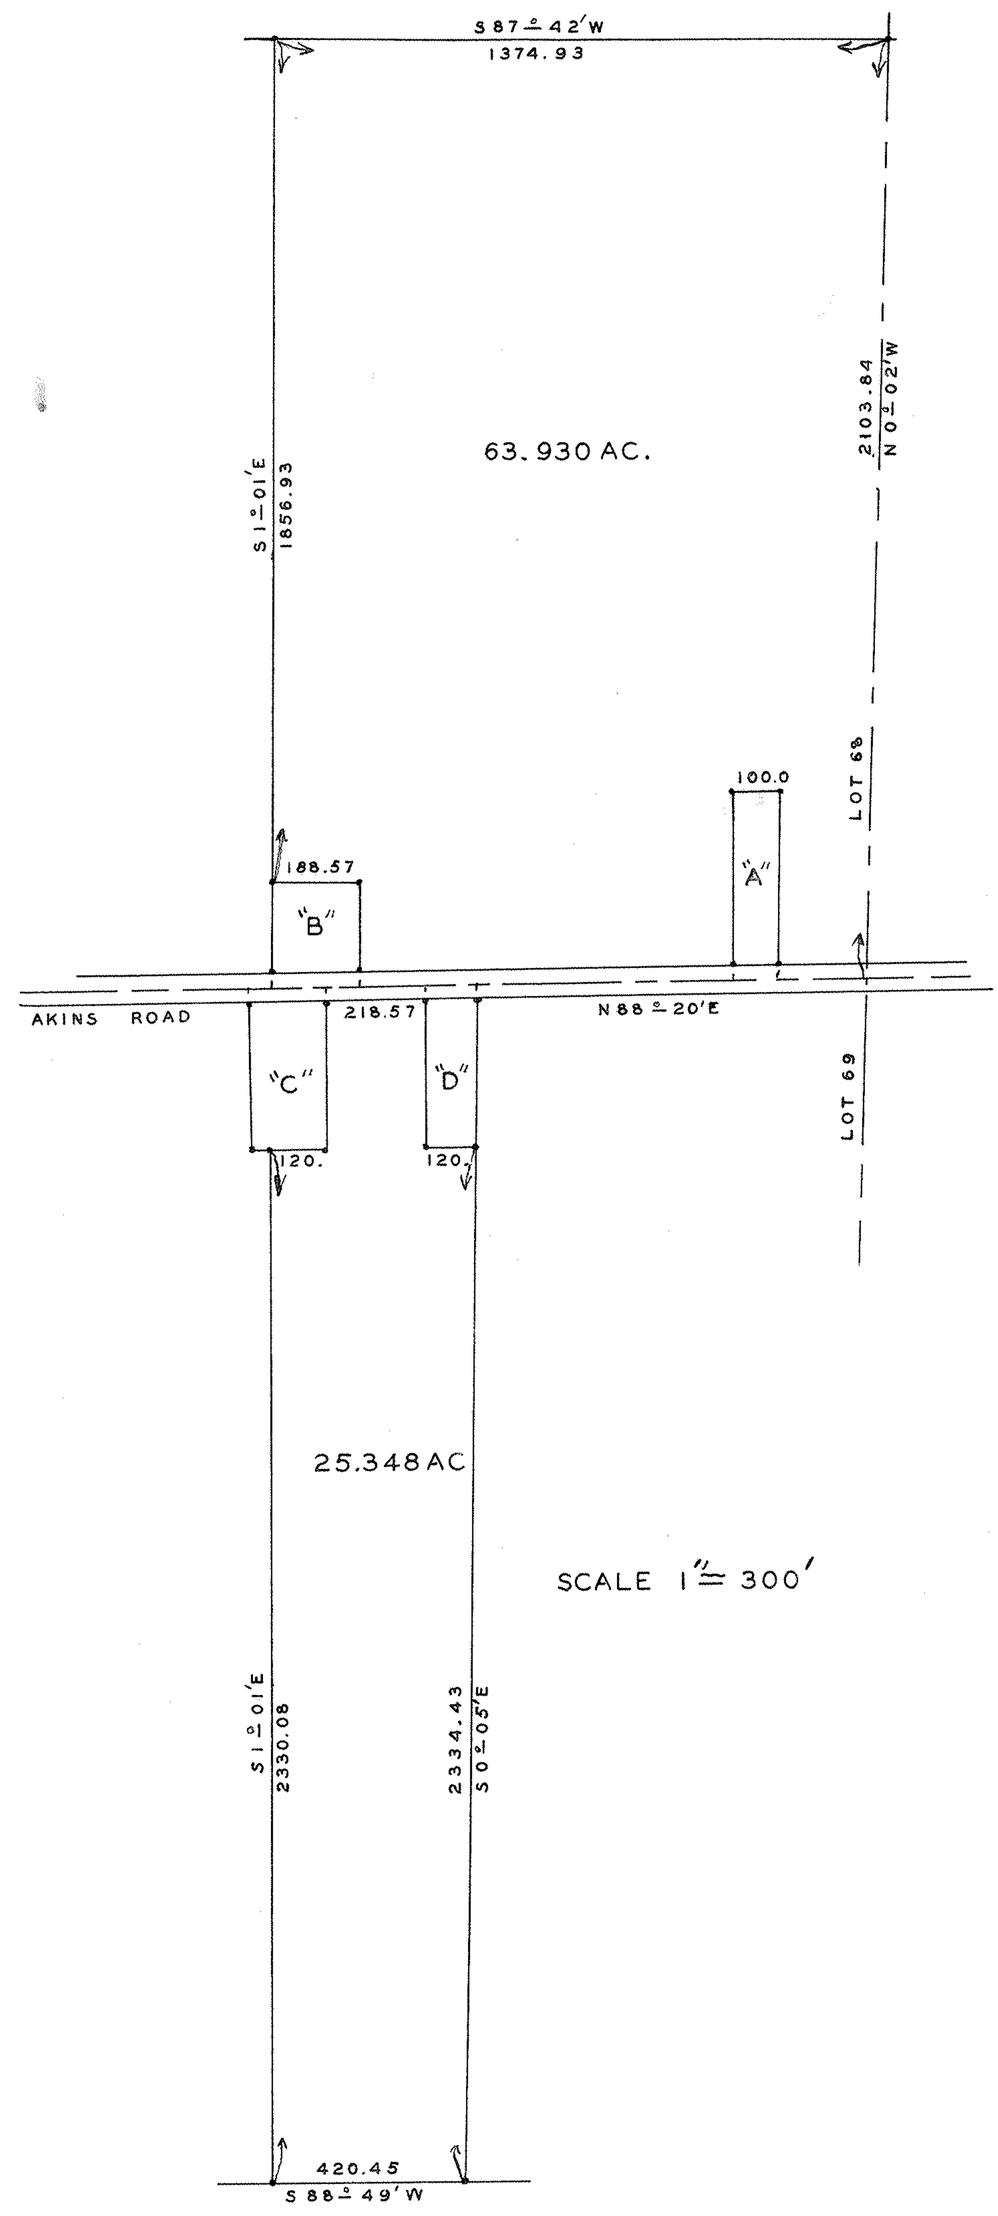

SCALE 1"=300'

"A" LAWRENCE C. AND ELIZABETH K. PETERSEN
D-VOL.808 PG.411 OCT.25, 1961

"B" HAROLD H. AND GERTRUDE M. CARTWRIGHT
D-VOL.189 PG.144 JUNE 20, 1922

"C" HAROLD H. AND GERTRUDE M. CARTWRIGHT
D-VOL.530 PG.111 NOV 3, 1951

"D" THELMA E. DRISCOLL
D-VOL.475 PG.320 OCT. 28, 1942

IRON STAKES SET INDICATED THUS ●

STATE OF OHIO
D.D. Hibbs
328
REGISTERED
SURVEYOR