

0001-17

George & Irene Mekker
D-Vol. 322-Pg. 245 June 23 1942

Edith E & Dorothy Ives
D-Vol. 277-Pg. 492 May 4, 1936.

George & Irene Mekker

Thomas & Velva Michalis

Lot 94
Lot 95

Lot 87
Lot 86

Frank Kovarik

Maurice Mc Nutt

Frank Kovarik

22.391 Ac

John J & Katherine Sabal
D-Vol. 328 Pg. 496 July 16, 1943.

James D. Eryin

Earl W. Ashley

Chas. Zelanka

Rose I. Harris
691-222 3-22-57

Walter W. Armstrong

Ronald R. Reisinger

Edw. H. Davis


John Haupt

Glen Rindfleisch

Waymon E. Pugh

Rex Fritz

Zoli J. & Elsie L. Balogh
441-261 June 14 1948
2.847 Ac
433-121 Feb. 18 1948

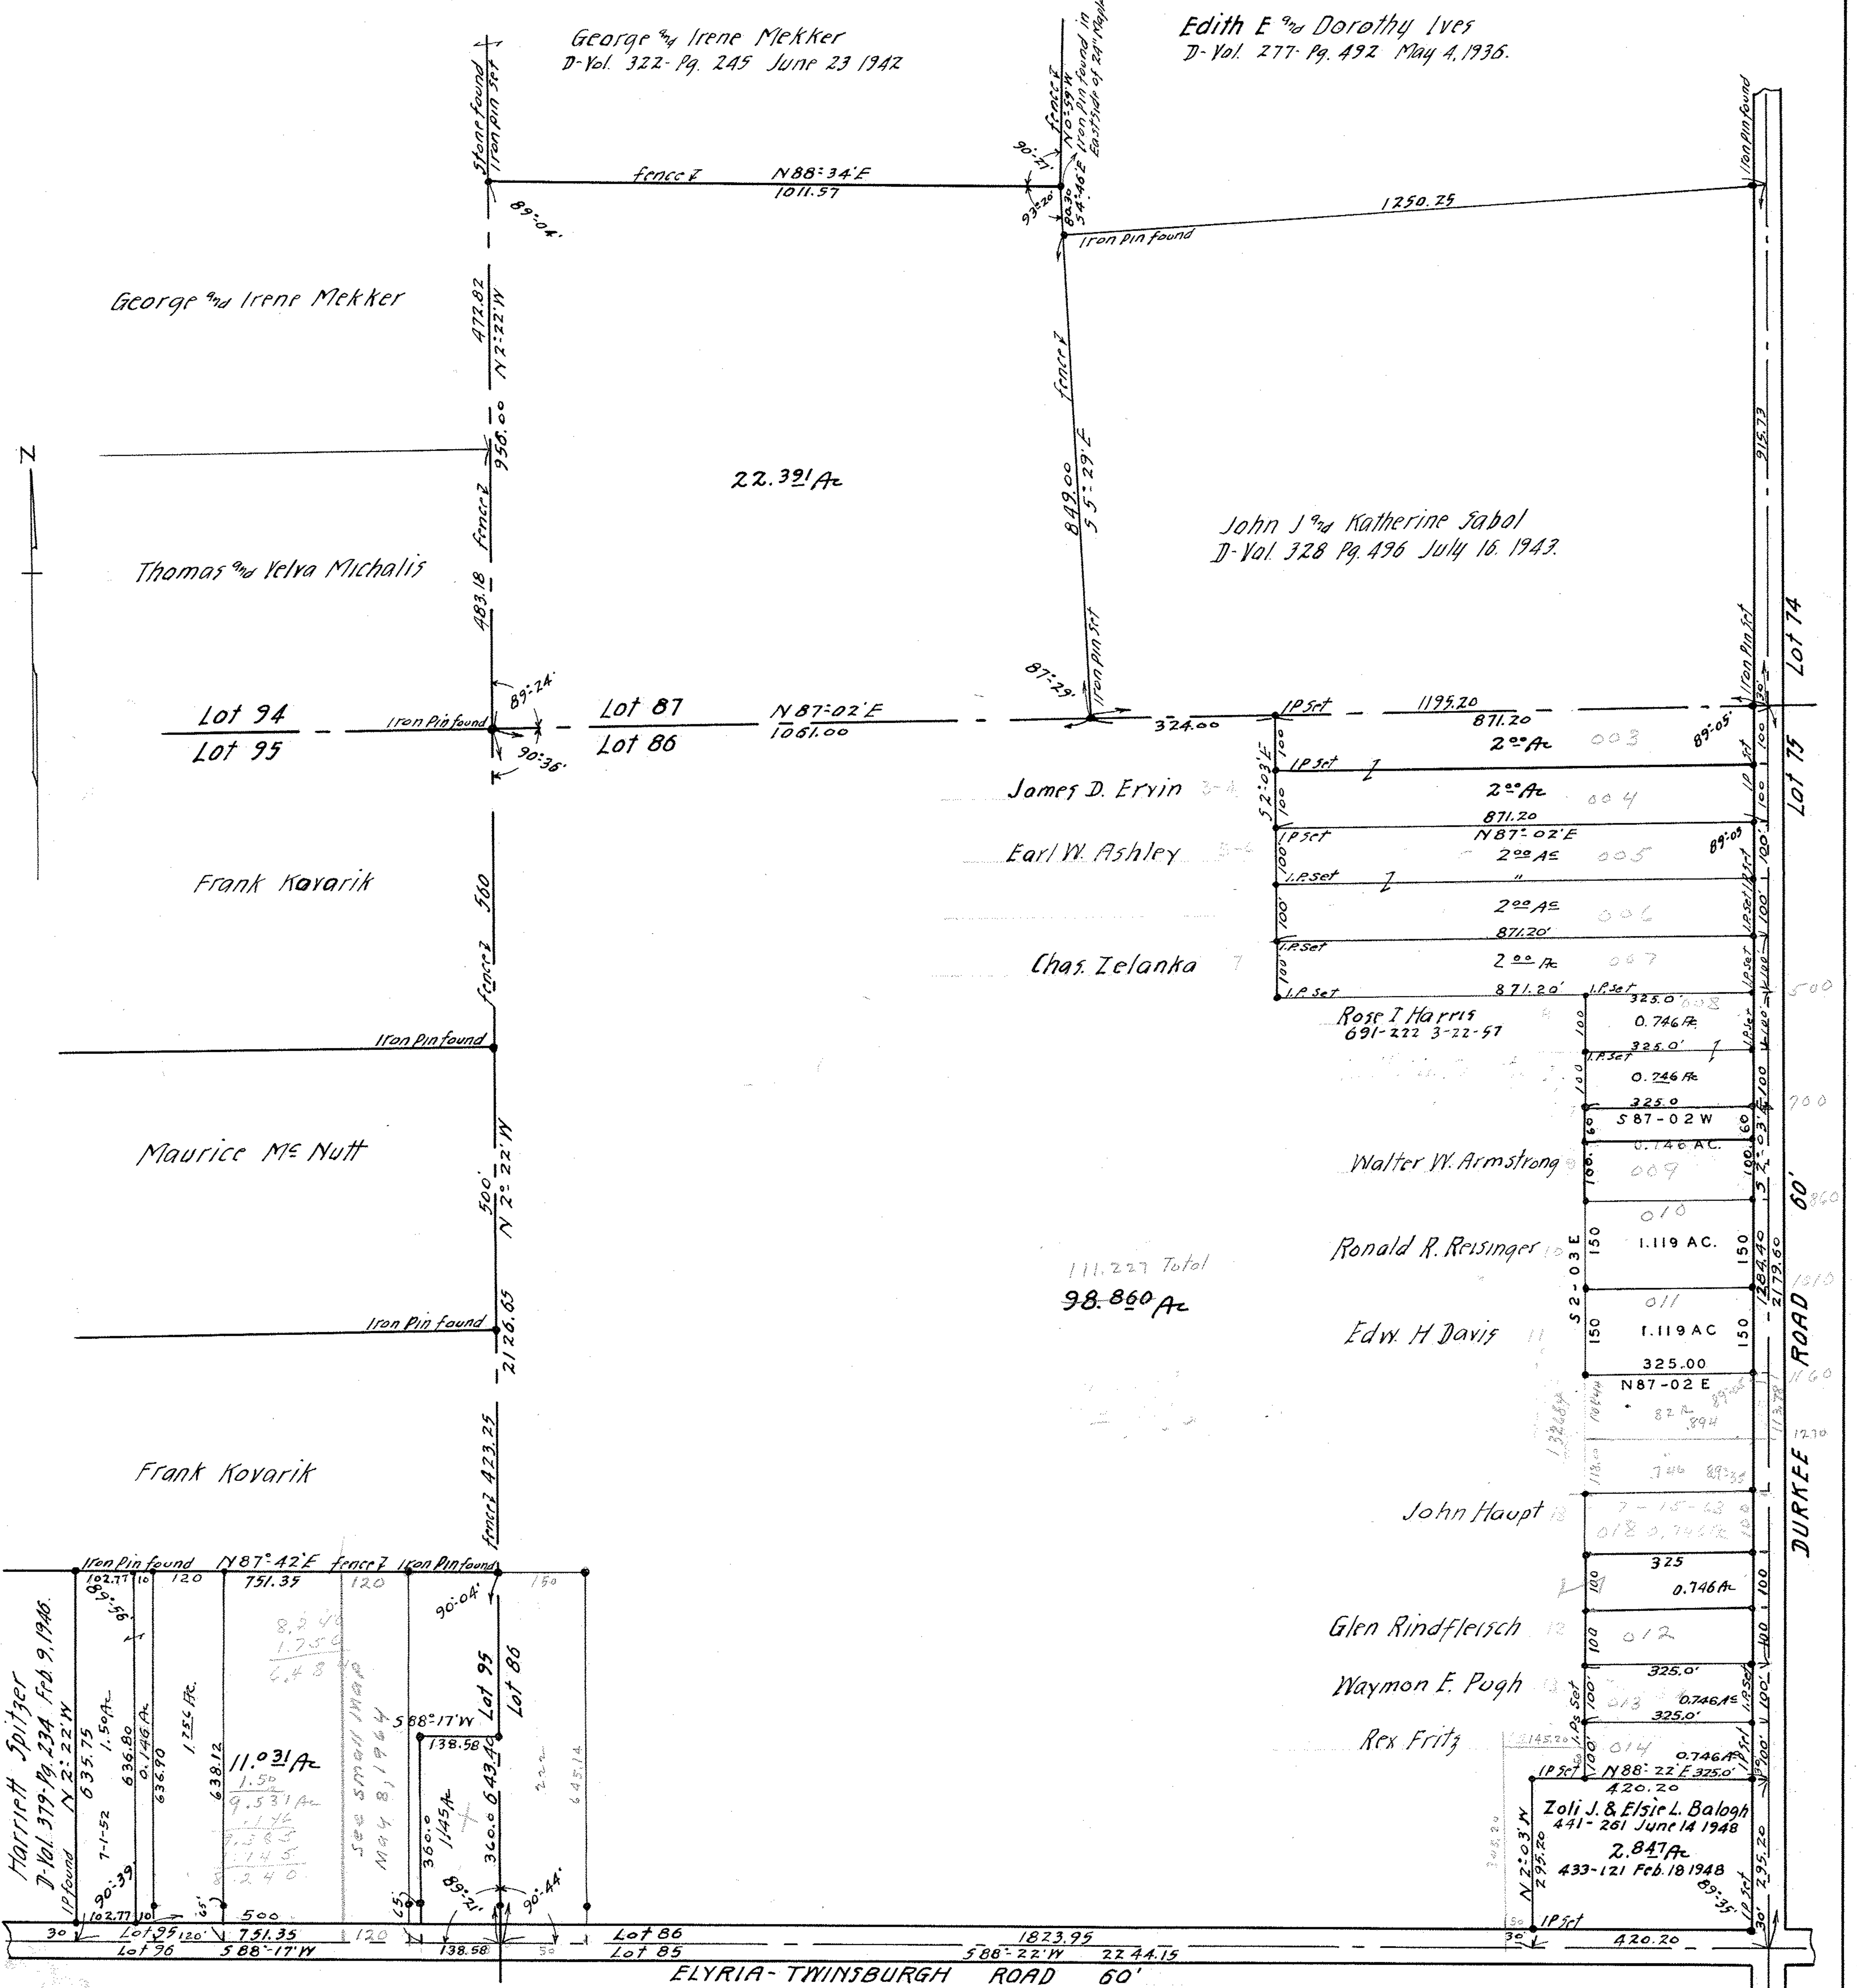

Survey for
STEPHEN M. & ANNA BALOGH
 D-Vol. 381-Pg. 11 - Jan. 30, 1946.
 Lot 86-87 Eaton Township
 Lorain County, Ohio.
 Scale - 1" = 200' April 30, 1948.
 J.W. Warden, Registered Surveyor.
 Revised Oct. 7, 1948.

PPN 11-00-086-000-???

MAP Pg. 11-00-086-B

44535