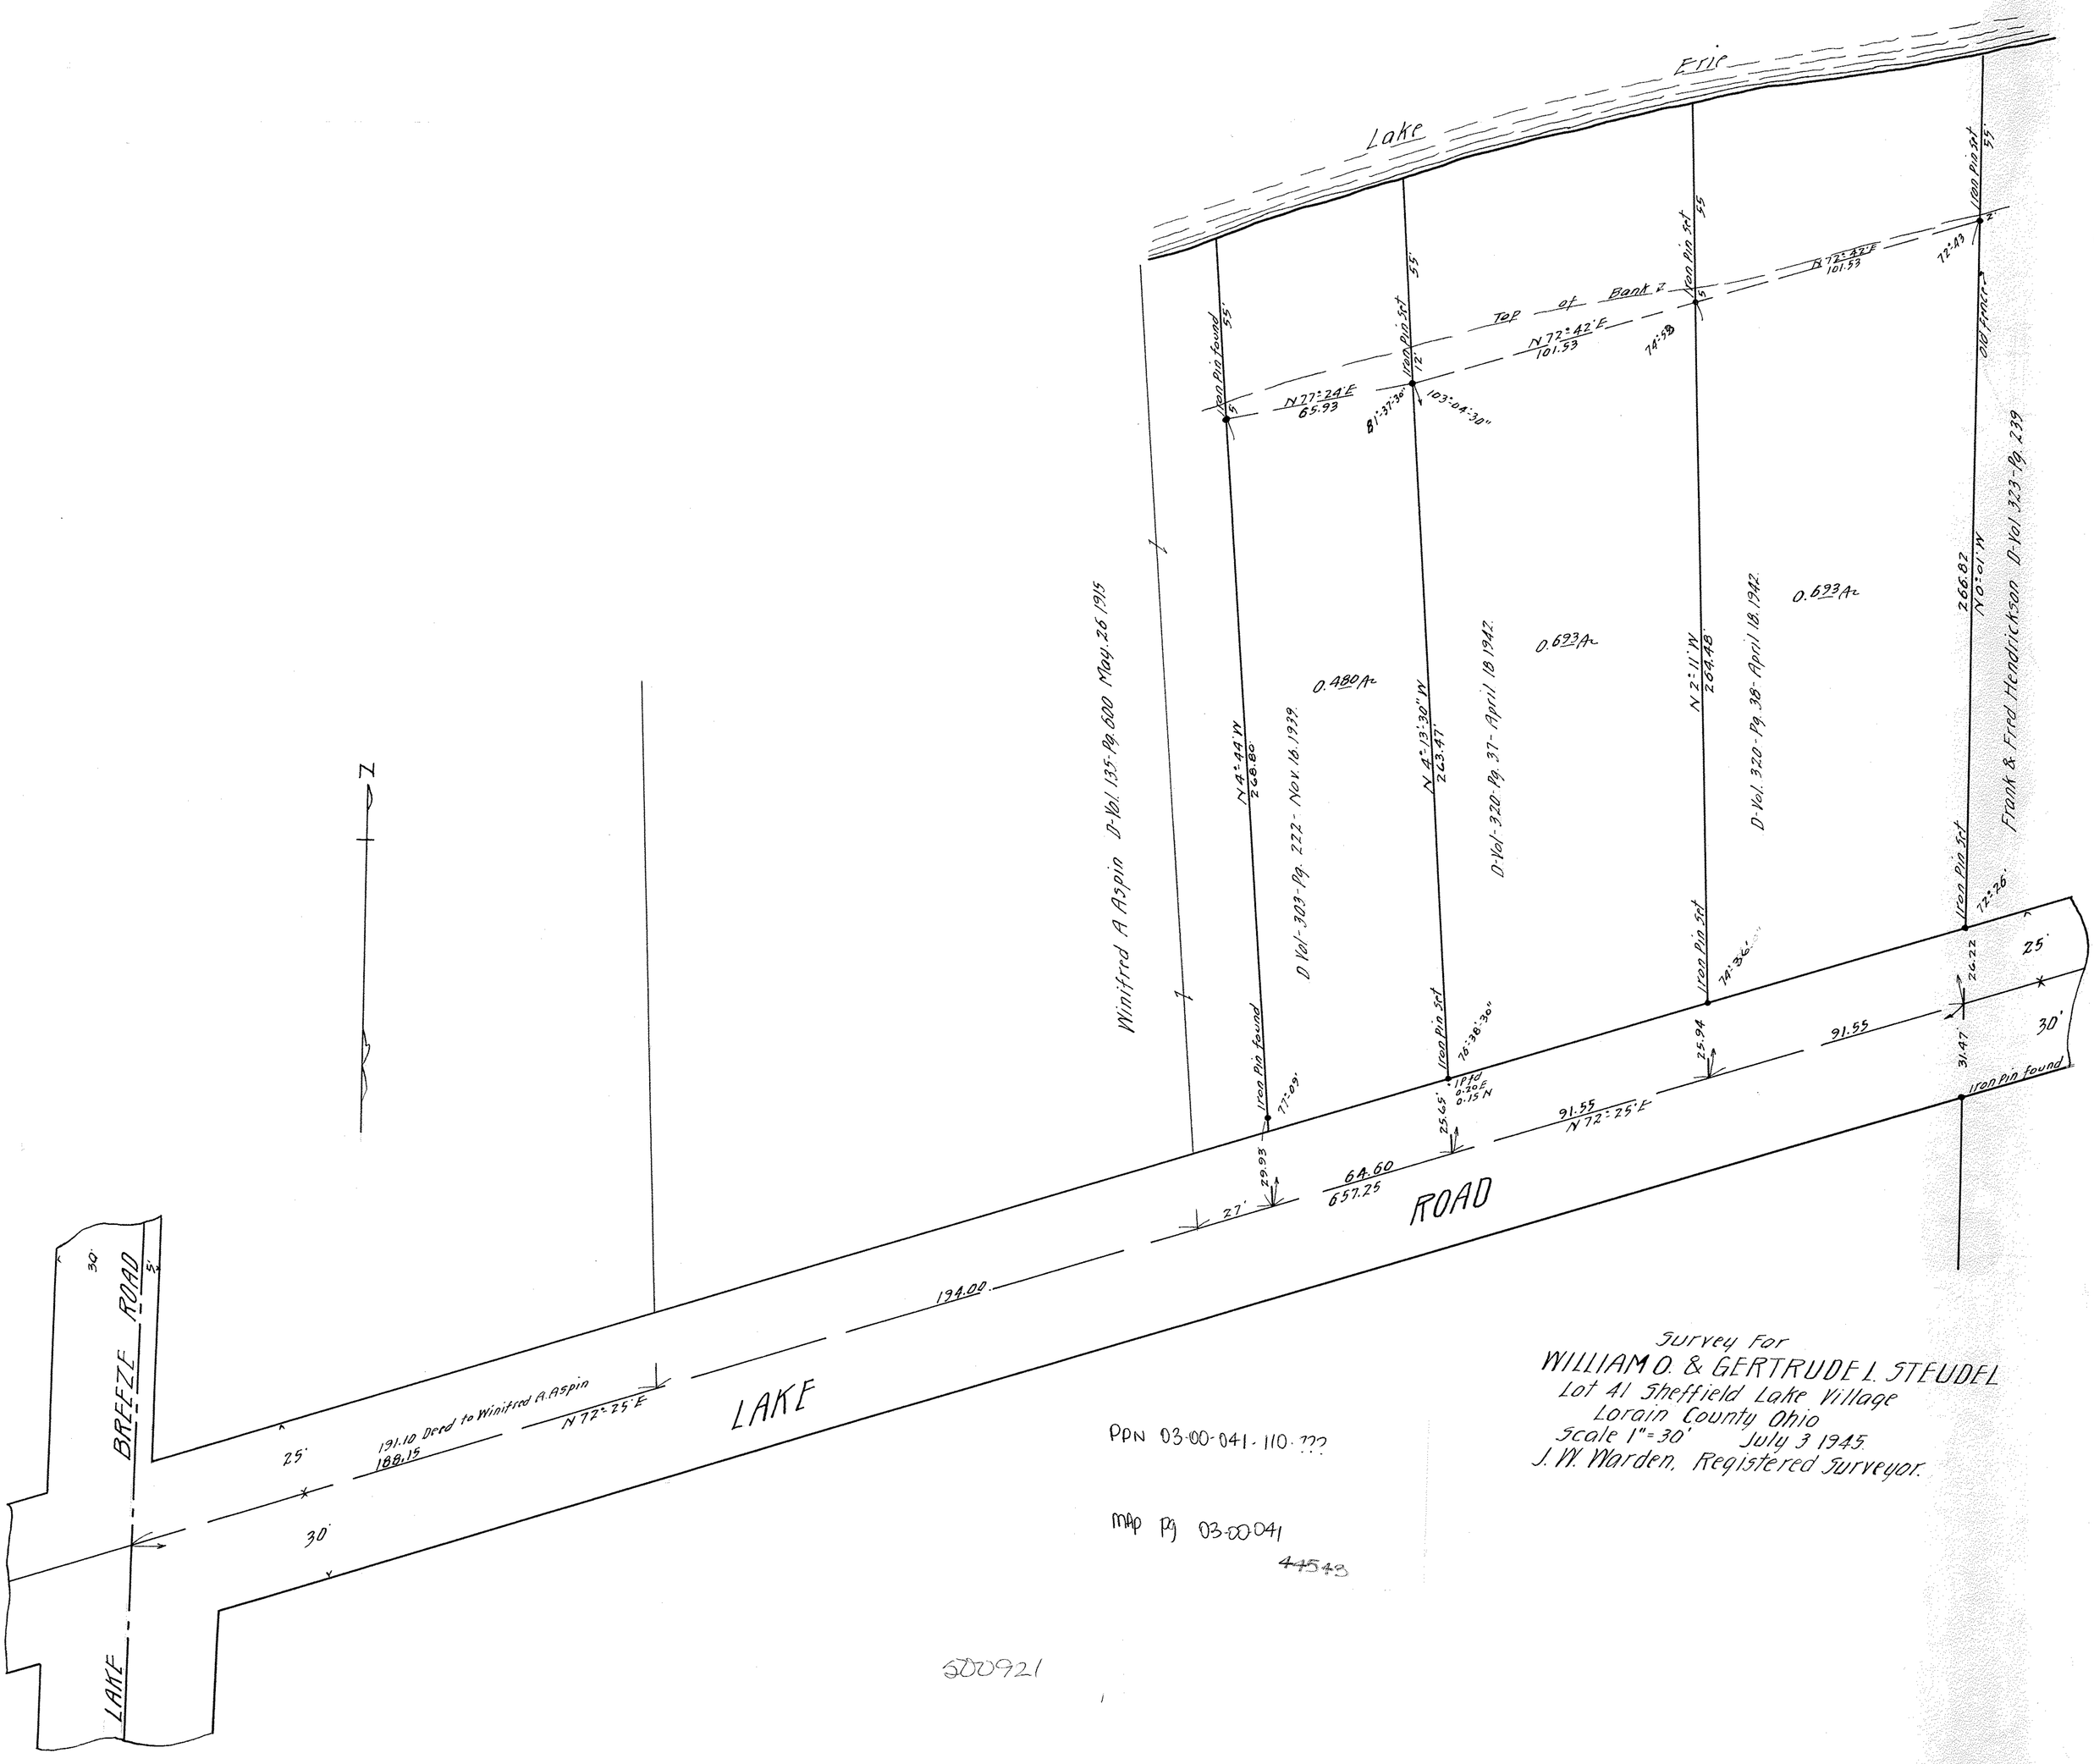

Survey For
WILLIAM O. & GERTRUDE I. STEUDEL
Lot 41 Sheffield Lake Village
Lorain County Ohio
Scale 1" = 30' July 3 1945.
J. W. Warden, Registered Surveyor.

PPN 03-00-041-110-???

MAP Pg 03-00-041

~~44543~~

600921

158-2