PPN 06-25-166.000-???

MAP 6-50 ~~45~~49

2-1801-1-78

Level and Location Map

ARTHUR SAARI

Lots 263-264 Spring Valley Subn., Pt. 3.

Twp. Original Lot 166 East of Black River.

Elyria Township - Lorain Co., Ohio.

Scale 1" = 10ft. May 31, 1949.
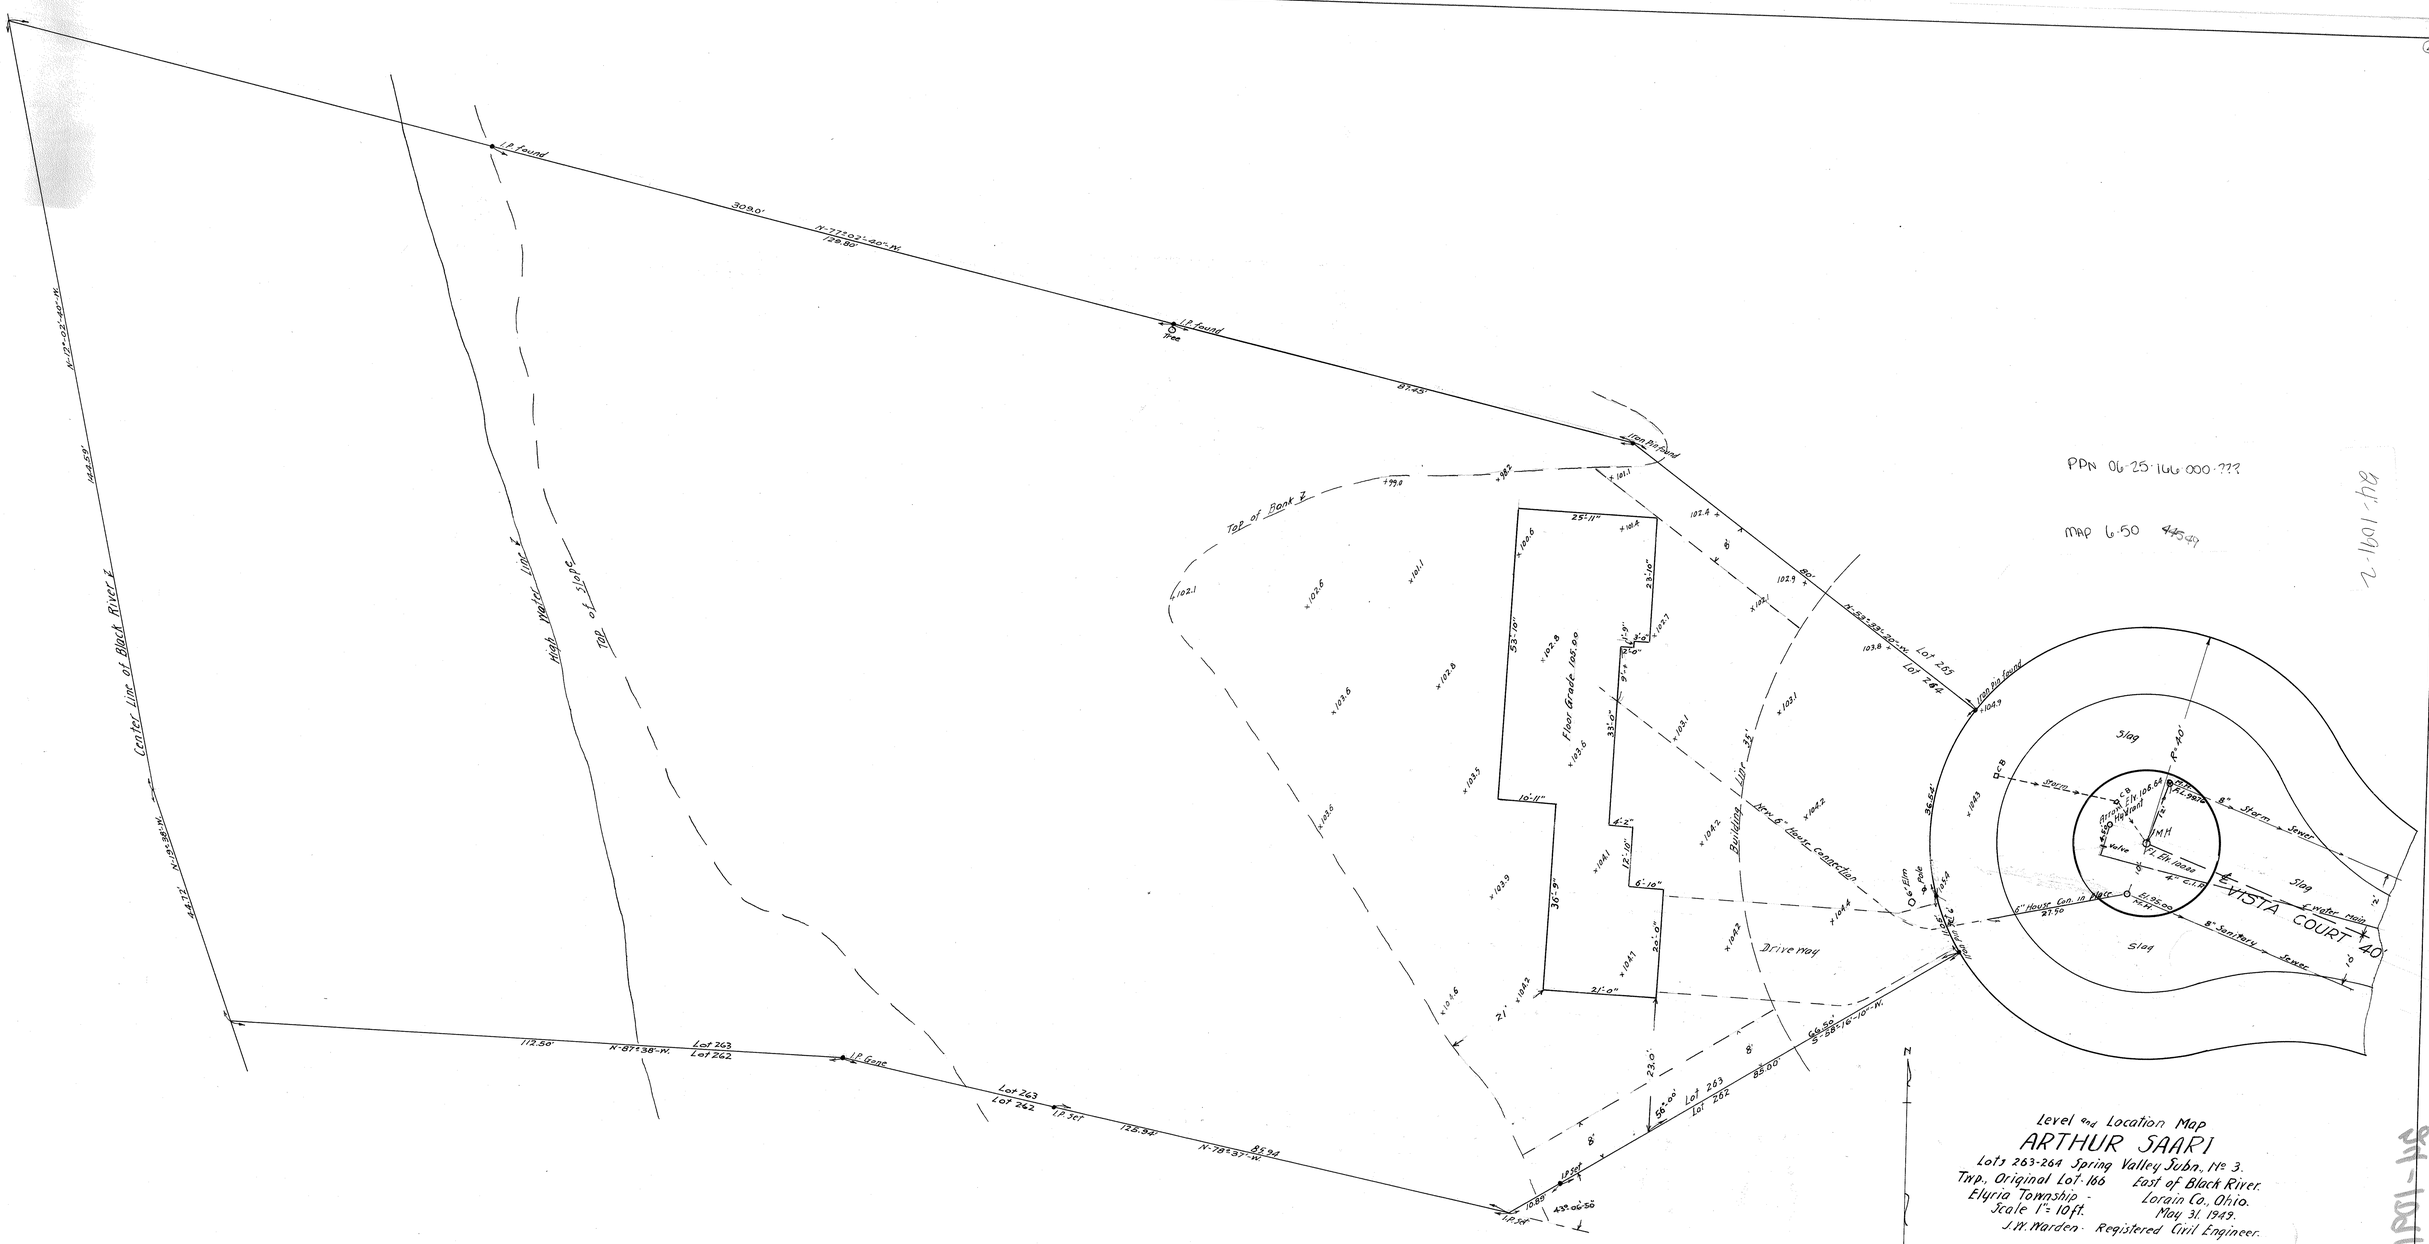
J.W. Warden - Registered Civil Engineer.