(A)

SURVEY FOR
J. R. SHARPNACK – ALBERT A. KISHMAN
AND
SYLVIA NEIDING
PART OF LOTS 1 & 27 BROWNHELM TOWNSHIP
LORAIN COUNTY OHIO
SCALE 1" = 100' SEPT. 24, 1957
J.W. WARDEN AND ASSOCIATES REG. SURVEYORS

PPN 01-00.001-000-???
01-00-027.000-???
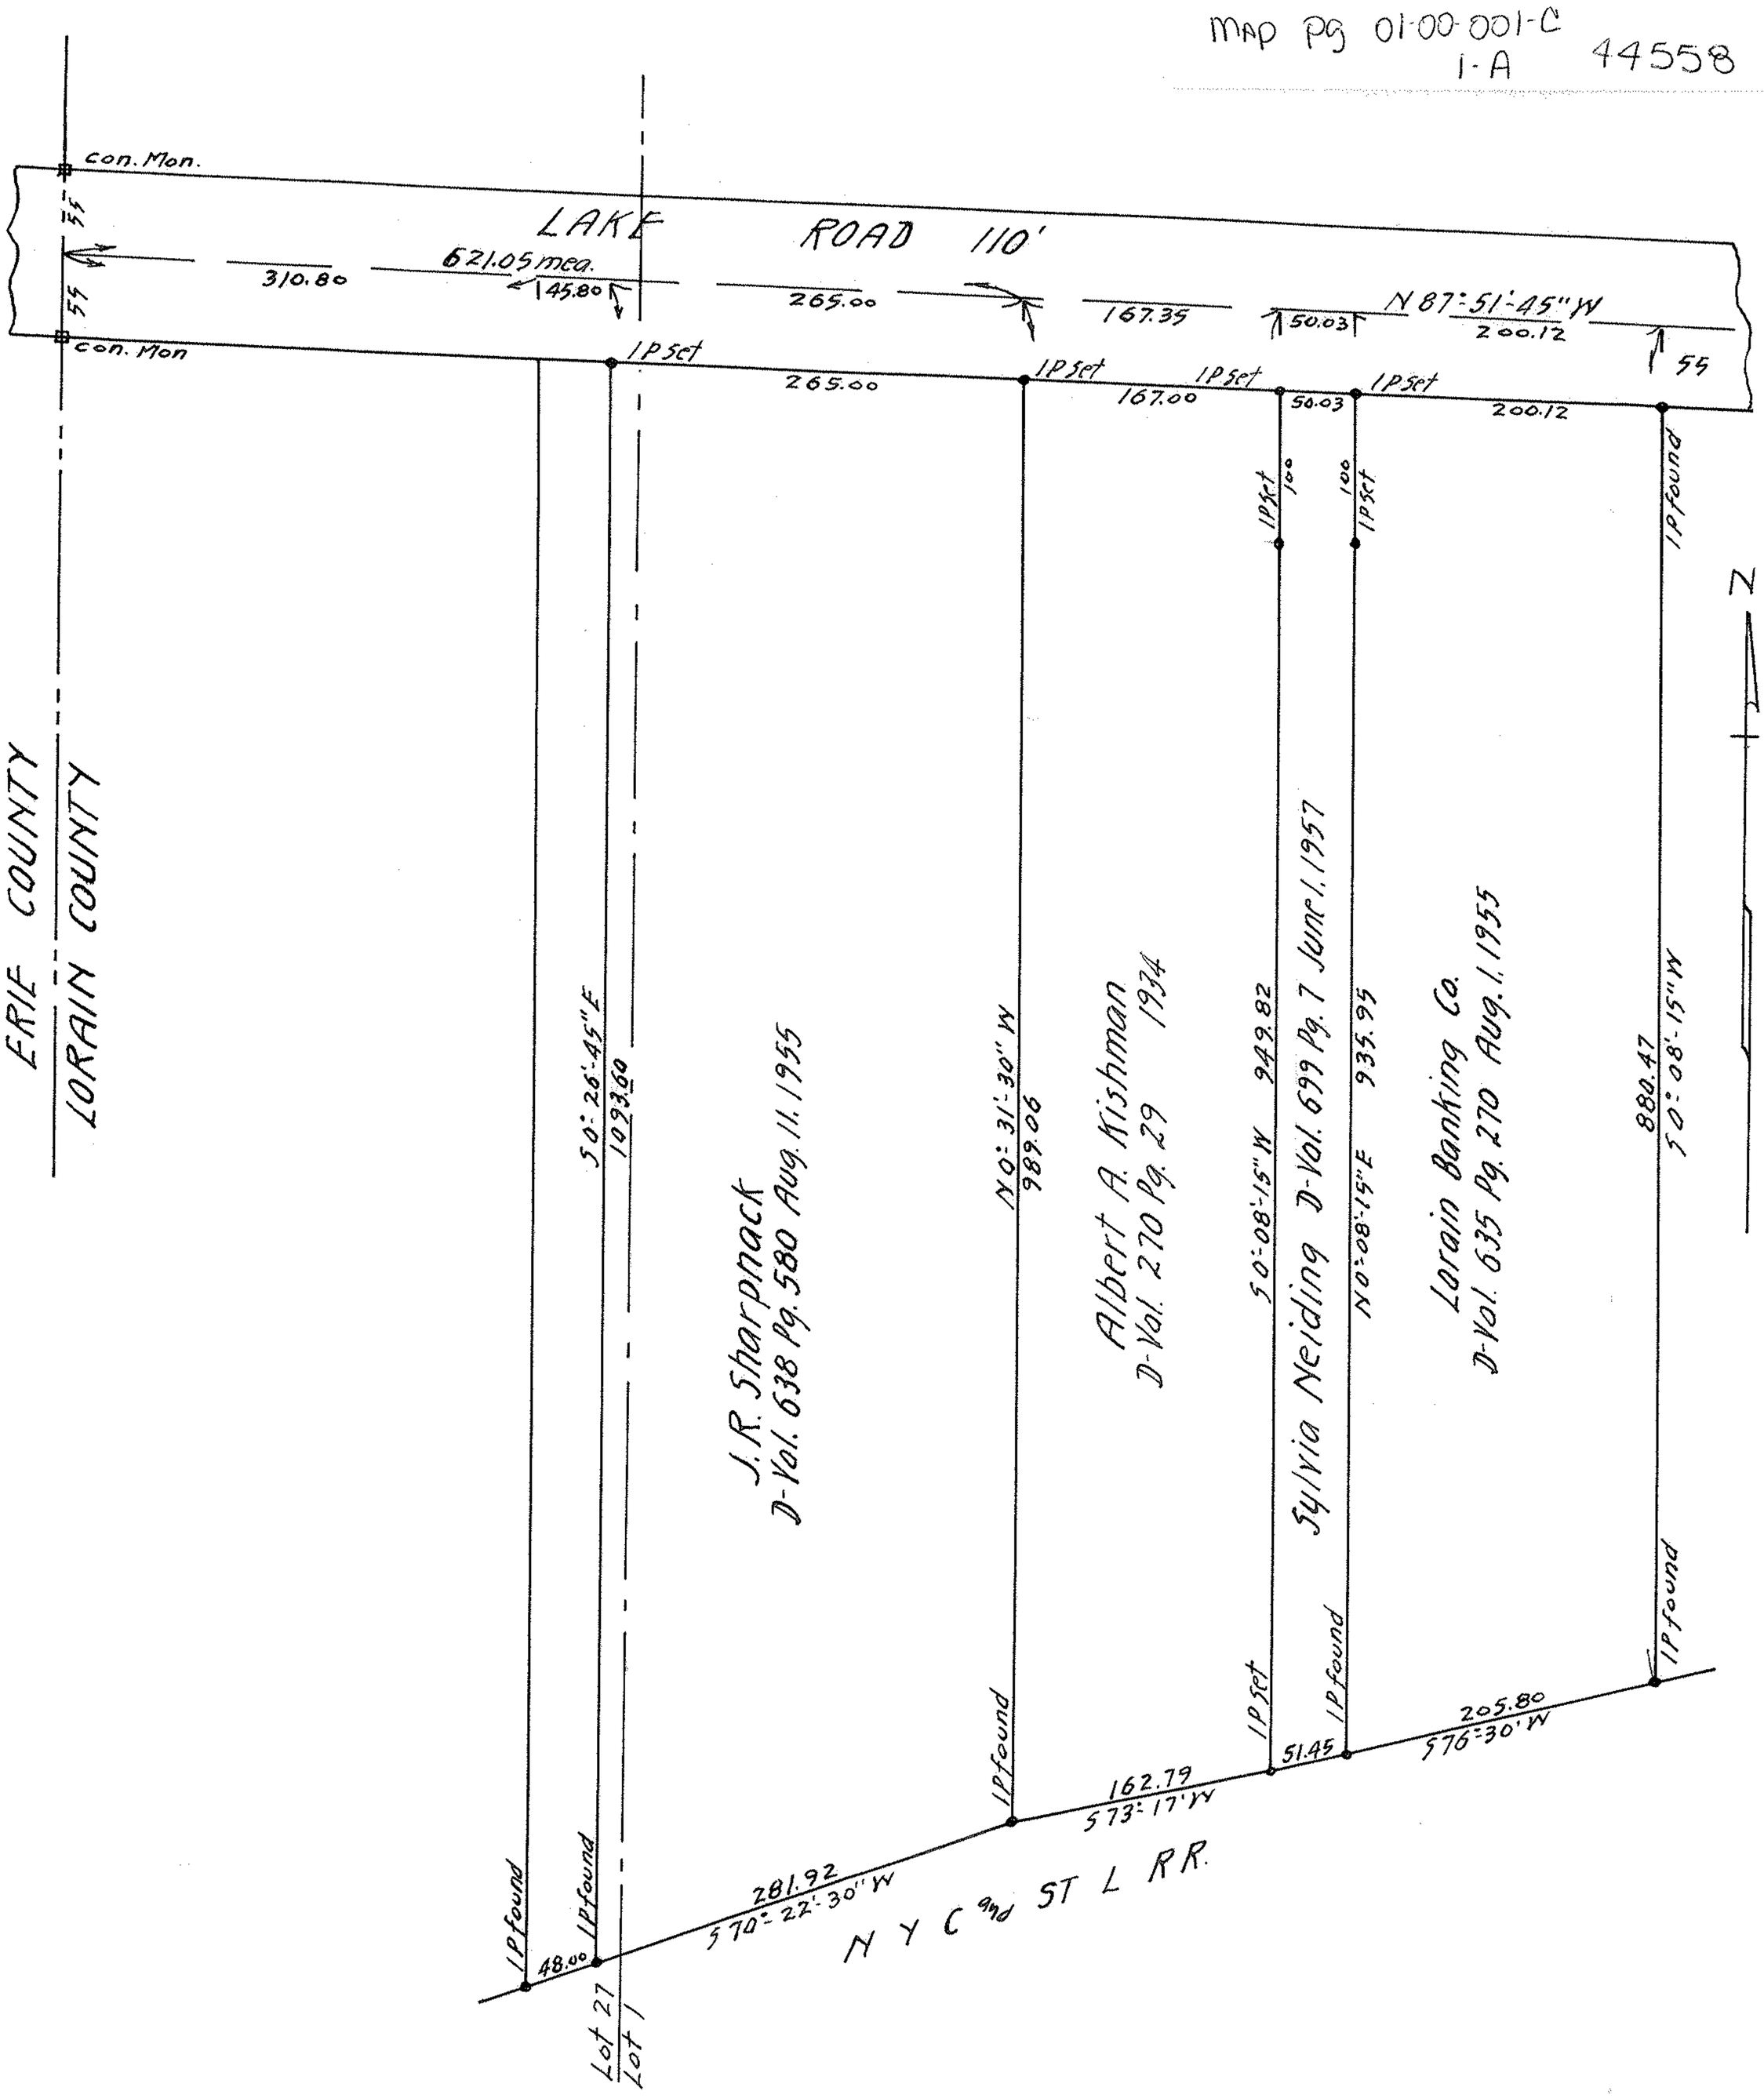
MAP PG 01-00-001-C
1-A 44558