TOPO AND LOCATION MAP
FOR
THE ELYRIA SAVINGS AND TRUST CO.
D-VOL 825 PG. 364 JUNE 22, 1962
PART OF ORIGINAL LOT 21 RIDGEVILLE TWP.
N. RIDGEVILLE CITY, LORAIN CO. OHIO
SCALE 1"=10' AUG. 28, 1962
J. W. WARDEN AND ASSOCIATES REG. SURVEYORS

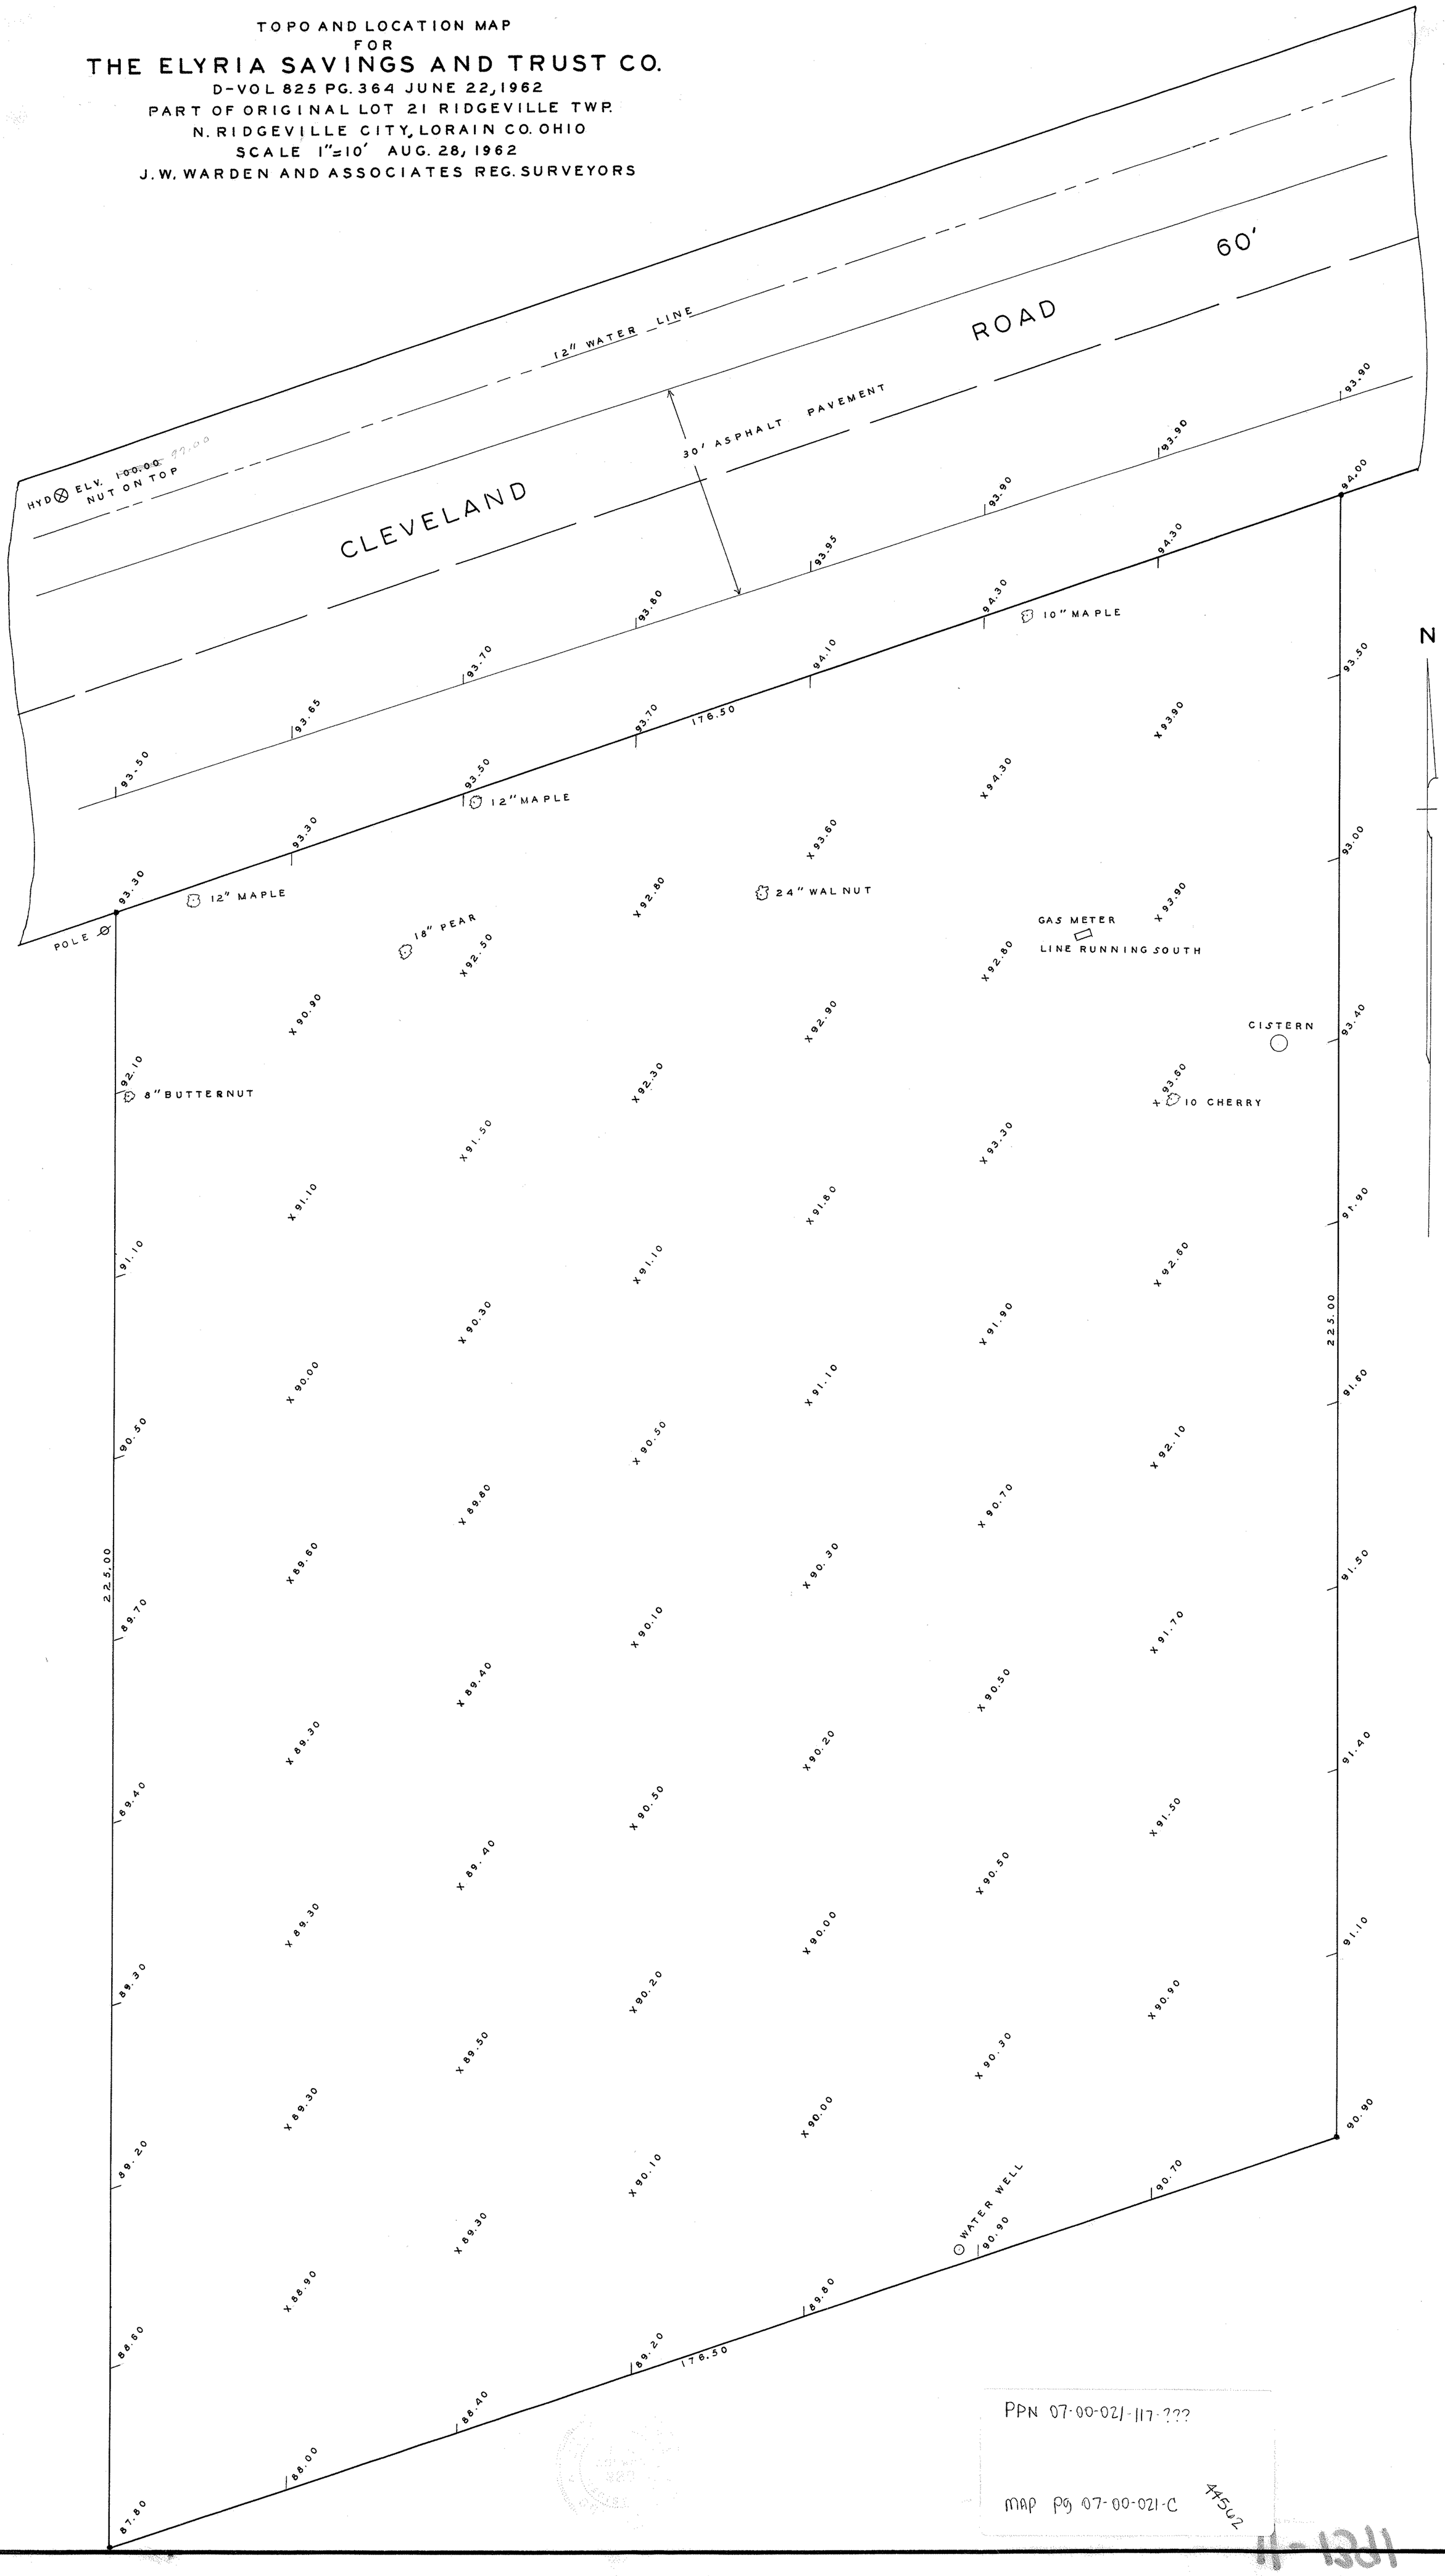

PPN 07-00-021-117-???

MAP pg 07-00-021-C 44542