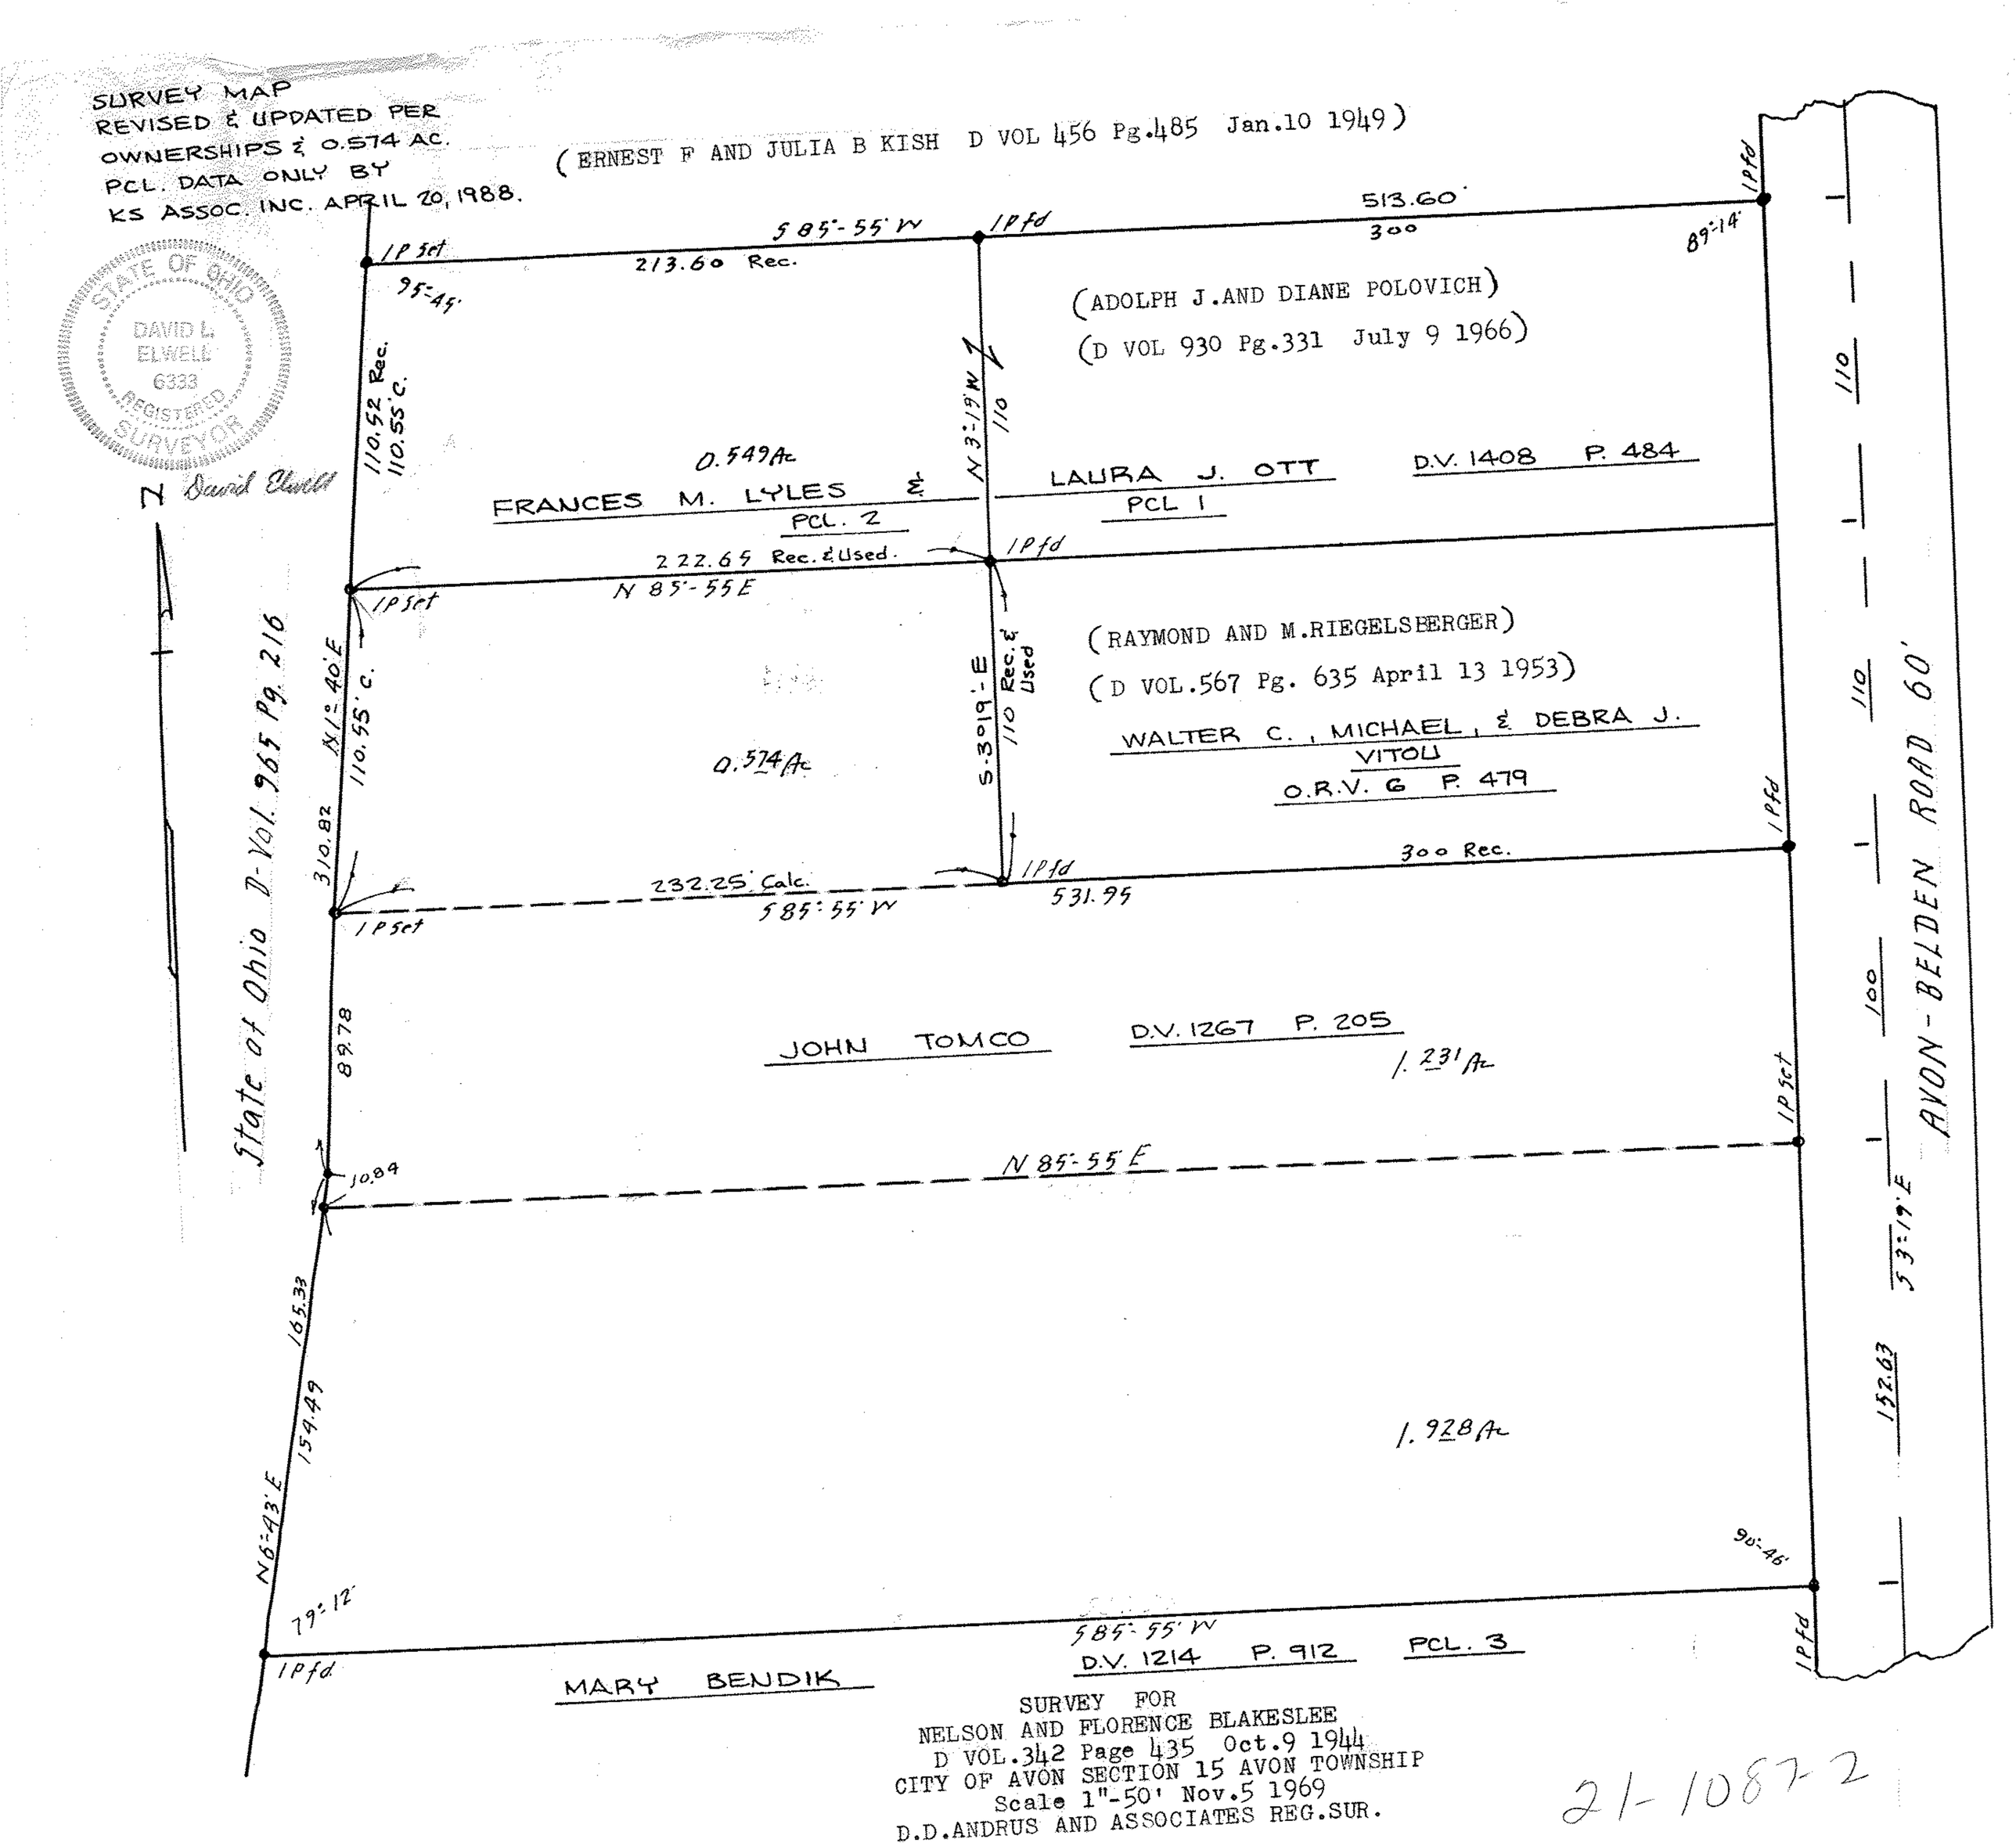

SURVEY FOR
NELSON AND FLORENCE BLAKESLEE
D VOL.342 Page 435 Oct.9 1944
CITY OF AVON SECTION 15 AVON TOWNSHIP
Scale 1"-50' Nov.5 1969
D.D.ANDRUS AND ASSOCIATES REG.SUR.

21-1087-2