PPN 09-00-086-112-020

21-0774-1

MAP Pg 09-00-086-B 14549

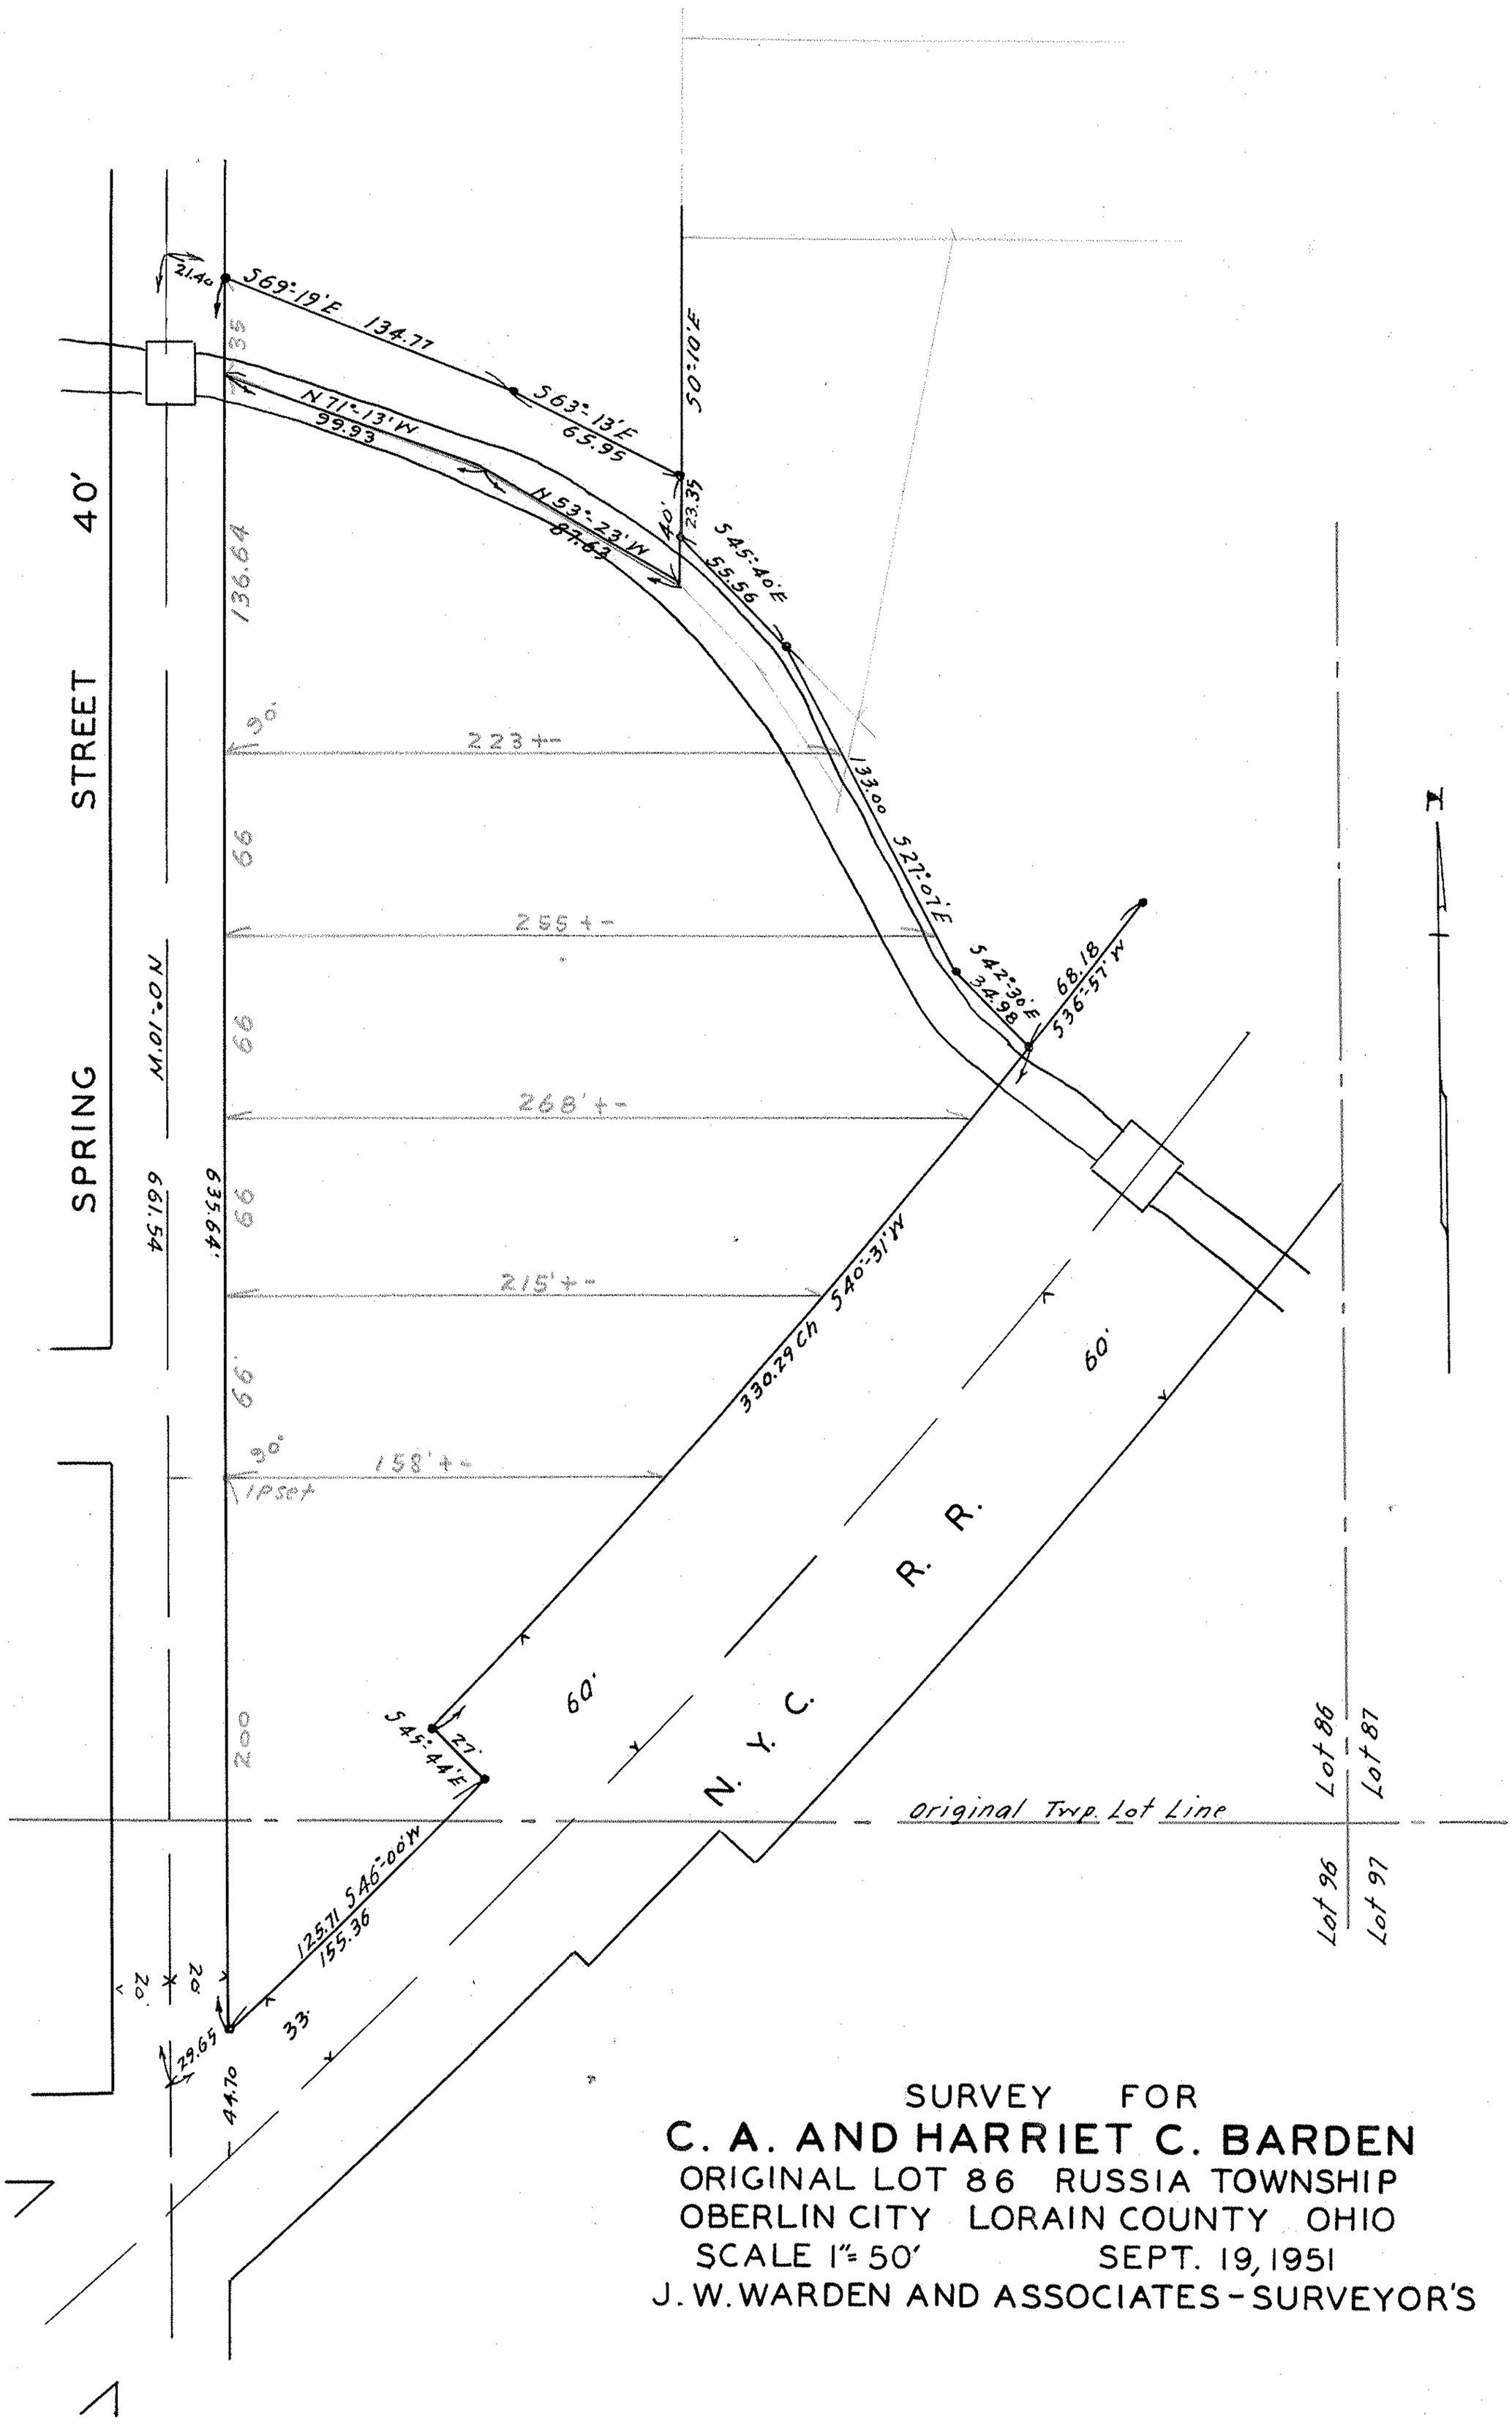

SURVEY FOR

C. A. AND HARRIET C. BARDEN

ORIGINAL LOT 86 RUSSIA TOWNSHIP

OBERLIN CITY LORAIN COUNTY OHIO

SCALE 1"= 50' SEPT. 19, 1951

J. W. WARDEN AND ASSOCIATES - SURVEYOR'S