


22-0871-2

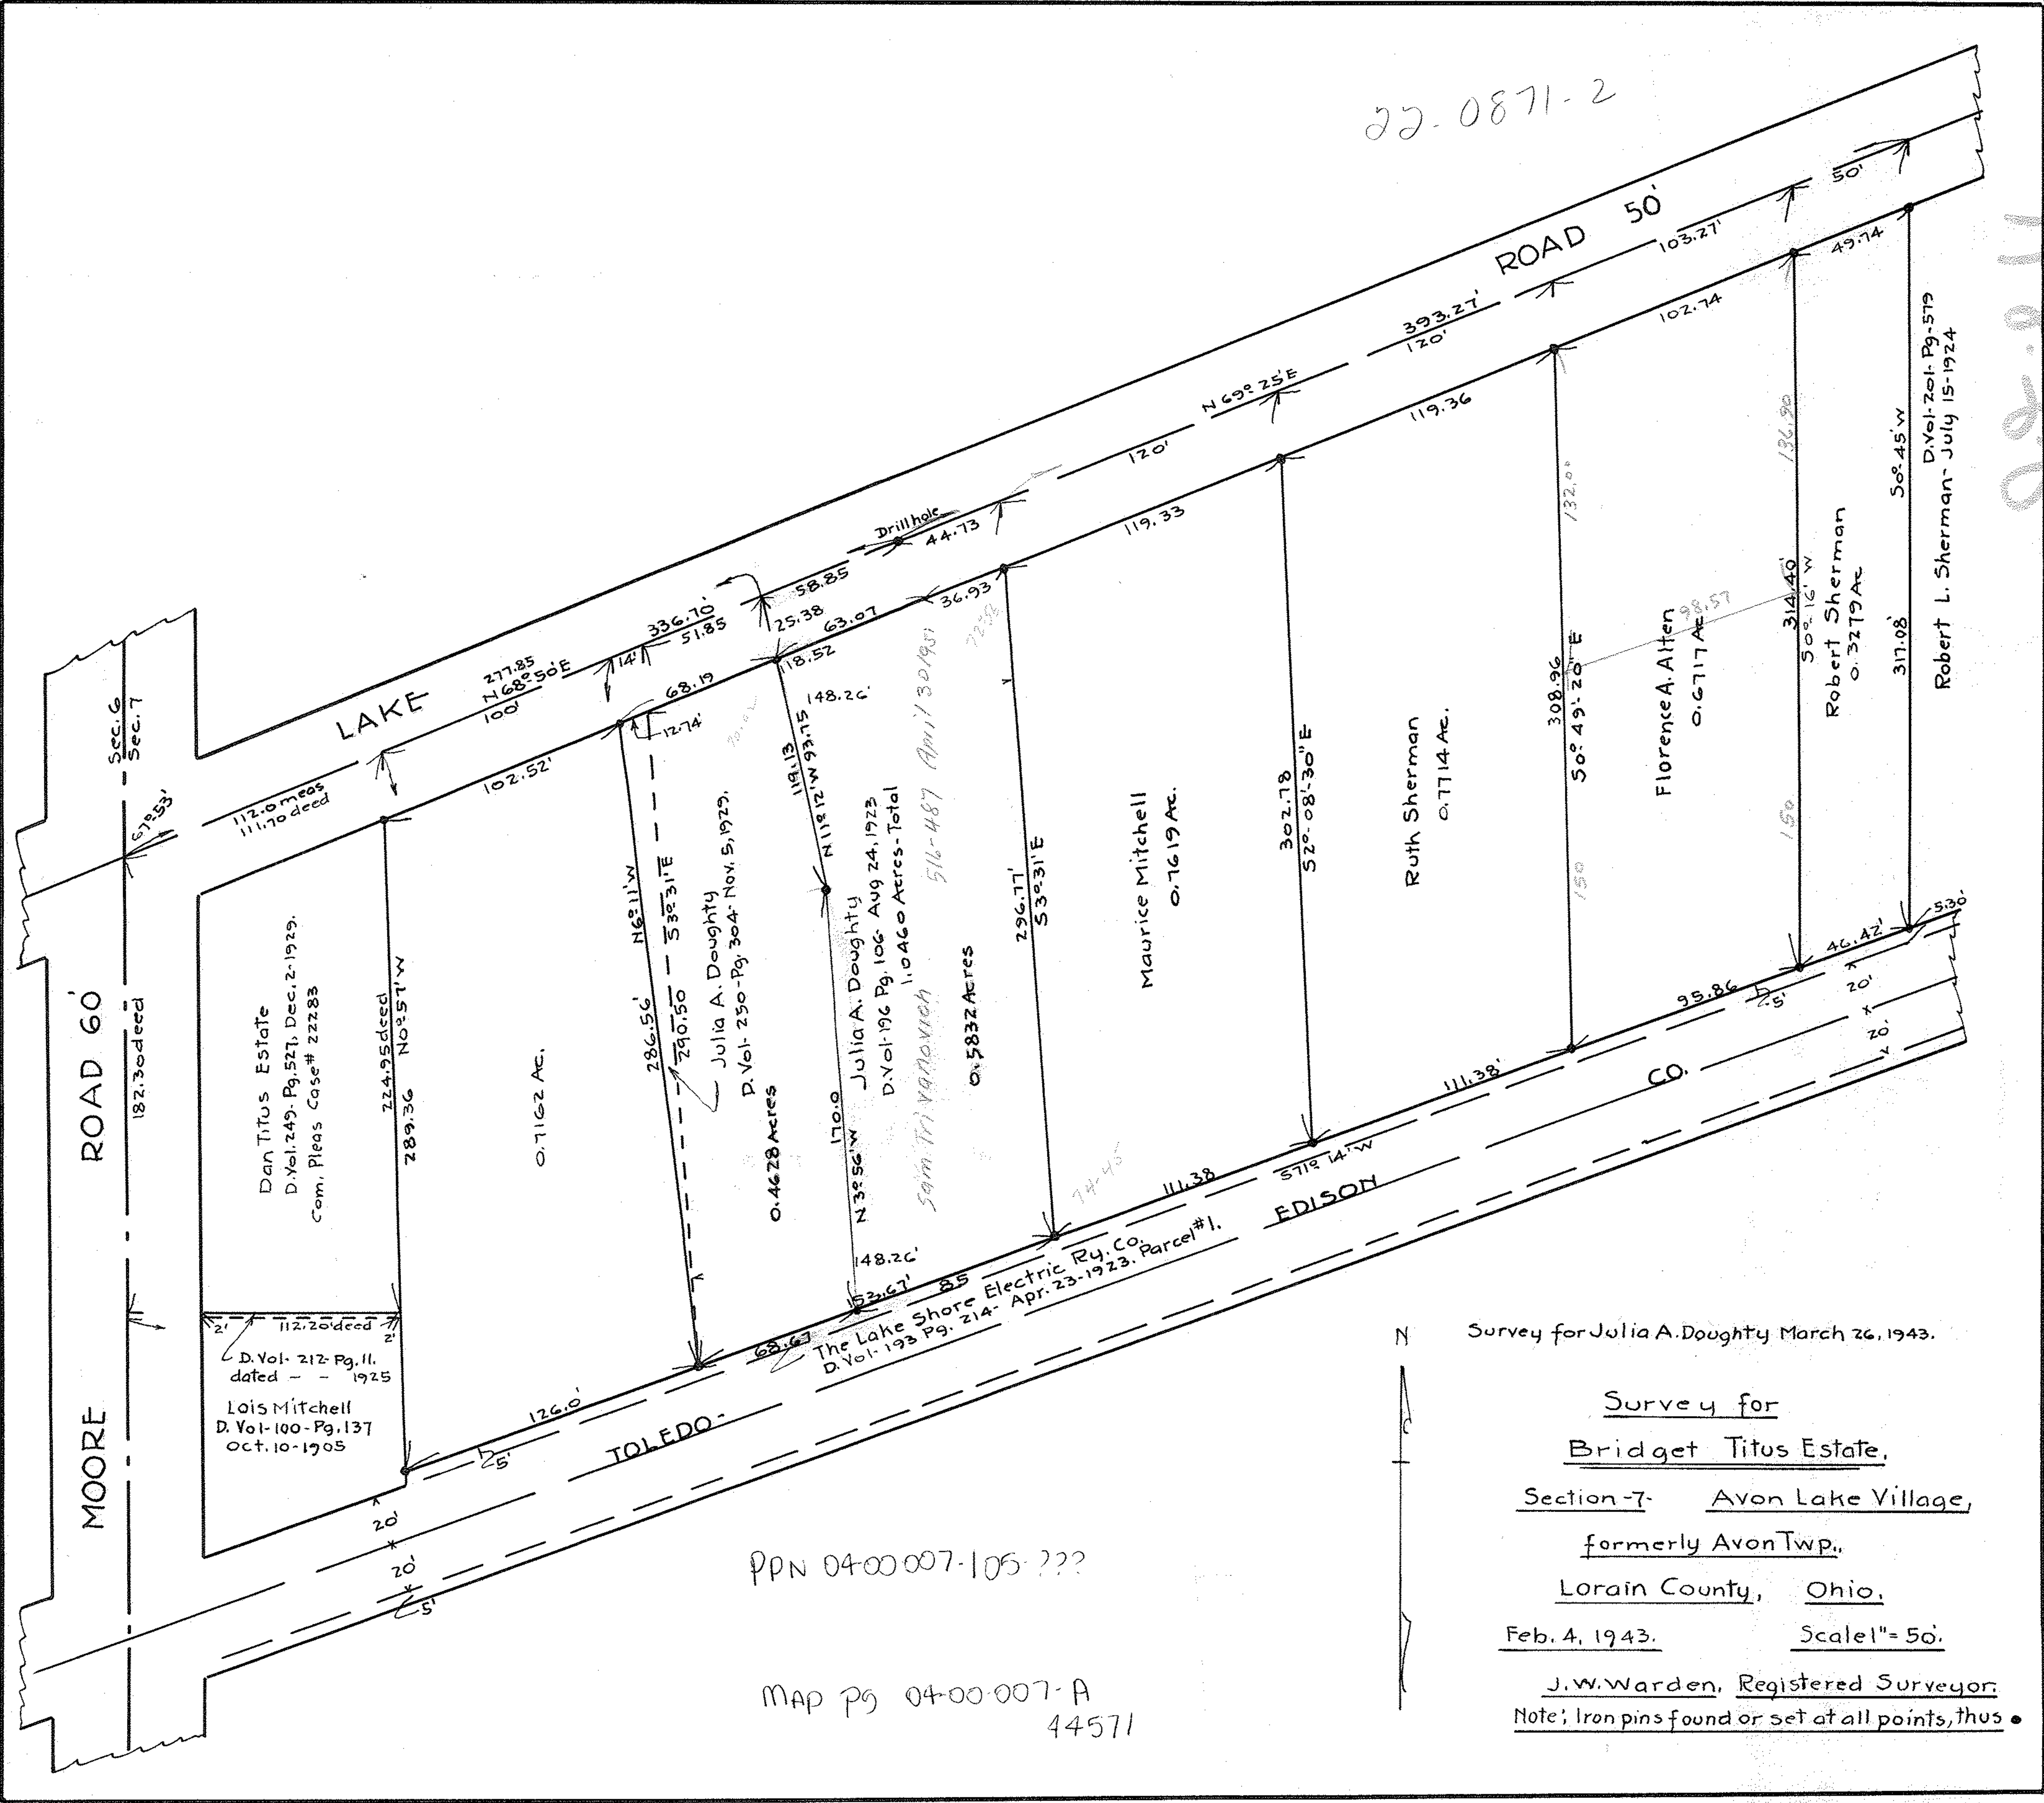

PPN 0400007-105-???

Map Pg 0400007-A  
44571

N  
 Survey for Julia A. Doughty March 26, 1943.

Survey for  
 Bridget Titus Estate,  
 Section -7- Avon Lake Village,  
 formerly Avon Twp.,  
 Lorain County, Ohio,  
 Feb. 4, 1943. Scale 1" = 50'.

J. W. Warden, Registered Surveyor.  
 Note: Iron pins found or set at all points, thus •

22-0871-2