SURVEY FOR

GUY G. AND DORIS ABLE

D-VOL. 825 PG. 612 JULY 5, 1962

O. L. 49 LA-GRANGE TWP.

LORAIN COUNTY, OHIO

SCALE 1" = 50' JULY 18, 1962

J. W. WARDEN AND ASSOCIATES REG. SURVEYORS

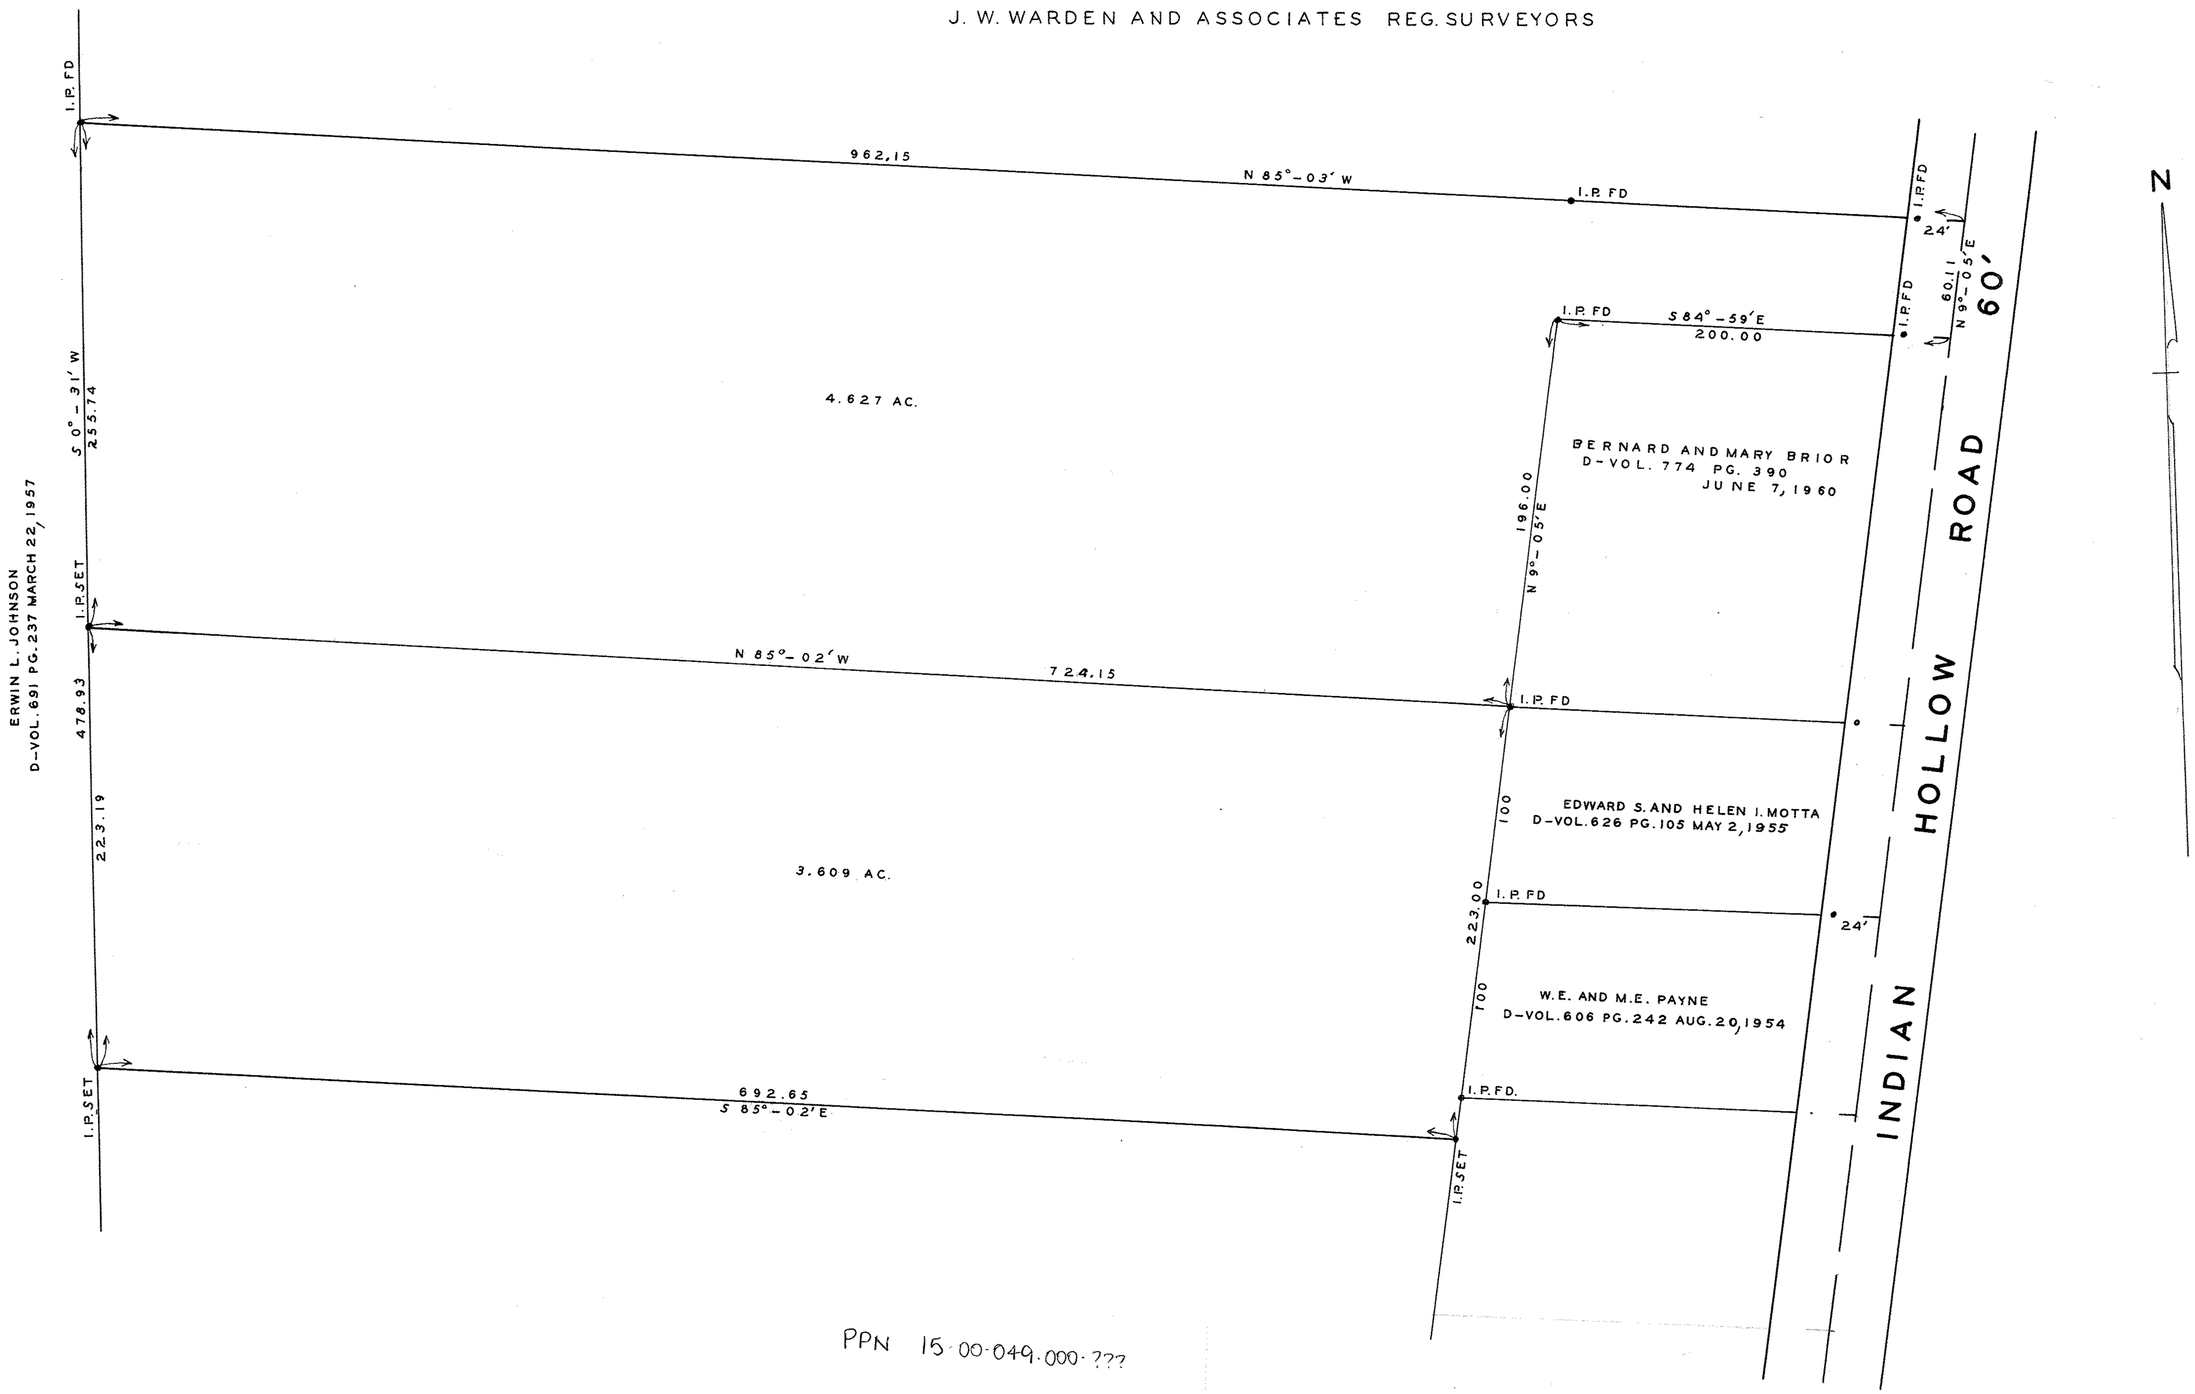

PPN 15-00-049.000-???

MAP PG 15-00-049-B 44580

23-1388-1

23-1388