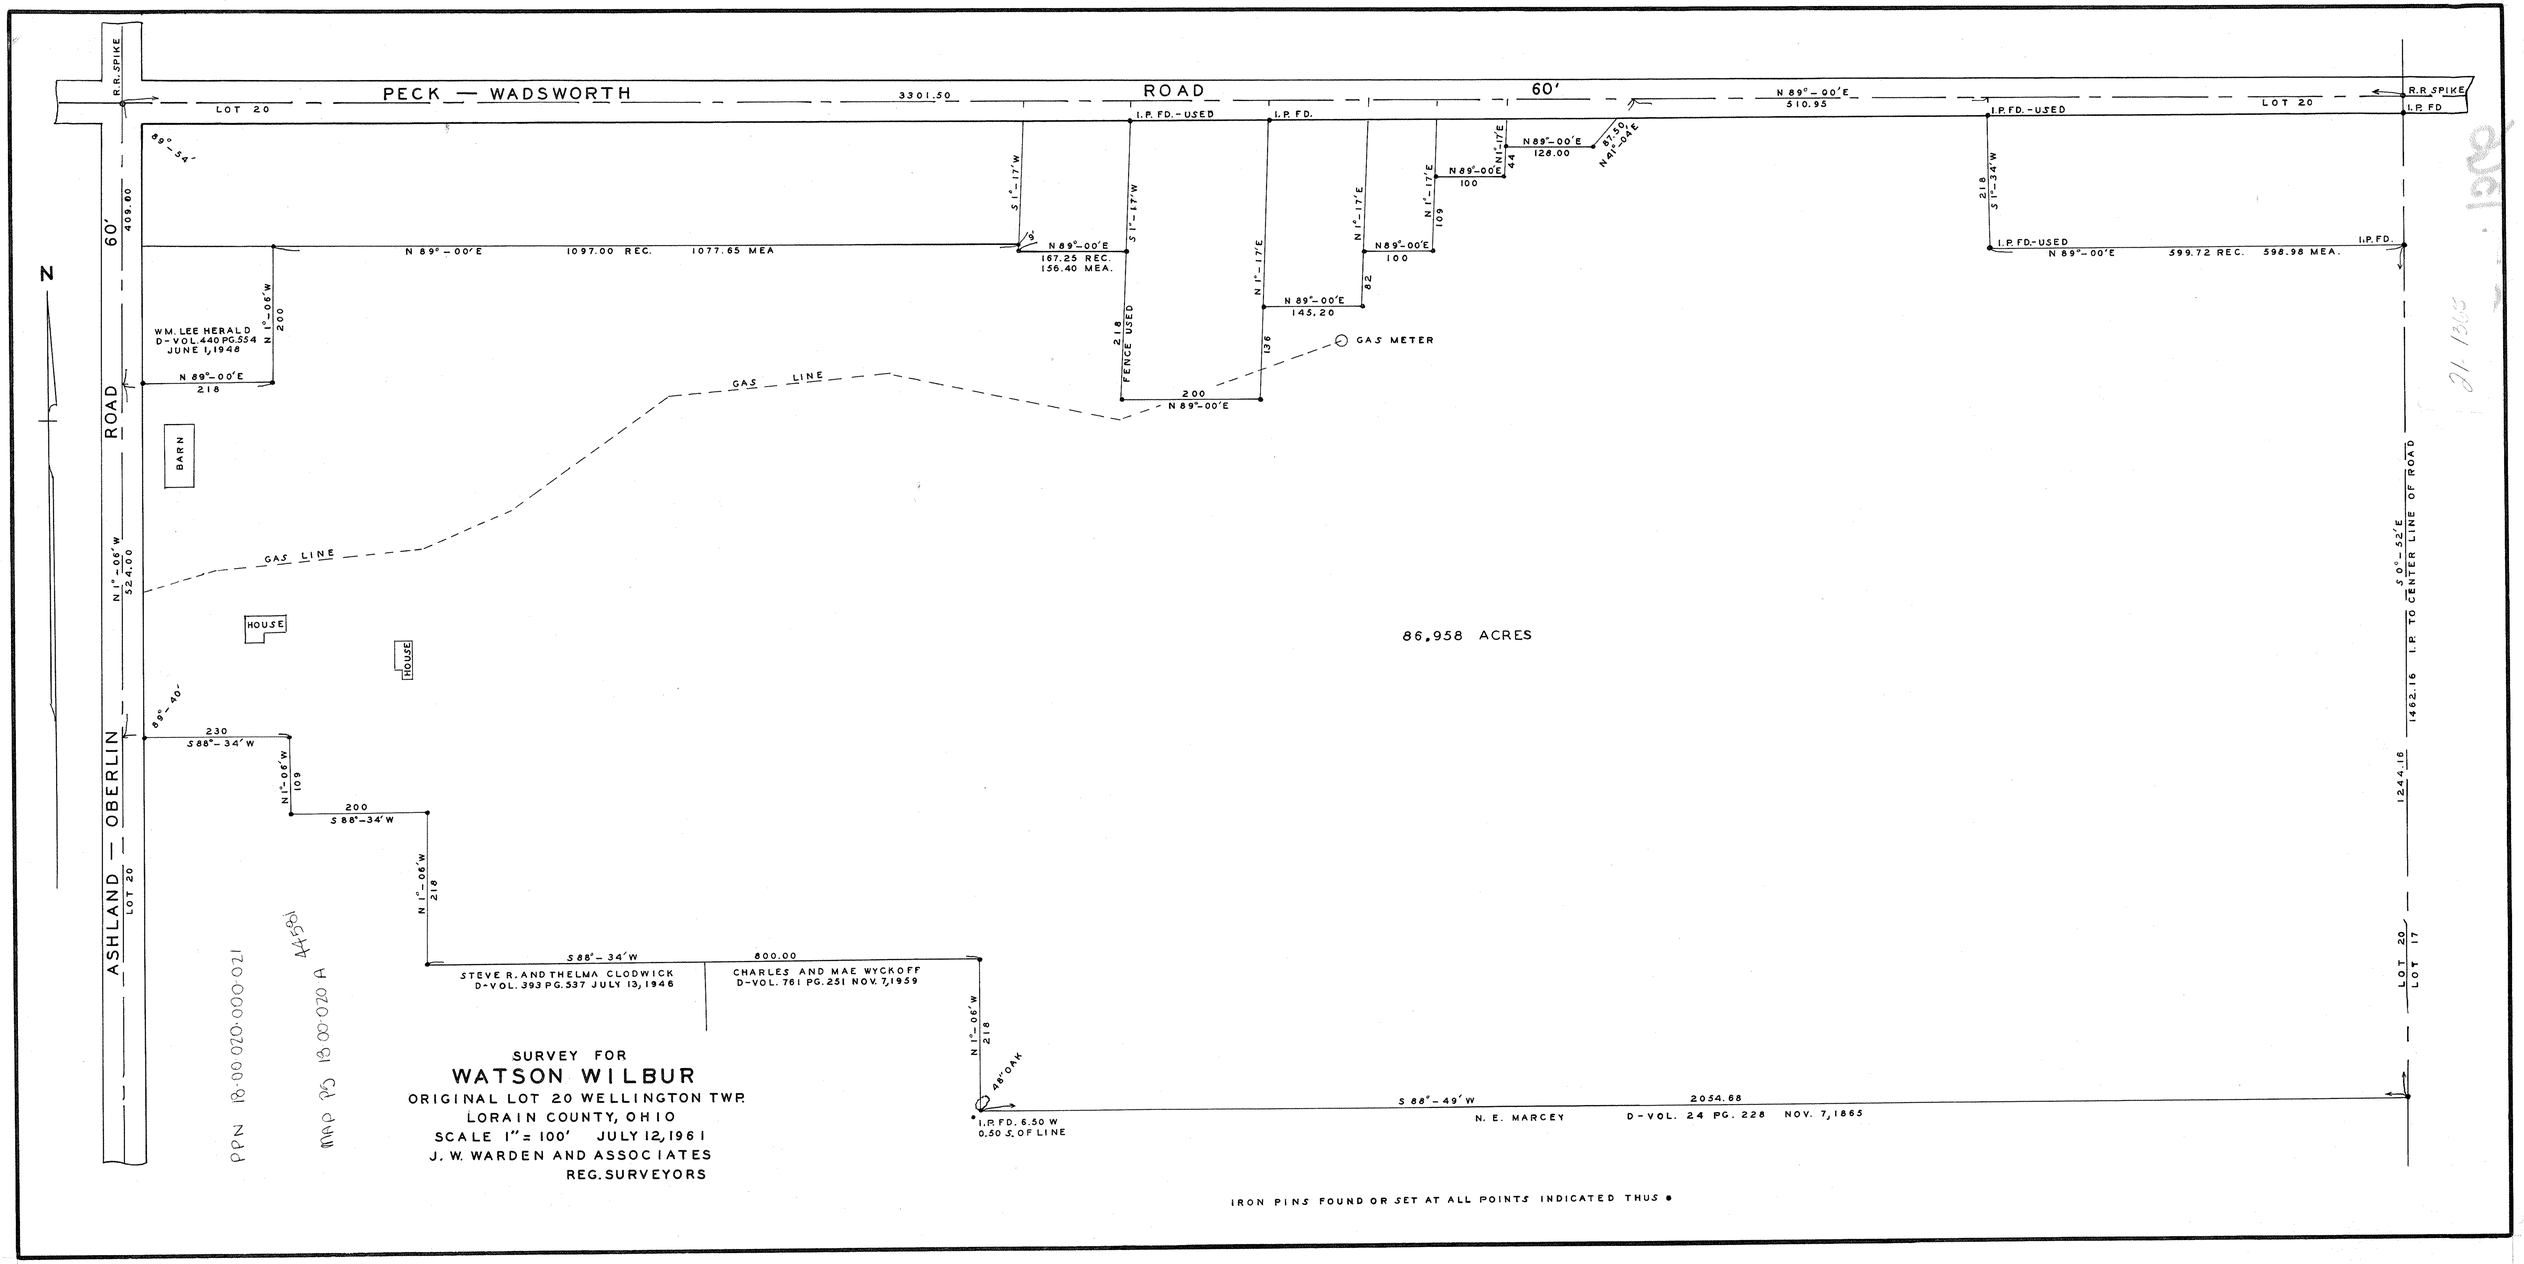
PECK — WADSWORTH ROAD 60'
3301.50
LOT 20
R.R. SPIKE
I.P. FD.-USED
I.P. FD.
N 89° - 00' E
510.95
LOT 20
R.R. SPIKE
I.P. FD
N
ASHLAND — OBERLIN ROAD 60'
LOT 20
409.00
N 89° - 00' E
1097.00 REC.
1077.65 MEA
S 1° - 17' W
N 89° - 00' E
167.25 REC.
156.40 MEA.
S 1° - 17' W
218
FENCE USED
N 1° - 17' E
136
N 89° - 00' E
145.20
82
N 1° - 17' E
N 89° - 00' E
100
N 1° - 17' E
109
N 89° - 00' E
100
N 1° - 17' E
44
N 89° - 00' E
128.00
87.50
N 41° - 04' E
218
S 1° - 34' W
I.P. FD.-USED
N 89° - 00' E
599.72 REC.
598.98 MEA.
I.P. FD.
WM. LEE HERALD
D-VOL. 440 PG. 554
JUNE 1, 1948
N 1° - 06' W
200
N 89° - 00' E
218
GAS LINE
GAS METER
200
N 89° - 00' E
BARN
GAS LINE
N 1° - 06' W
524.00
HOUSE
HOUSE
86.958 ACRES
S 0° - 52' E
1462.16 I.P. TO CENTER LINE OF ROAD
1244.16
LOT 20
LOT 17
230
S 88° - 34' W
N 1° - 06' W
109
200
S 88° - 34' W
N 1° - 06' W
218
S 88° - 34' W
800.00
STEVE R. AND THELMA CLODWICK
D-VOL. 393 PG. 537 JULY 13, 1946
CHARLES AND MAE WYCKOFF
D-VOL. 761 PG. 251 NOV. 7, 1959
N 1° - 06' W
218
48" OAK
I.P. FD. 6.50 W
0.50 S. OF LINE
S 88° - 49' W
2054.68
N. E. MARCEY
D-VOL. 24 PG. 228 NOV. 7, 1865
PPN 18-00-020-000-021
MAP 25 18-00-020 A
SURVEY FOR
WATSON WILBUR
ORIGINAL LOT 20 WELLINGTON TWP.
LORAIN COUNTY, OHIO
SCALE 1" = 100' JULY 12, 1961
J. W. WARDEN AND ASSOCIATES
REG. SURVEYORS
IRON PINS FOUND OR SET AT ALL POINTS INDICATED THUS •