MUNICIPAL ENGINEERING SUBDIVISIONS CITY AND FARM SURVEYS

J. W. WARDEN & ASSOCIATES

CIVIL ENGINEERS AND SURVEYORS

STATE OF OHIO
REGISTERED { PROFESSIONAL ENG. / SURVEYOR

D. D. ANDRUS, PRESIDENT
405 ELYRIA BLOCK
ELYRIA, OHIO

TELEPHONES 3211
42871

M. W. JACKSON
SECRETARY

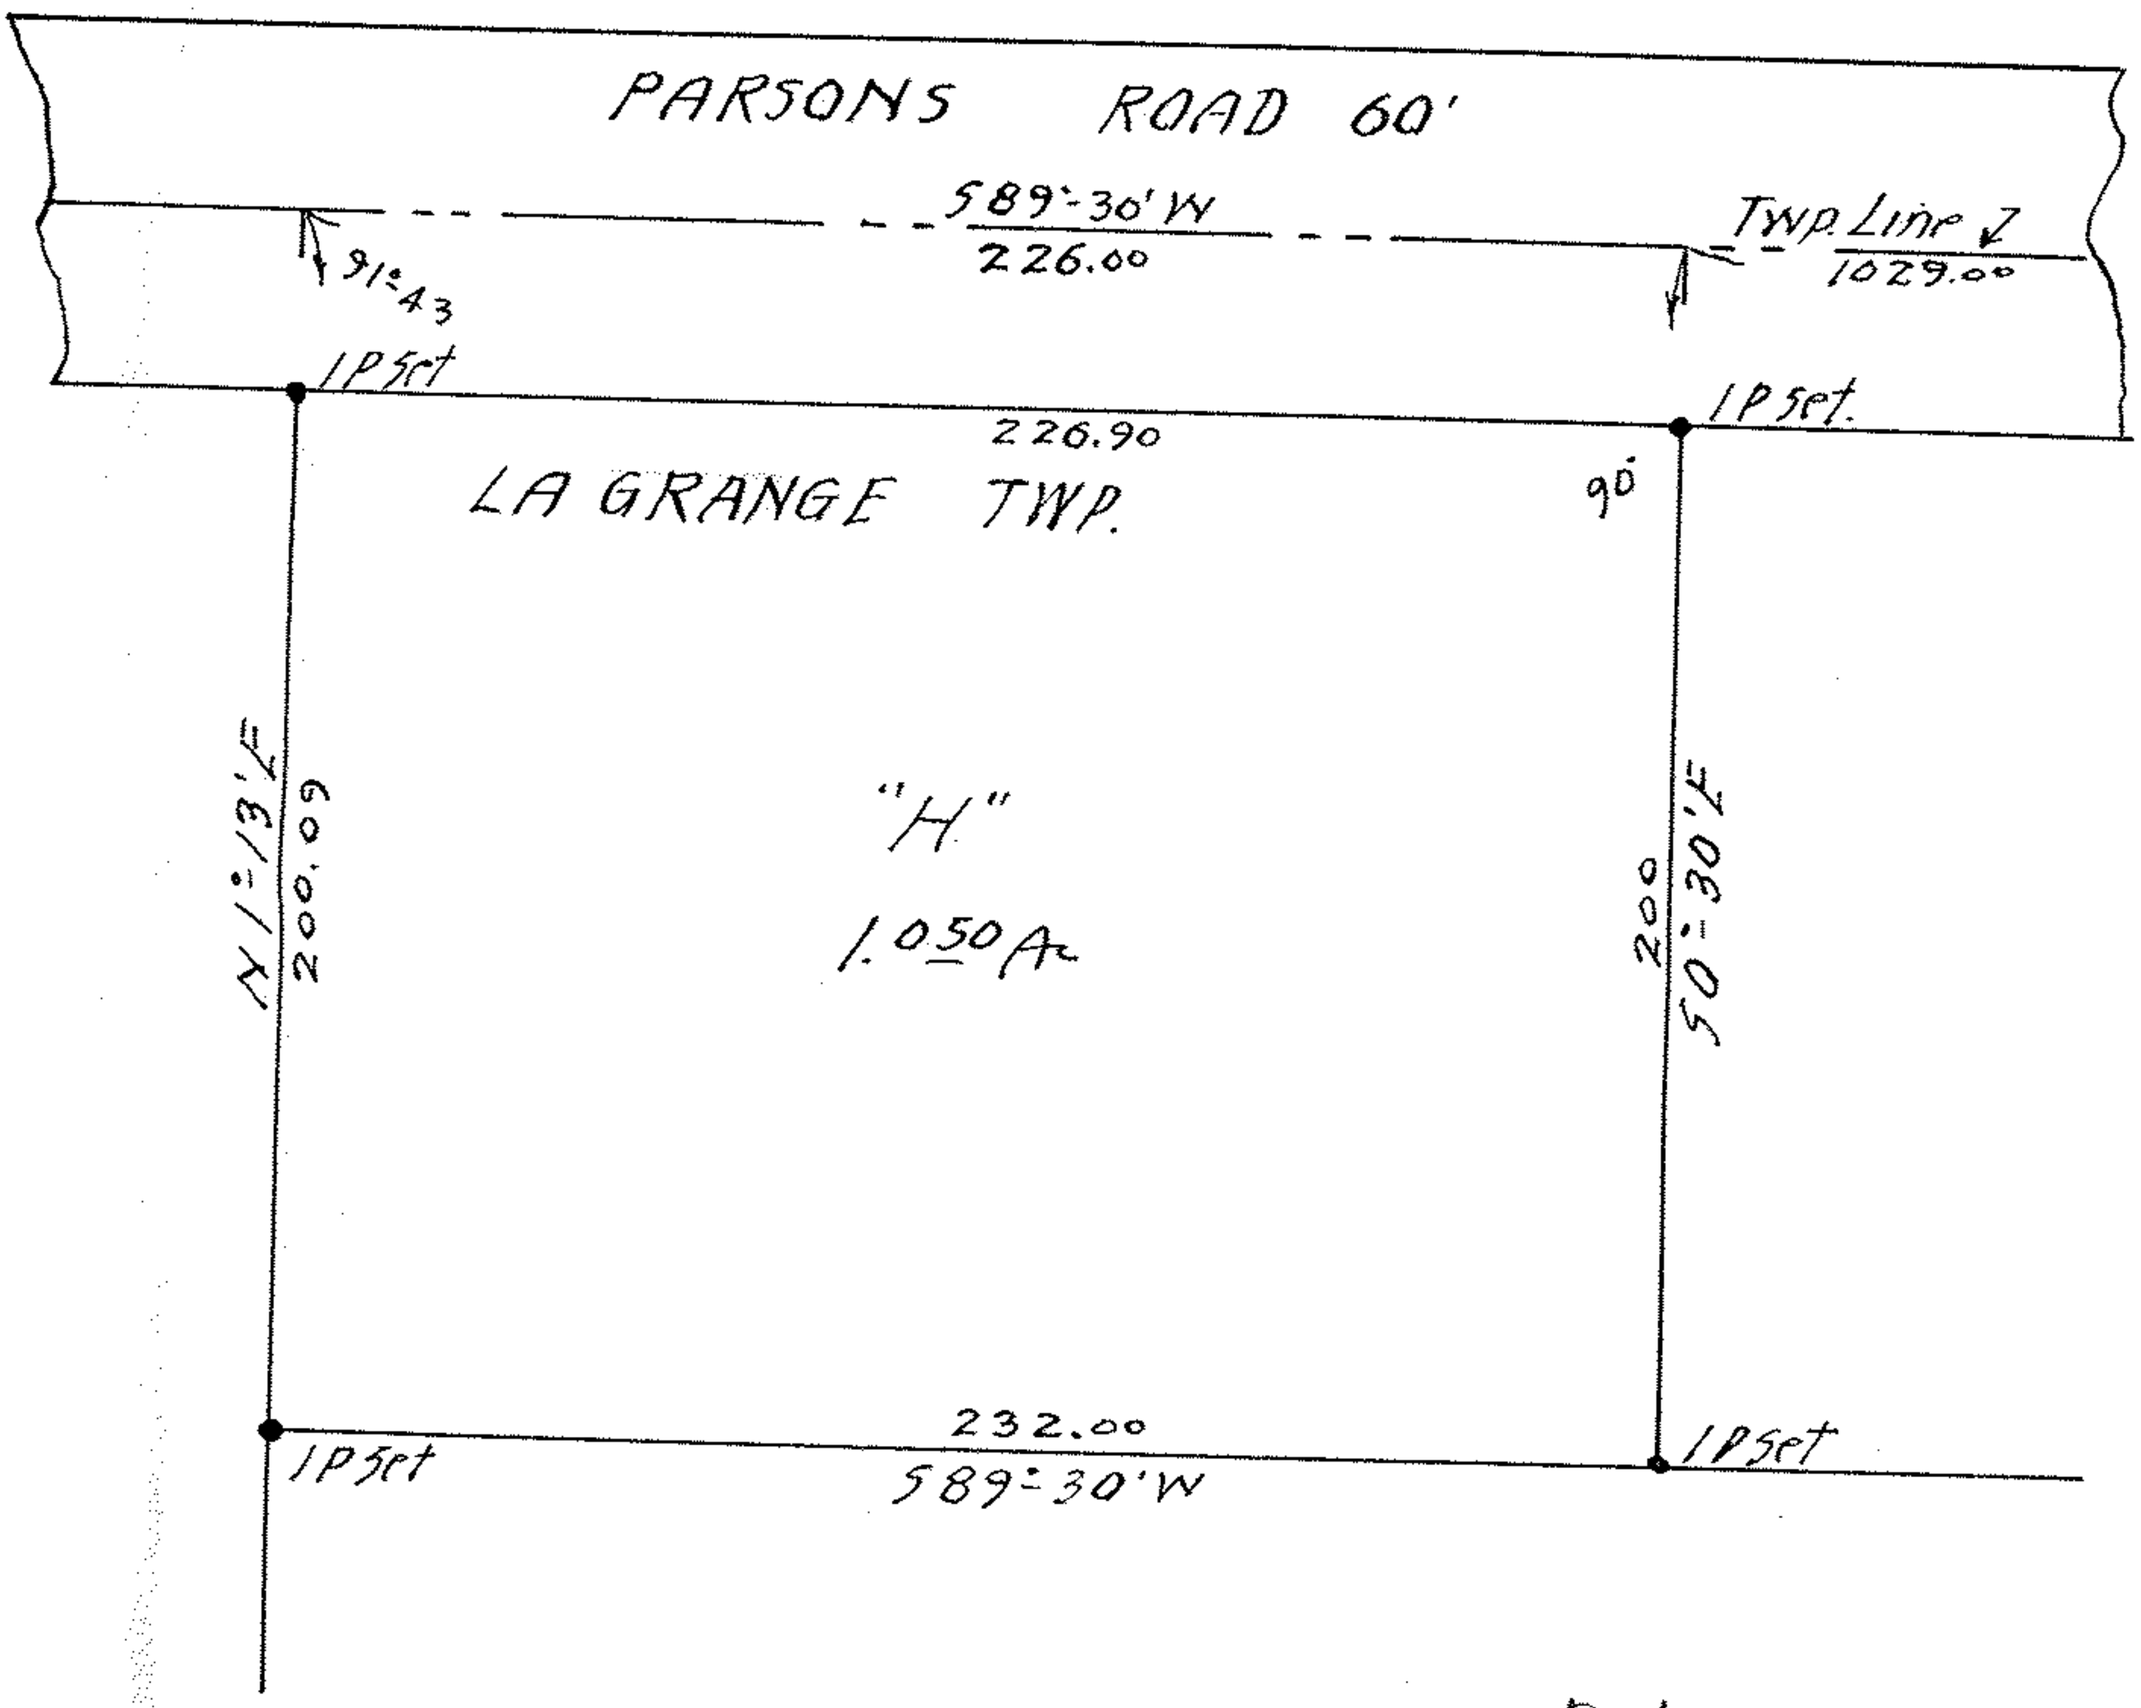

21-1283-2

SURVEY FOR
ALFRED J. FRABOTTA
LOT 9 LaGRANGE TWP.
LORAIN COUNTY OHIO
SCALE 1" = 50' OCT 11, 1957