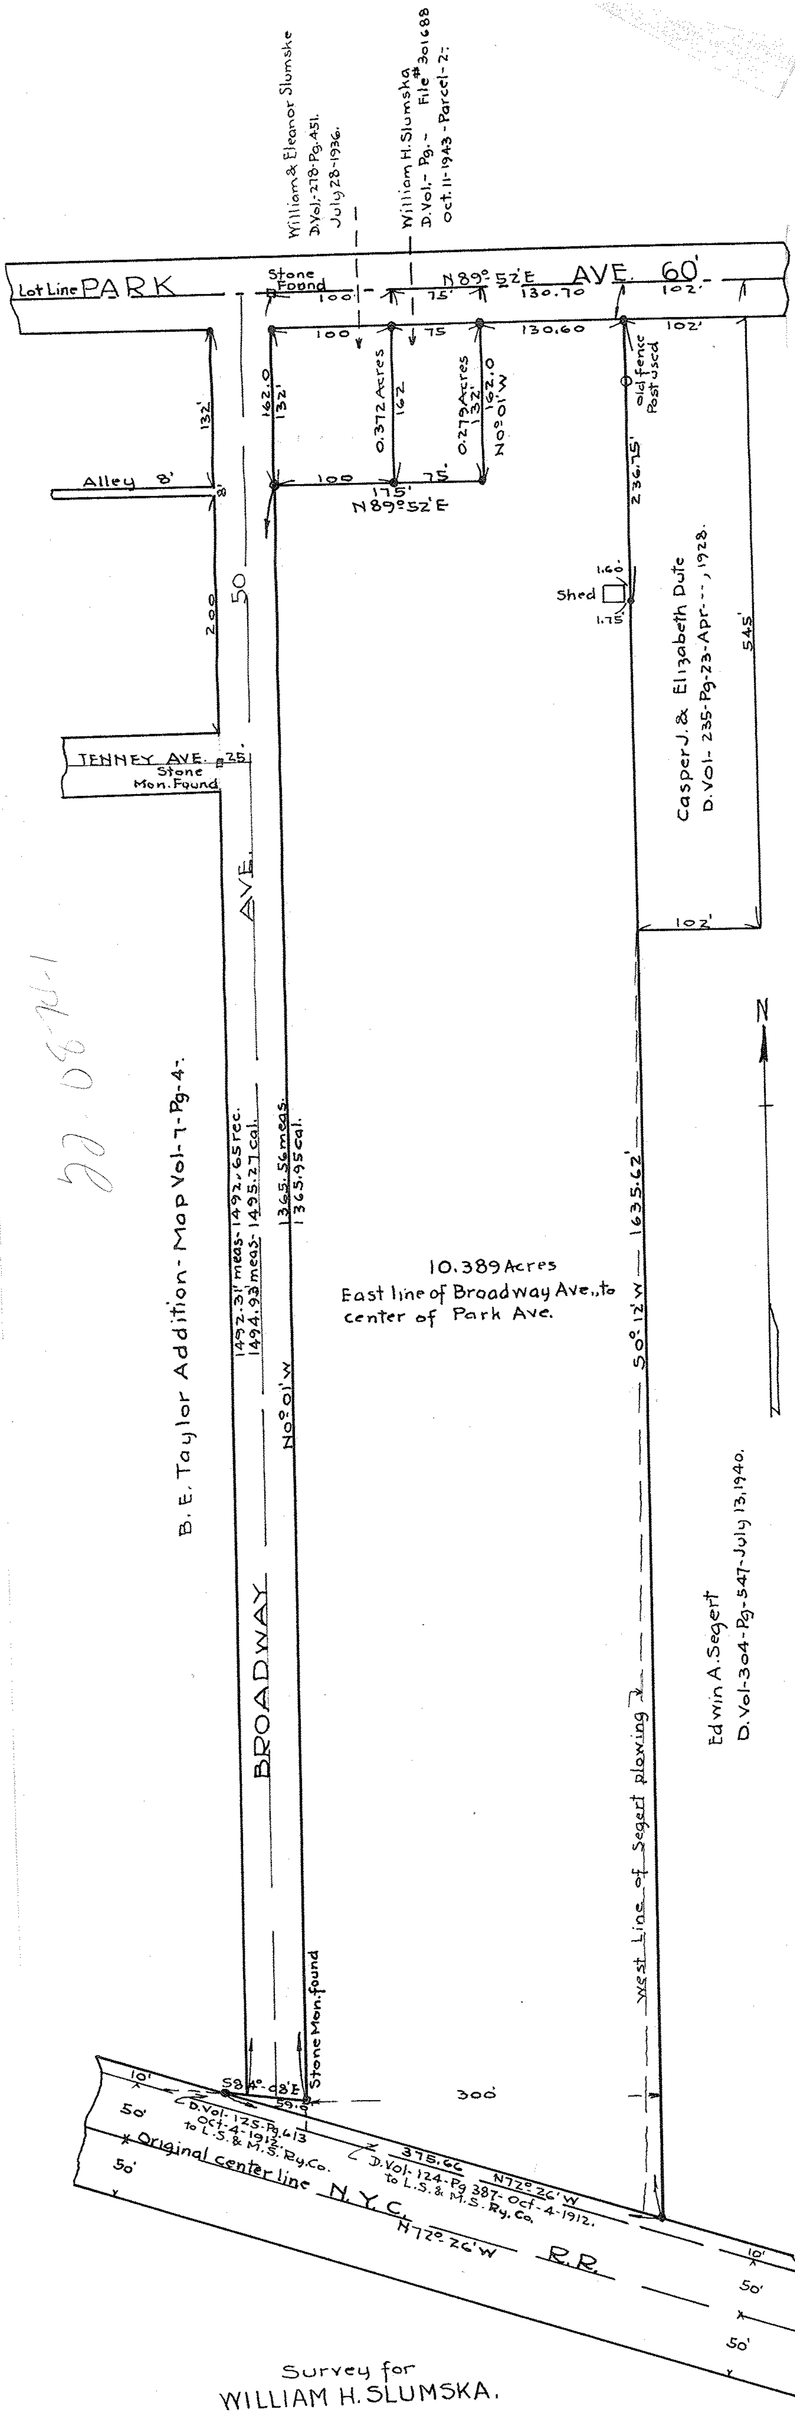

Survey for
WILLIAM H. SLUMSKA.

Original Lot 37. Amherst Twp., Lorain Co., O.

Scale 1" = 100'. Oct. 23, 1943.

J. W. Warden, Registered Surveyor.

Note: Iron Pins set at points marked thus ●.