


N

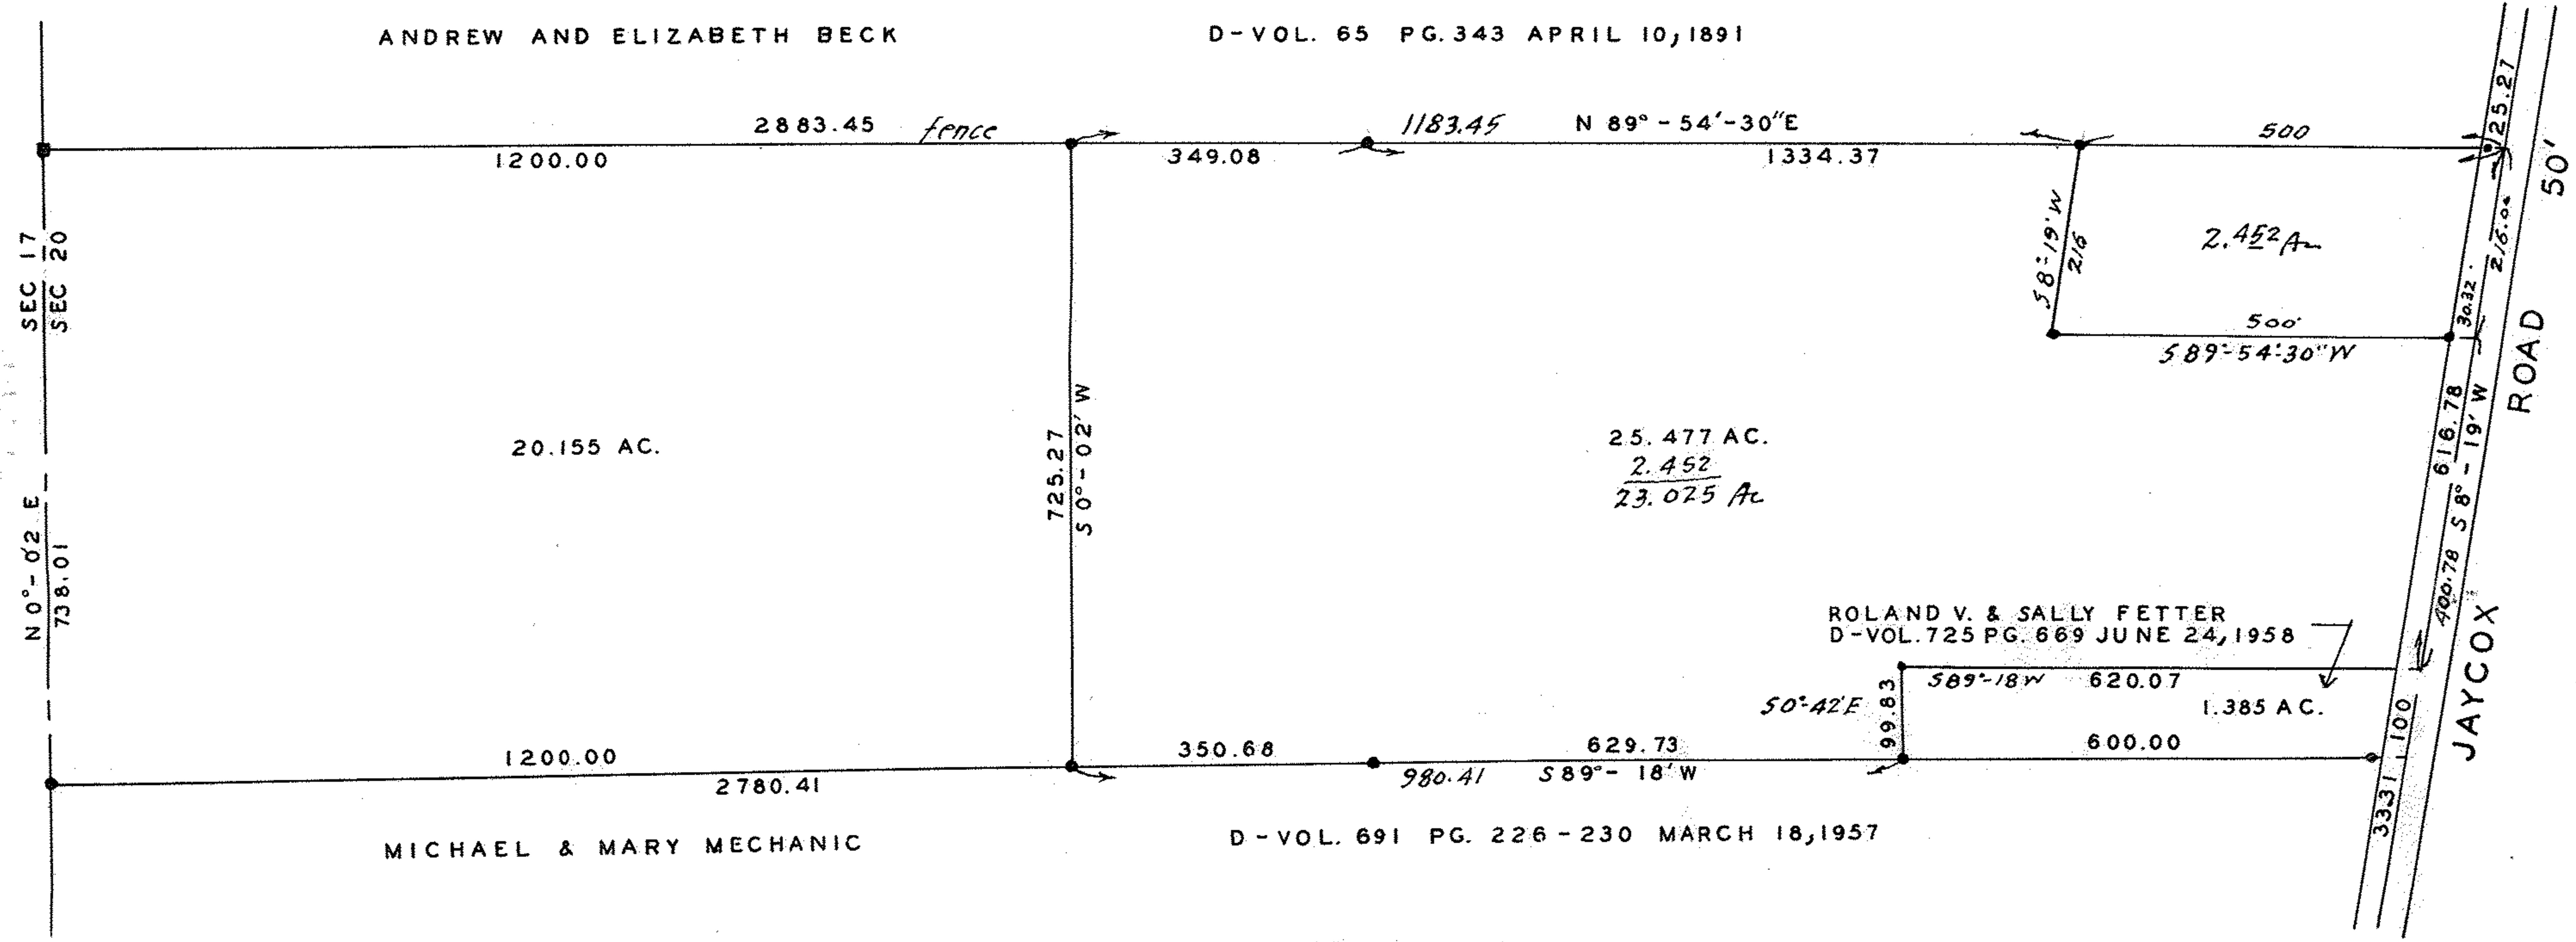

22-0909-1

SURVEY FOR
 PAUL PETROVSKY JUN 23 1948
 PAGE 776-779 MAR 18, 1957
 SEC 20 AVON LAKE VILLAGE
 LORAIN COUNTY, OHIO
 SCALE 1" = 200' FEB 5, 1959
 J. W. WARDEN AND ASSOCIATES REG. SURVEYORS

Iron pins found or set at all points indicated thus • Revised Nov. 16, 1959 D.A.