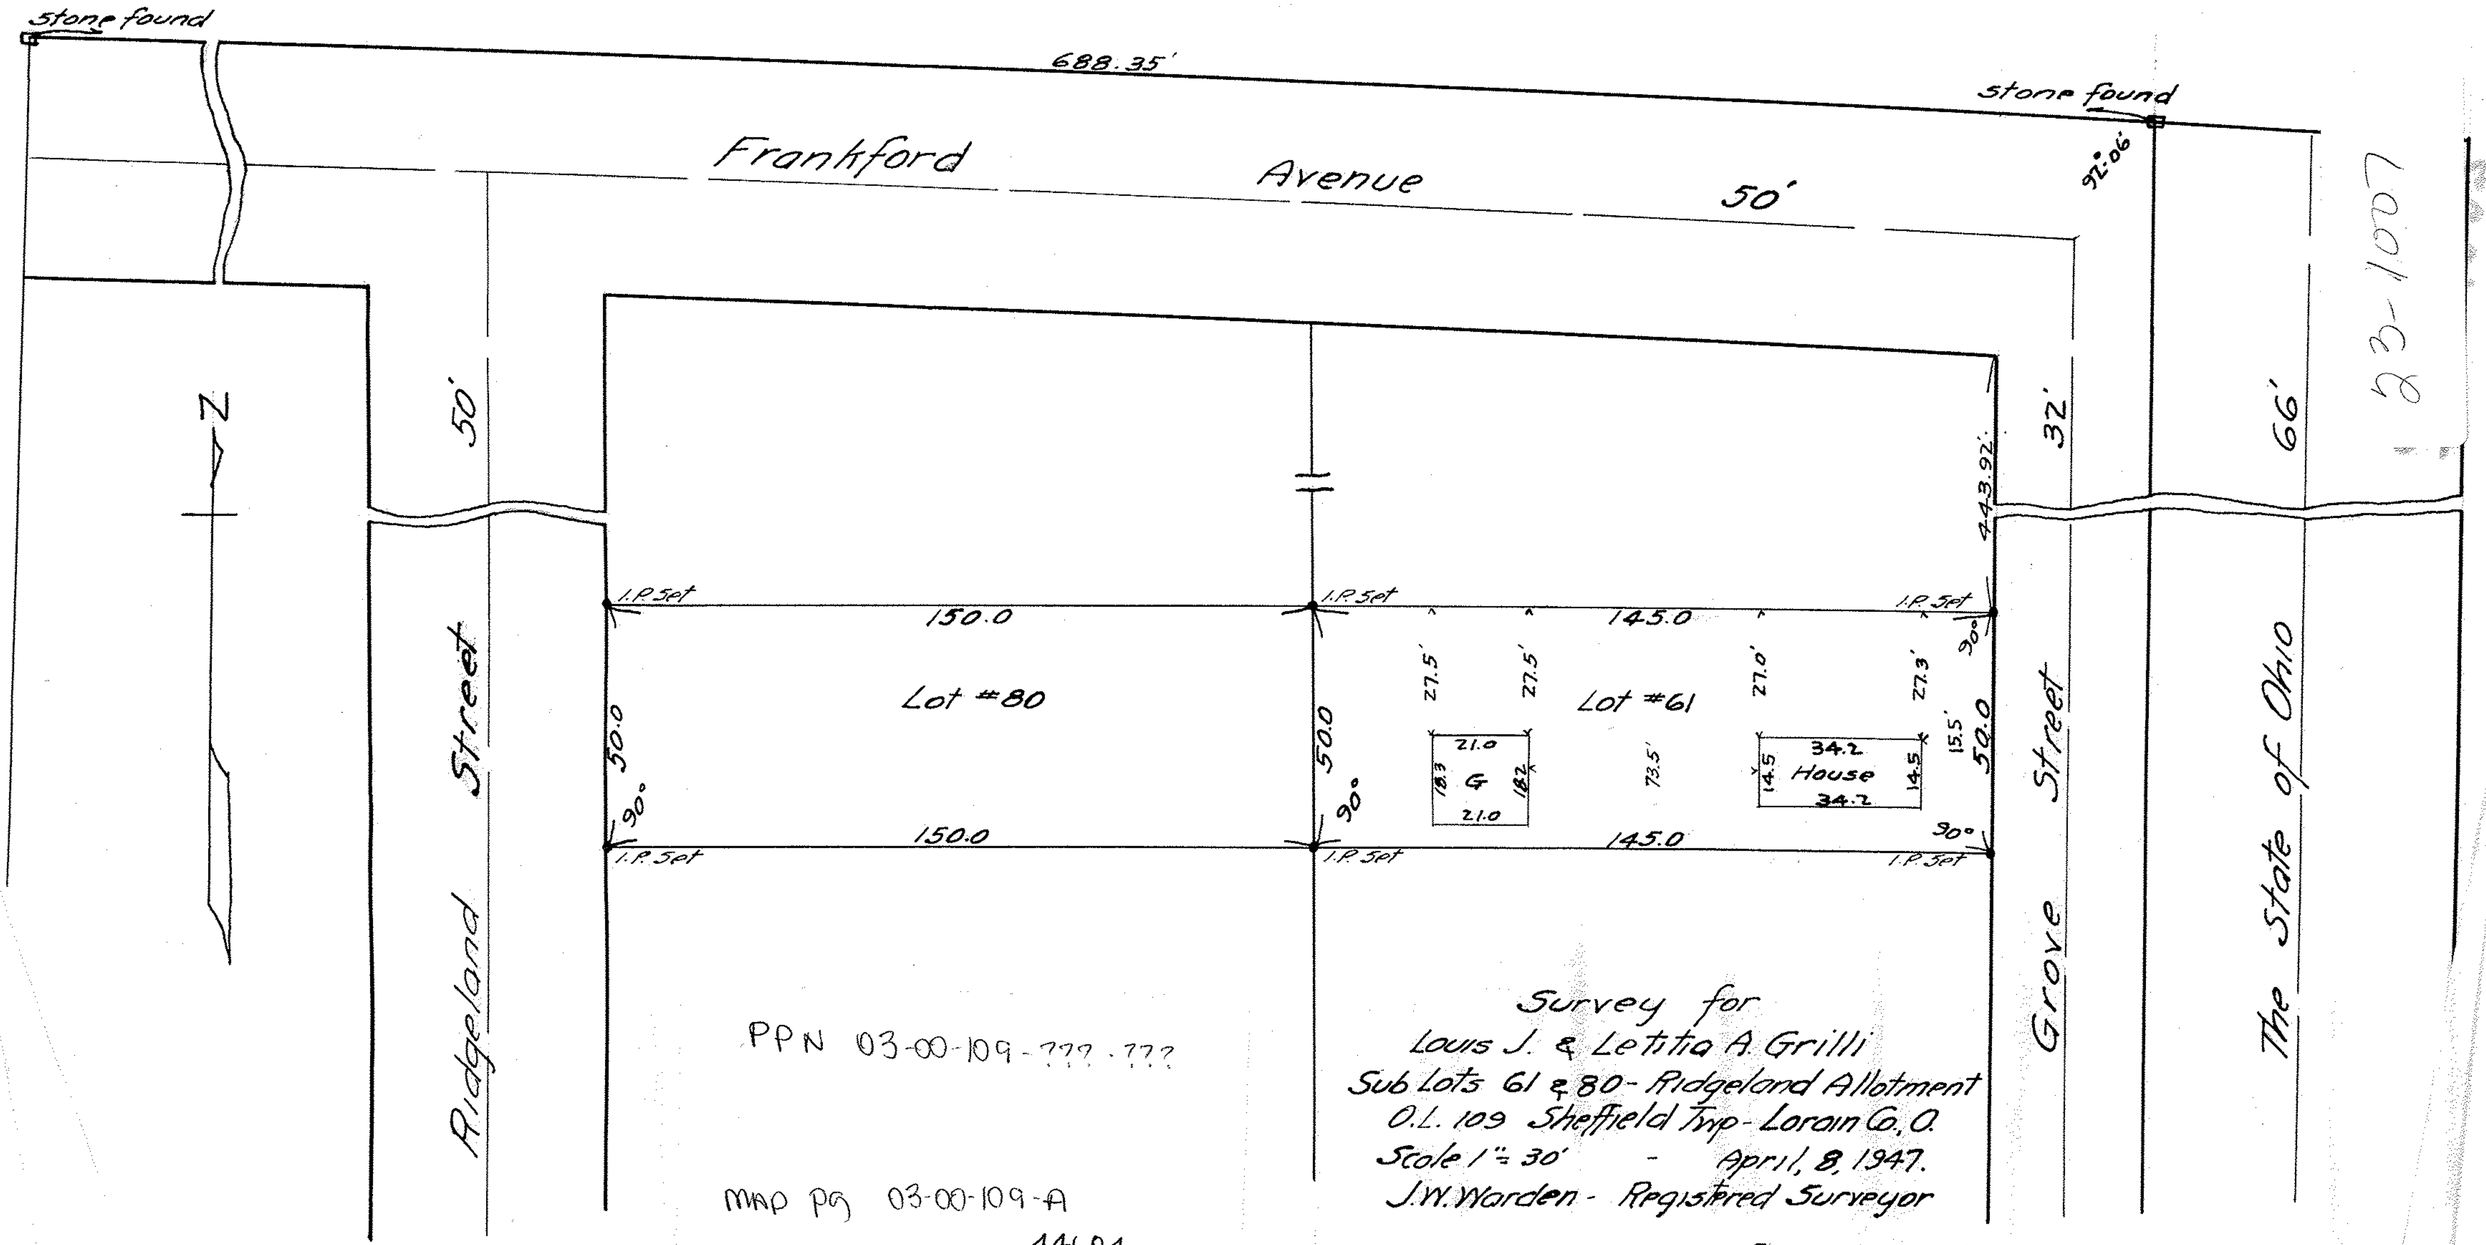
Stone found
688.35'
Stone found
Frankford Avenue
50'
91°06'
Z
50'
Ridgeland Street
32'
66'
443.92'
Grove Street
The State of Ohio
I.P. Set
150.0
Lot #80
50.0
90°
I.P. Set
145.0
Lot #61
27.5'
27.5'
27.0'
27.3'
15.5'
50.0
90°
21.0
18.3
G
18.2
21.0
73.5'
34.2
14.5
House
14.5
34.2
I.P. Set
150.0
I.P. Set
145.0
I.P. Set
PPN 03-00-109-???.???
MAP PG 03-00-109-A
44604
Survey for
Louis J. & Letitia A. Grilli
Sub Lots 61 & 80 - Ridgeland Allotment
O.L. 109 Sheffield Twp - Lorain Co. O.
Scale 1" = 30' - April 8, 1947.
J.W. Warden - Registered Surveyor
Escrow No. 2501.