PPN 04-00-011-102.???

(3)

Survey for
THEODORE M and LAVINA M. DECHANT
D-Vol. 253 Pg. 153 March 8. 1930.
Section 11 Avon Village
Lorain County Ohio
Scale 1" = 40' Feb. 8. 1949.
J. W. Warden. Registered Surveyor.
Revised June 9 1951.

MAP PG 04-00-011-C

44606

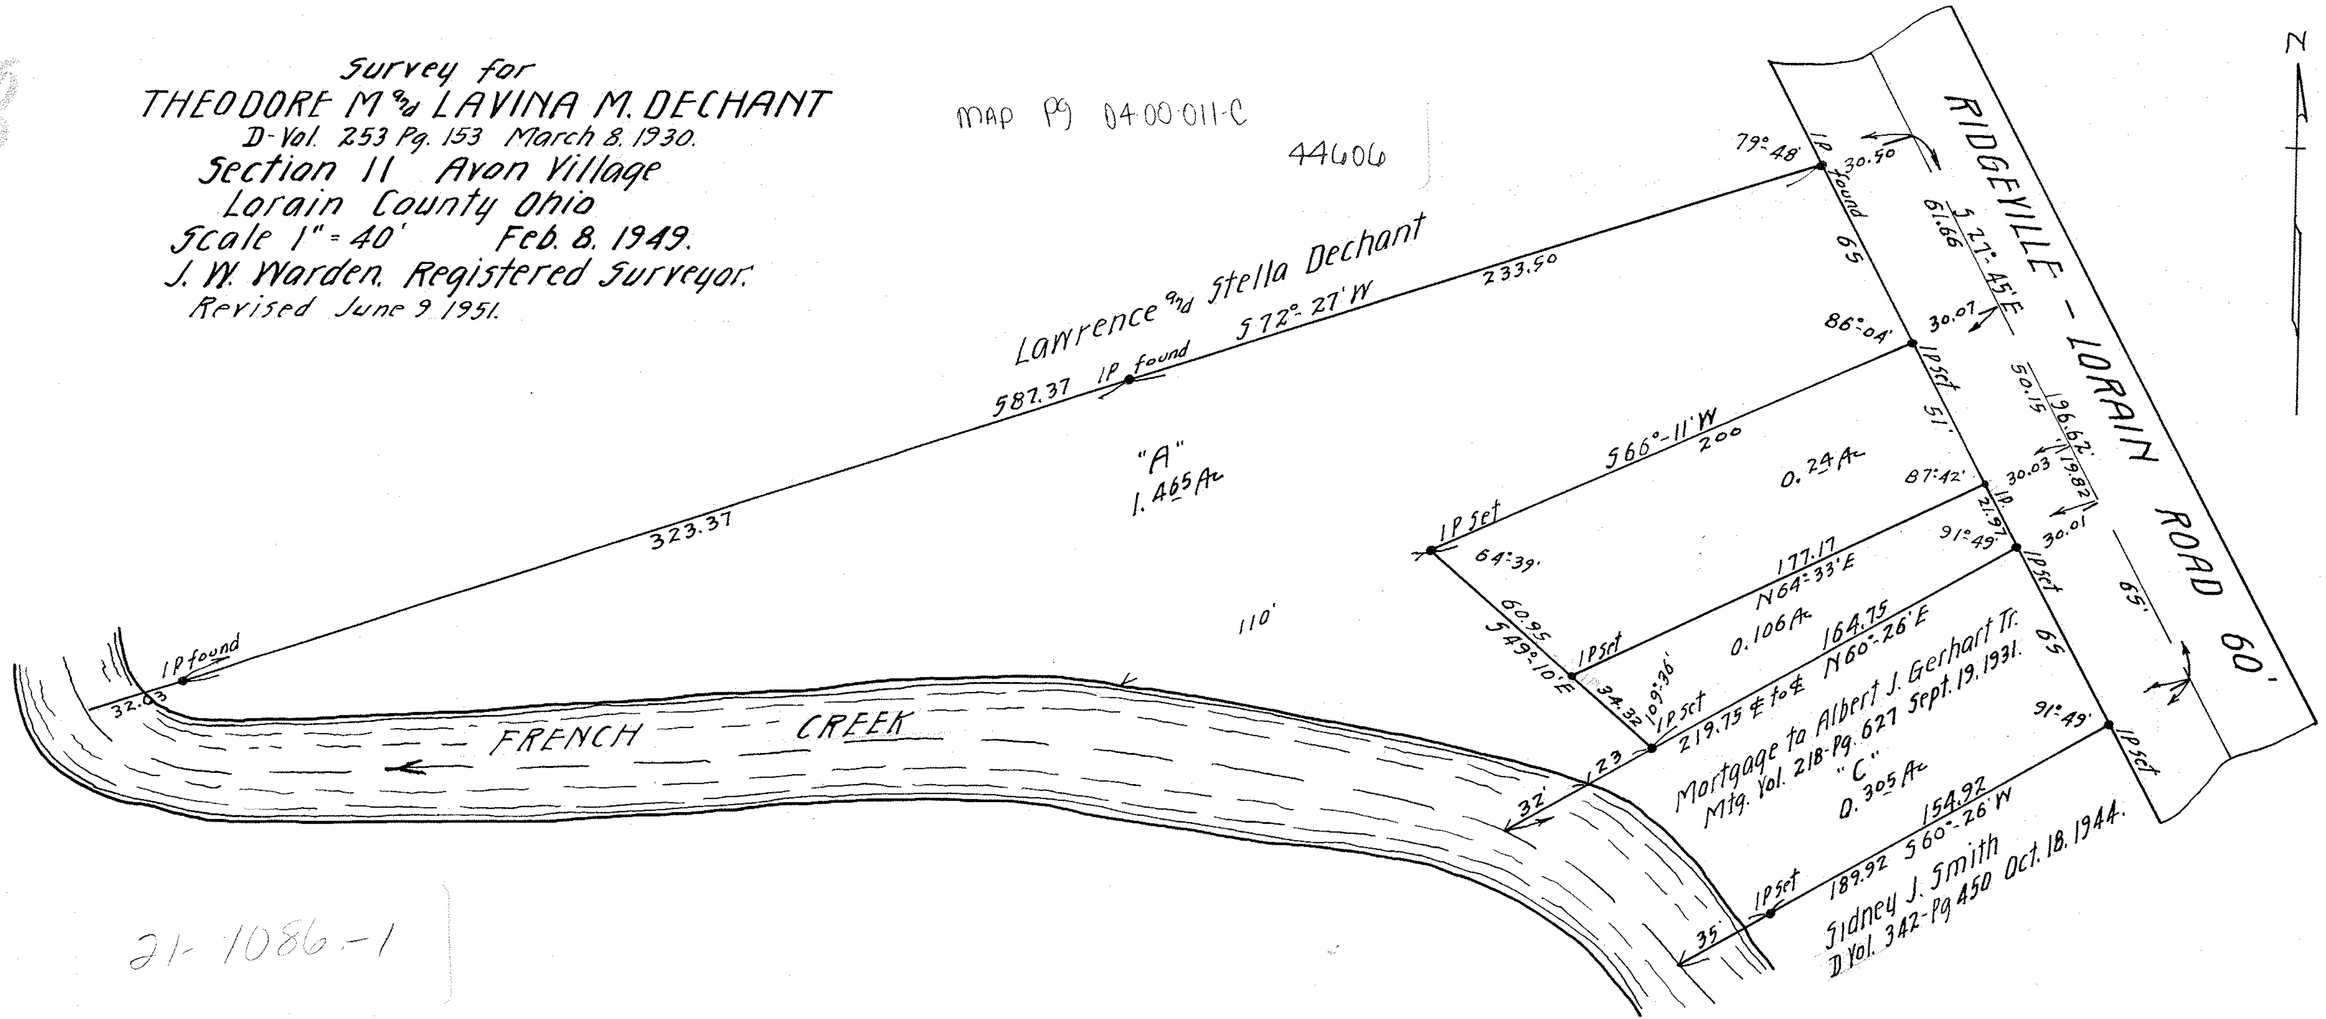

21-1086-1

D.A.