21-1335

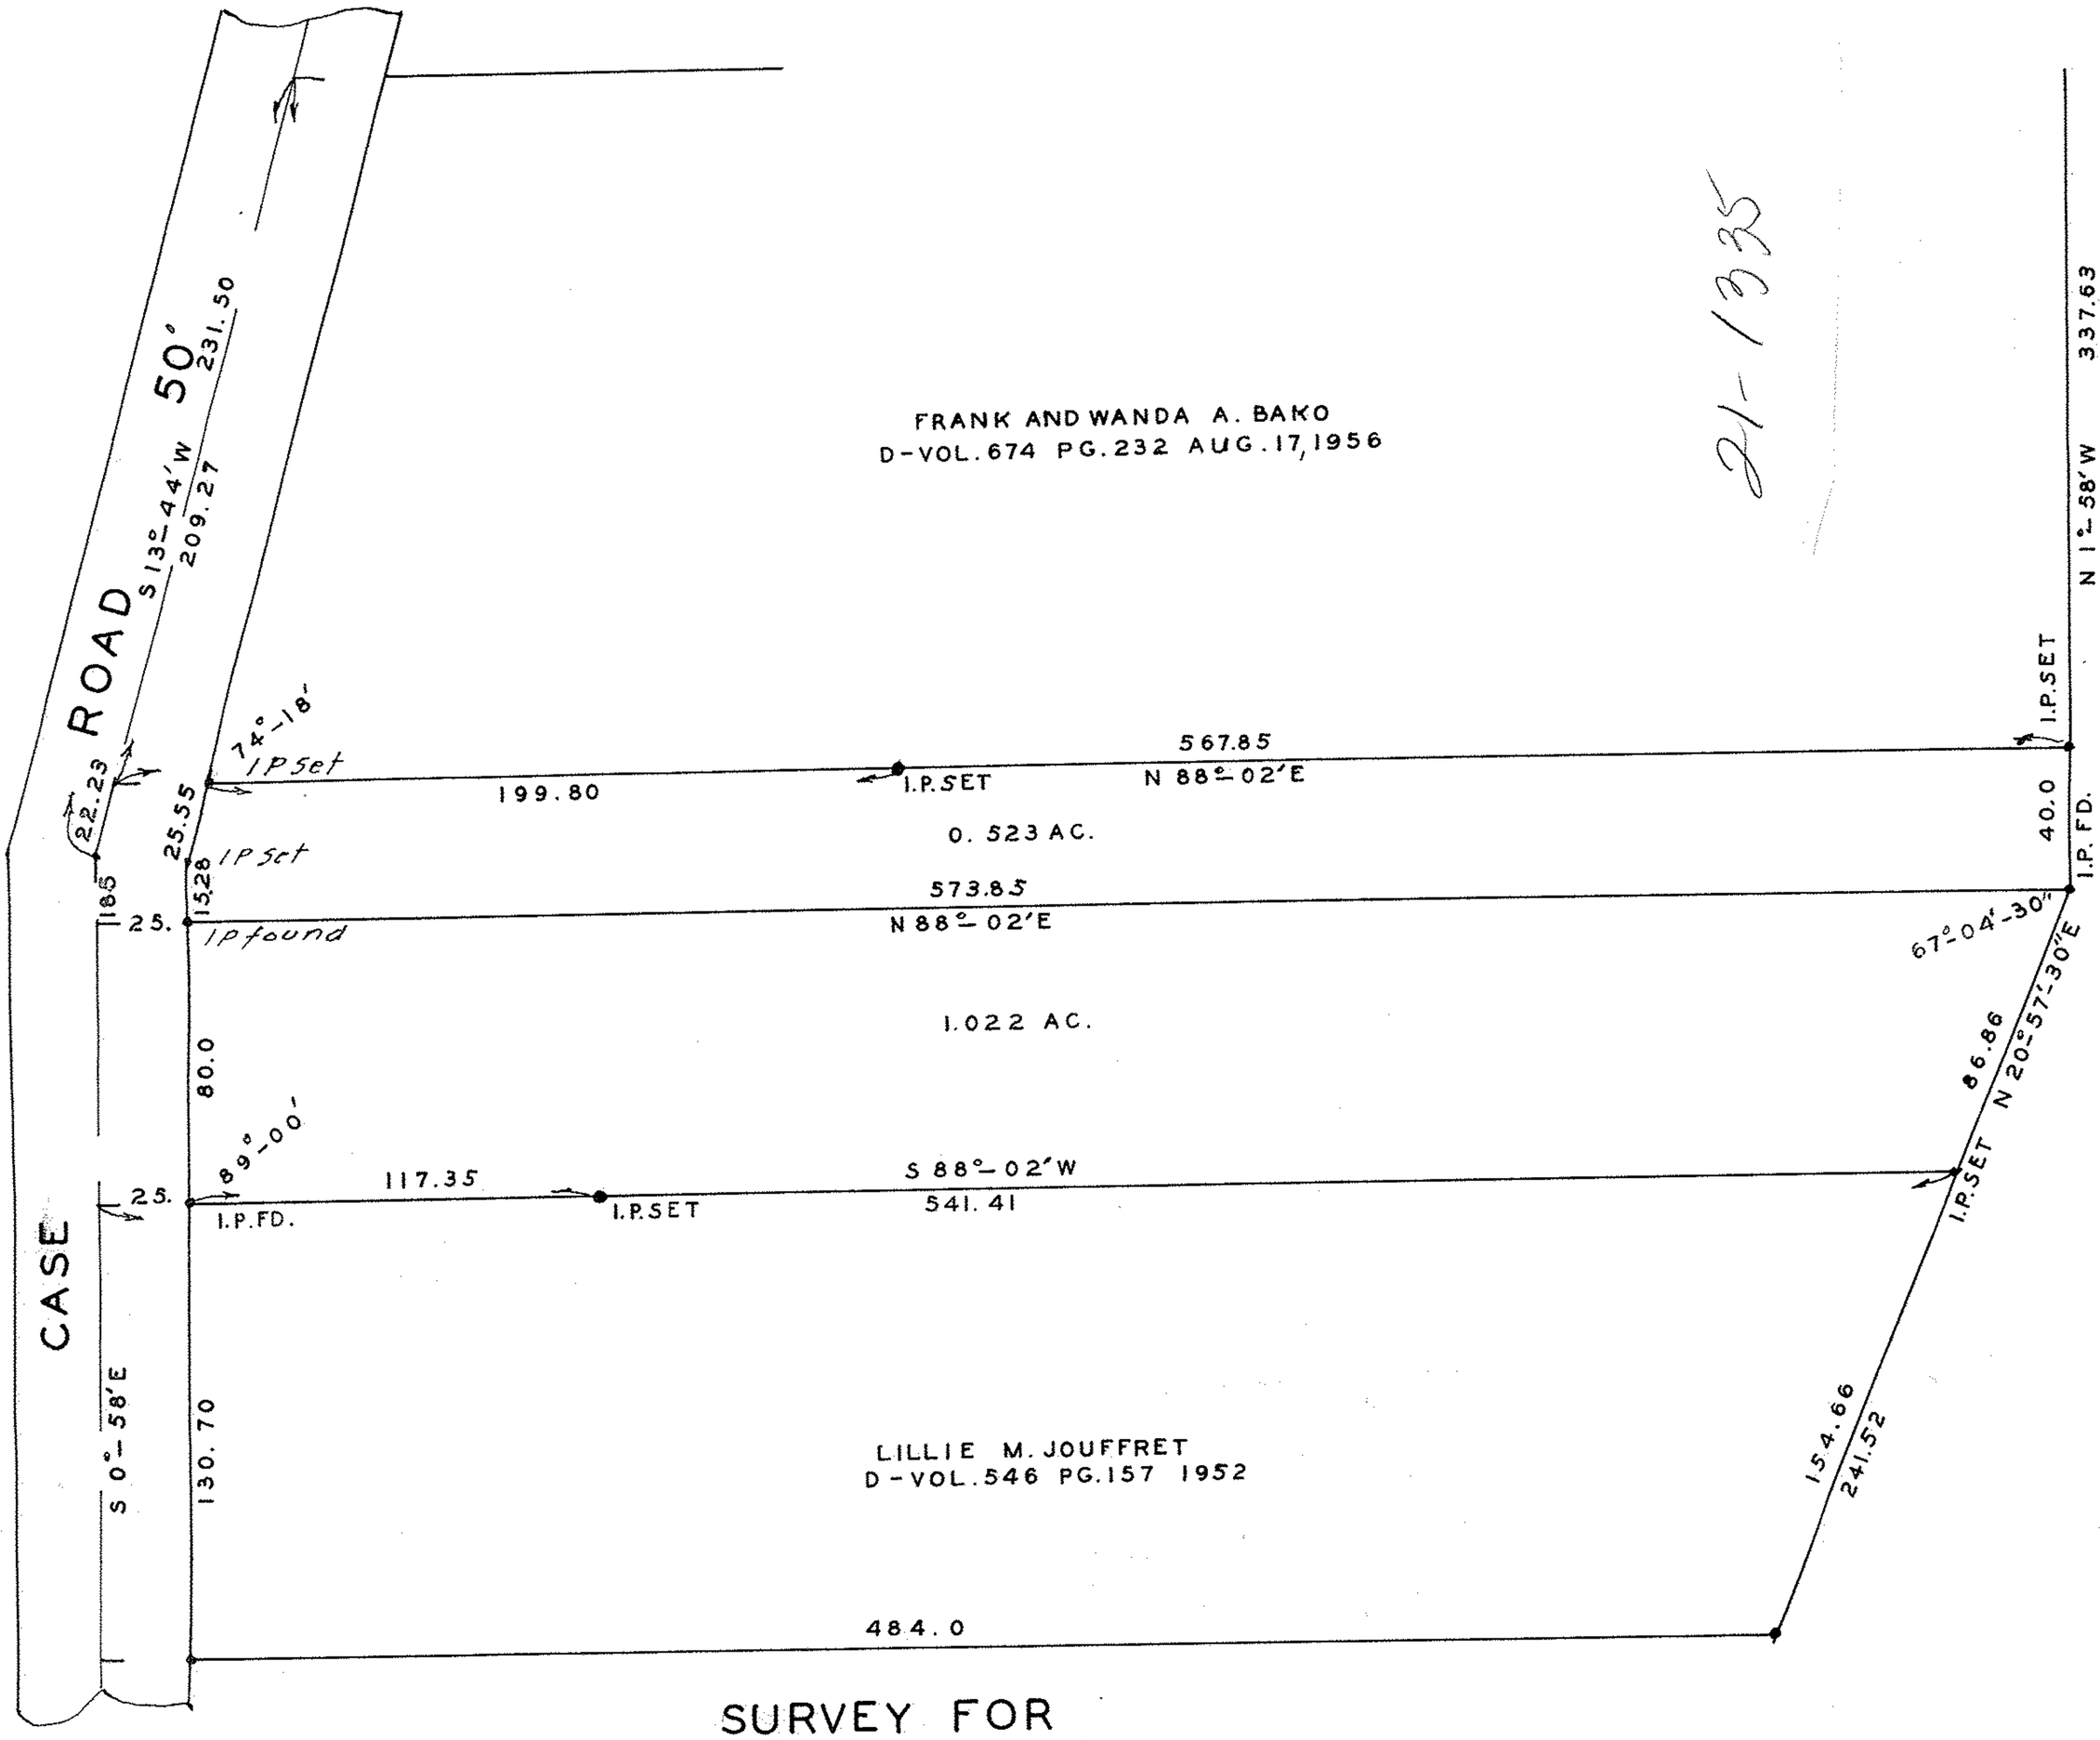

SURVEY FOR
LILLIE M. JOUFFRET
AND
FRANK AND WANDA A. BAKO

LOT 45 RIDGEVILLE TOWNSHIP

SCALE 1" = 50' MAY 4, 1960

J.W. WARDEN AND ASSOCIATES REG. SURVEYORS

PPN 07-00-045-110-???

MAP PG 07-00-045-B

44609

21-1335