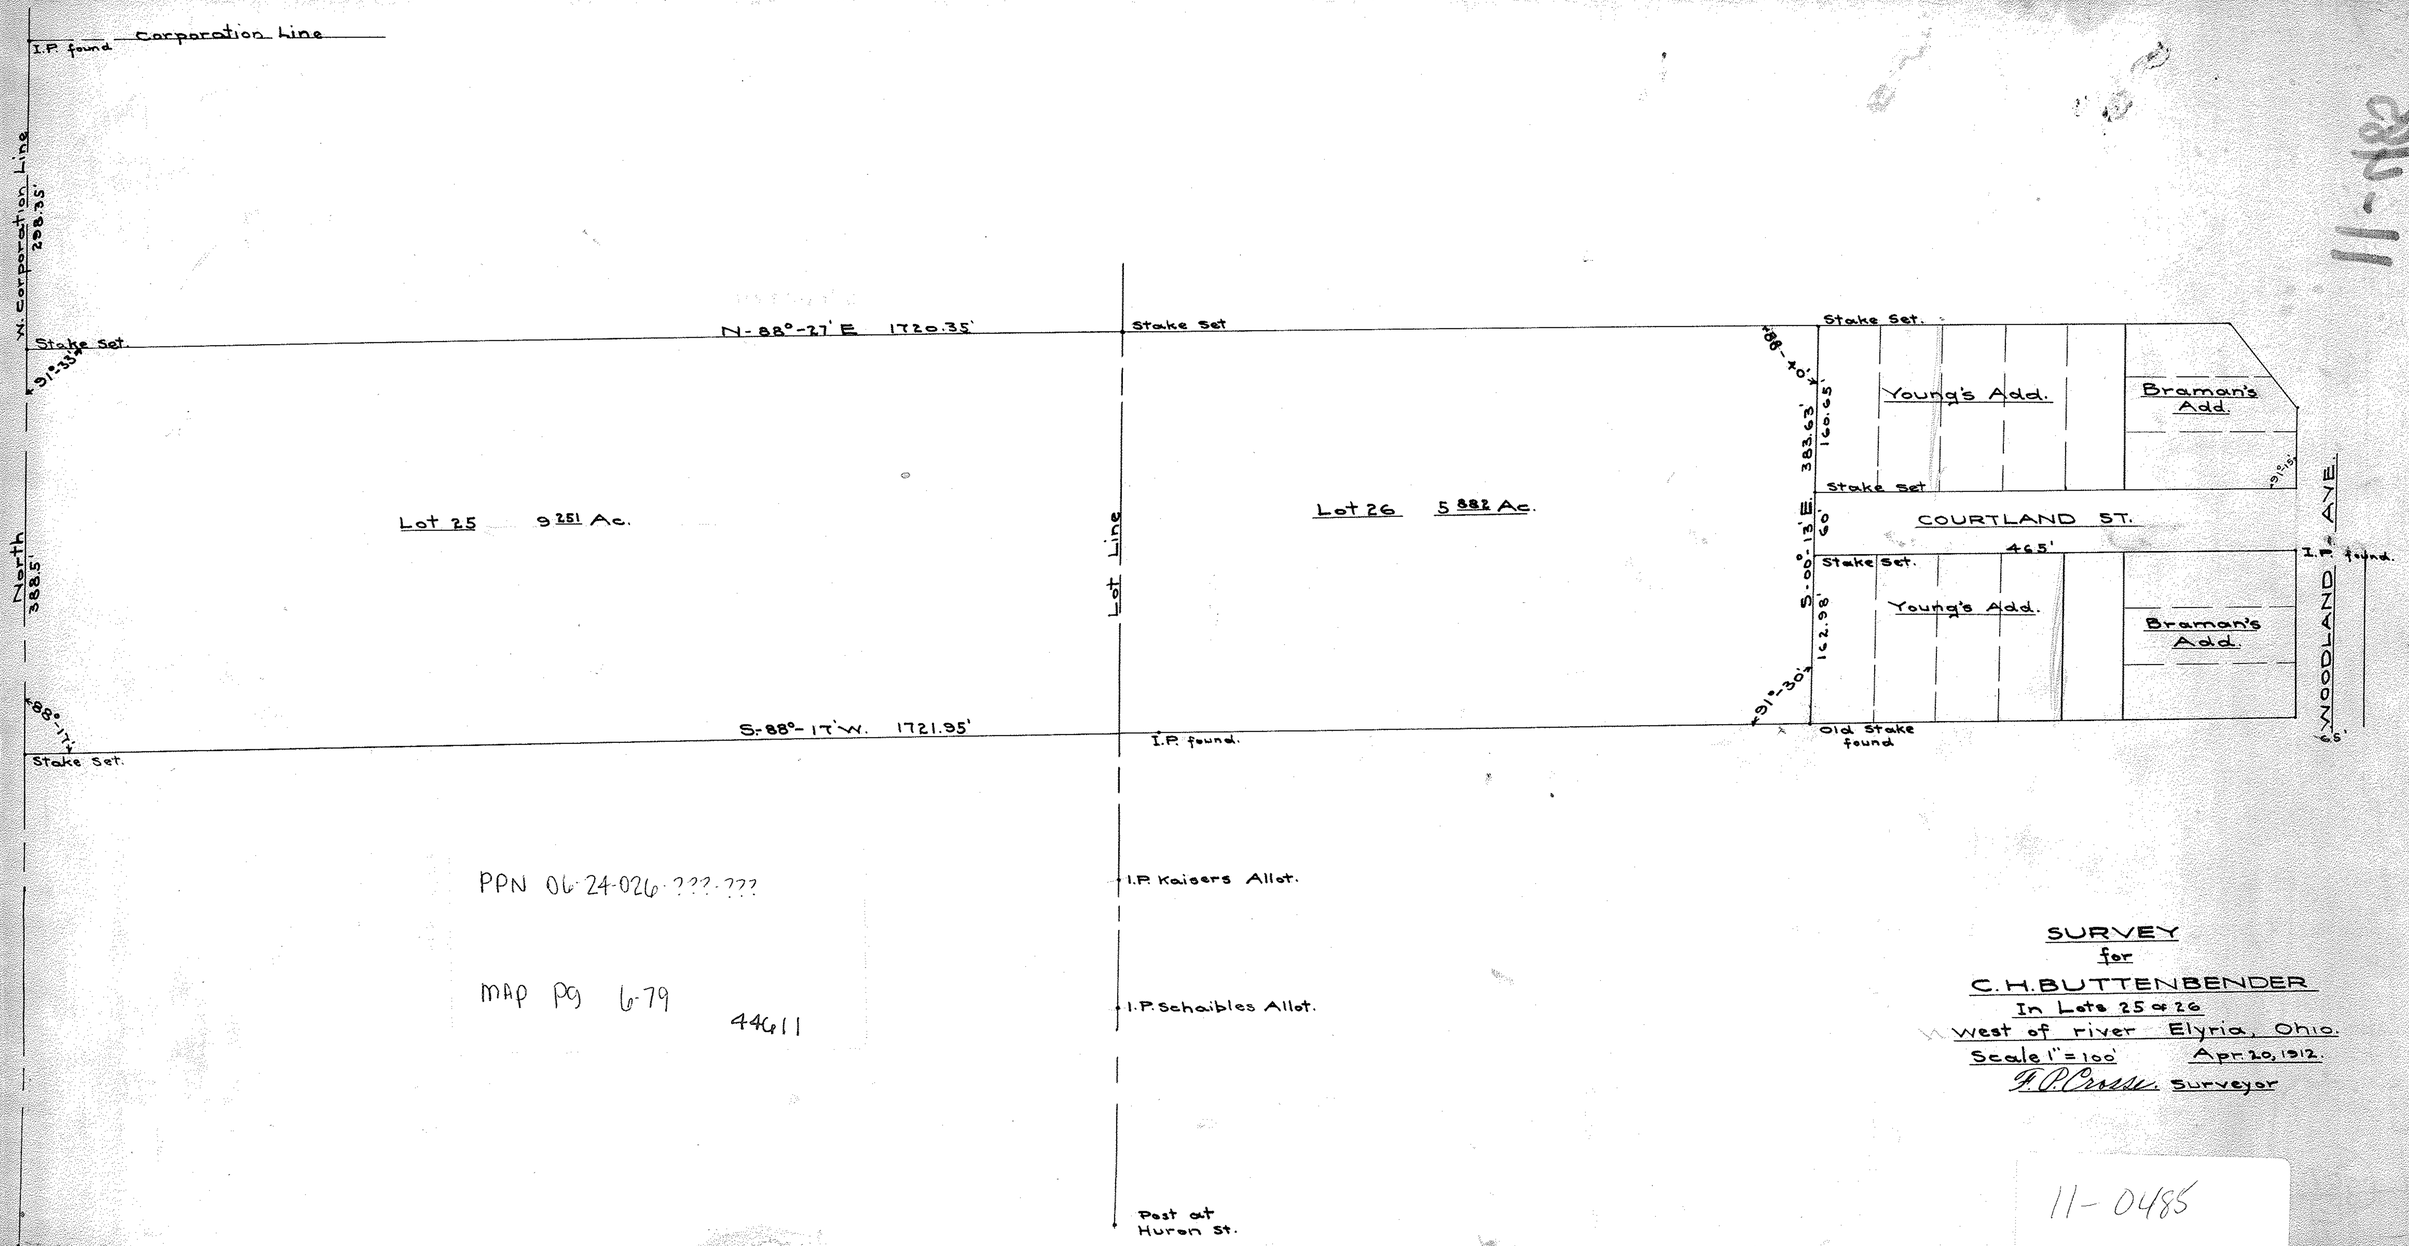

SURVEY
for
C.H. BUTTENBENDER
In Lots 25 & 26
West of river Elyria, Ohio.
Scale 1" = 100' Apr. 20, 1912.
F.P. Cross. Surveyor

11-0485