


23-1099

3

Lois A. Henes D-Vol. 326-Pg. 376 March 1, 1943.

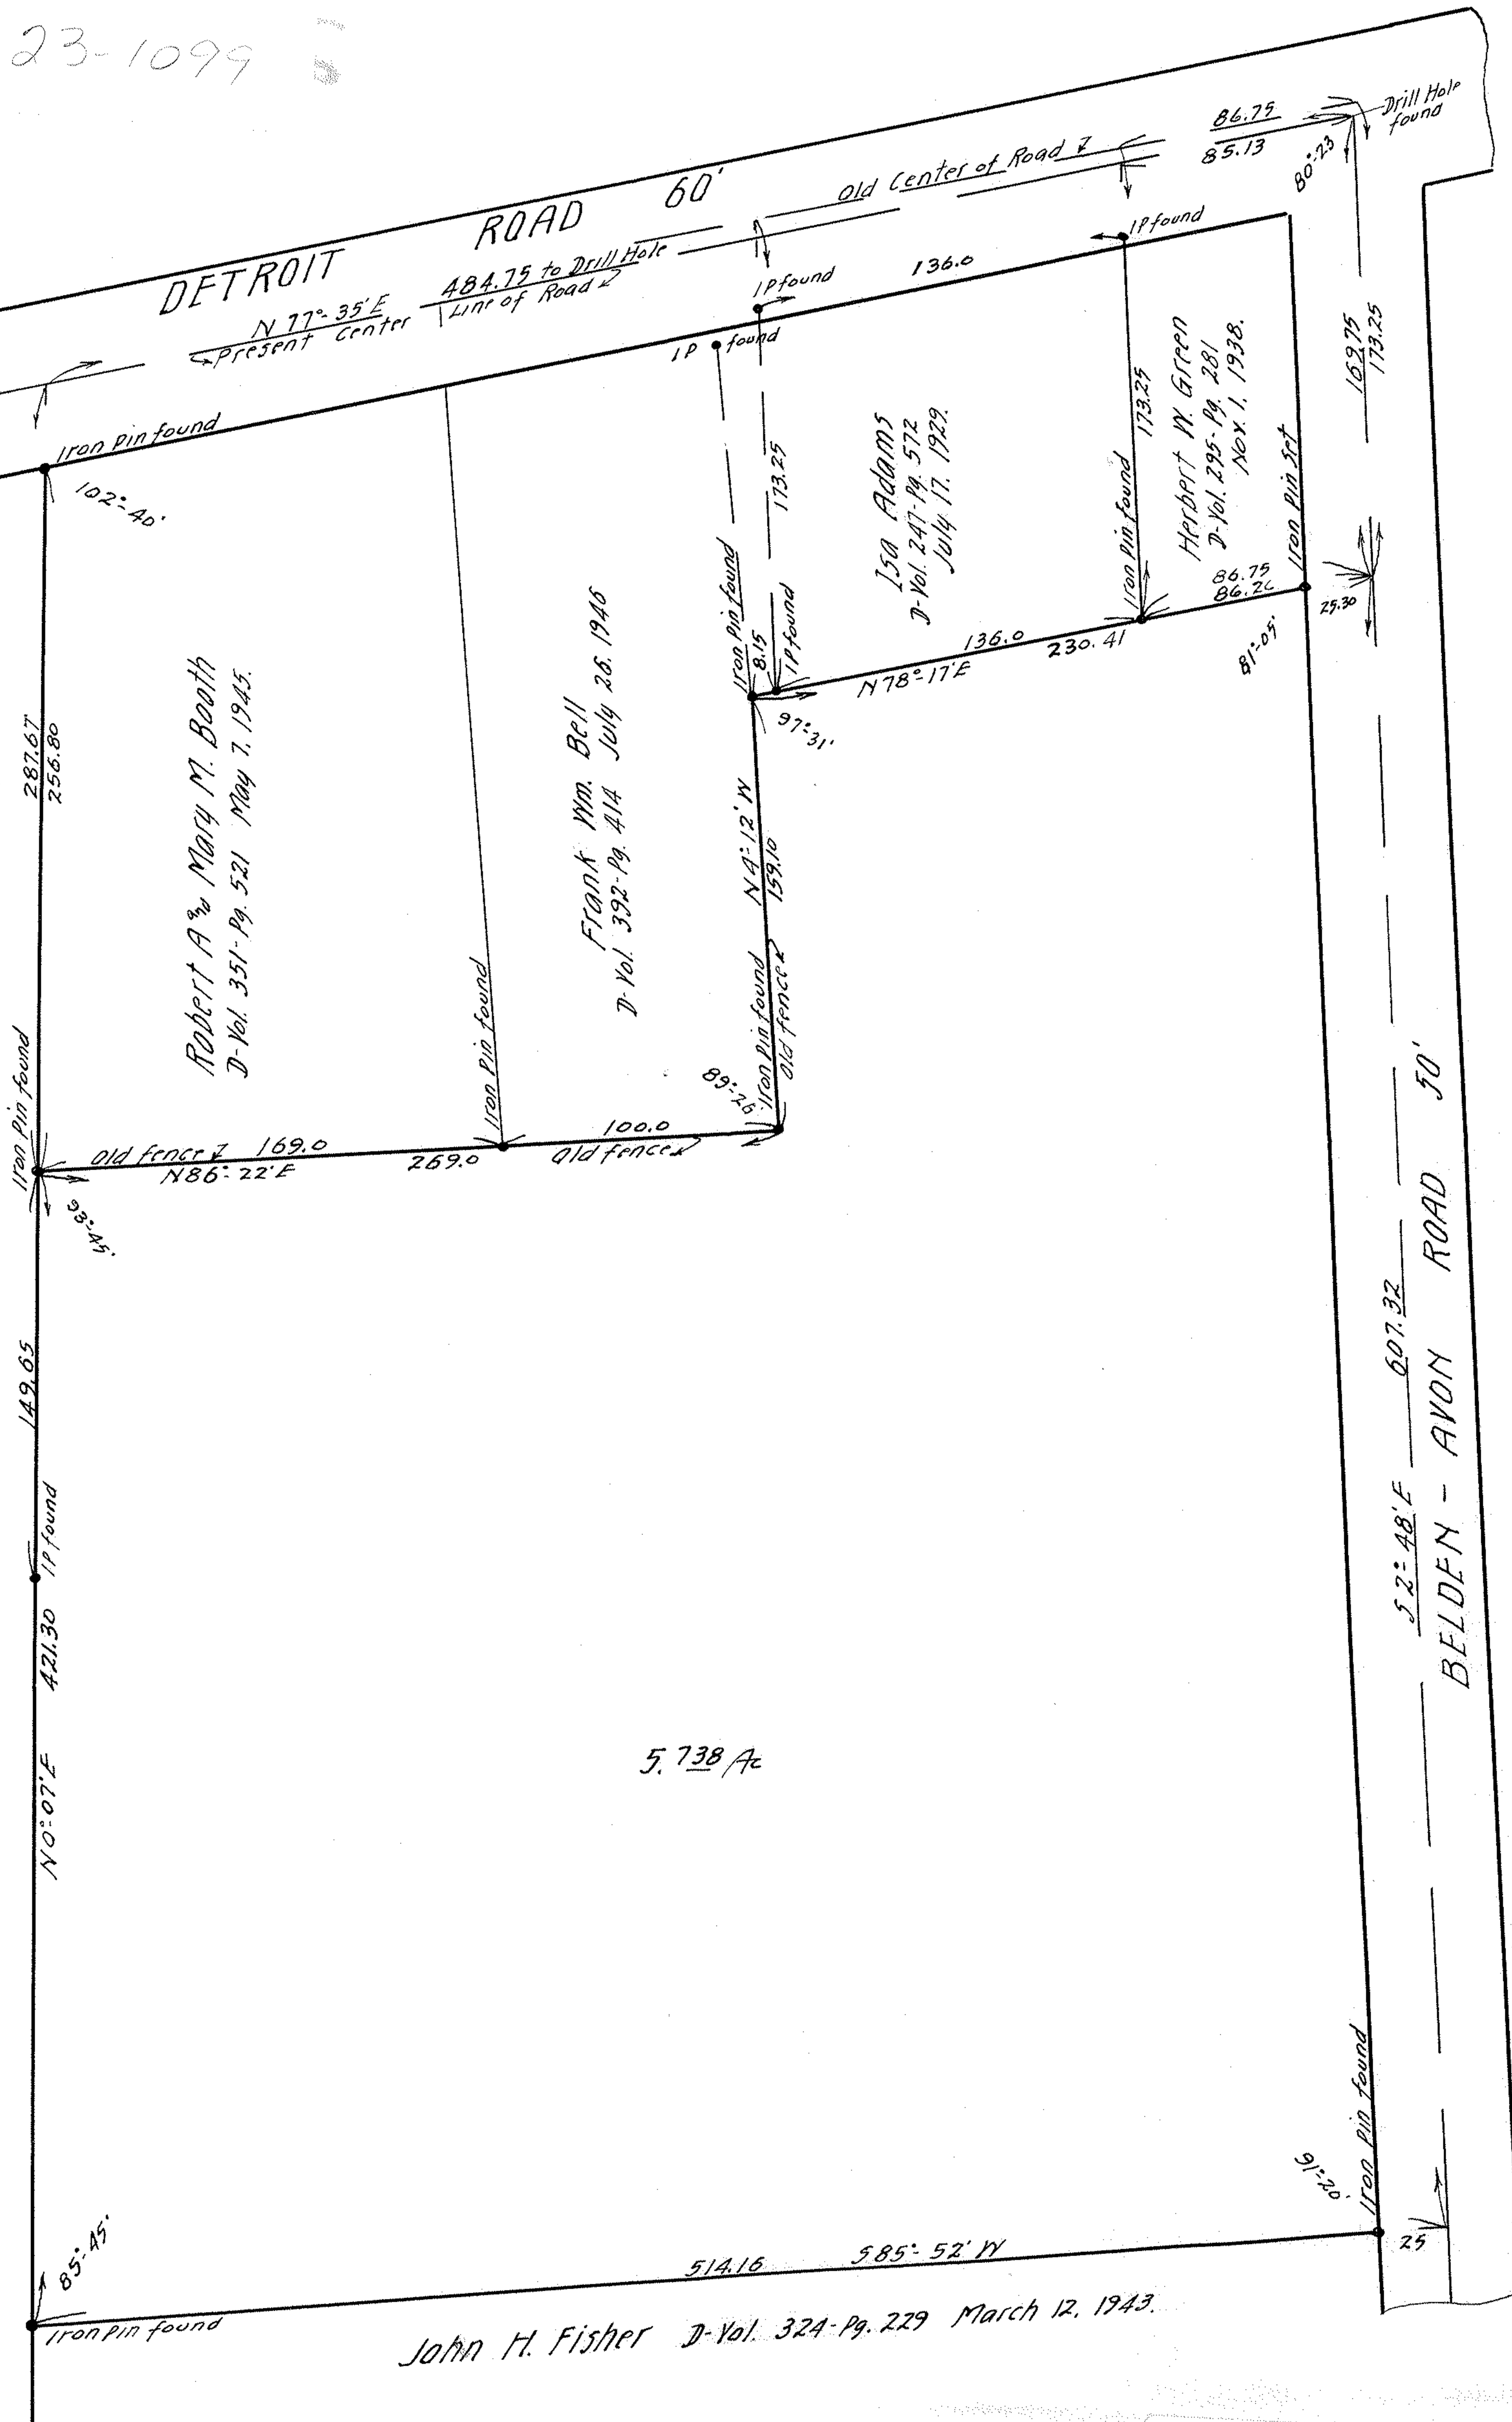

Robert A & Mary M. Booth
D-Vol. 351-Pg. 521 May 7, 1945.

FRANK Wm. Bell
D-Vol. 392-Pg. 414 July 28, 1946

Isa Adams
D-Vol. 247-Pg. 572
July 17, 1929.

HERBERT W. GREEN
D-Vol. 295-Pg. 281
Nov. 1, 1938.

5.738 Ac

John H. Fisher D-Vol. 324-Pg. 229 March 12, 1943.

Survey for
GEORGE B & GWENDOLYN KNIGHT
 D-Vol. 464-Pg. 380 May 18, 1949.
 Section 15 Avon Village
 Lorain County Ohio.
 Scale 1" = 50' Oct. 24, 1949.
 J. W. Warden, Registered Surveyor.

PPN 04-00-015-109-???

MAP Pg. 04-00-015-B

44614