


Survey for Margaret & August Brandt  
 Lot 20 Rossbach-Freese & Sipple Addn & part of O.L. 23  
 Amherst Twnip & Village Lorain Co. Ohio.  
 Scale 1"=50' Warden & Laundon. Civil Engr's.

4-9-1929

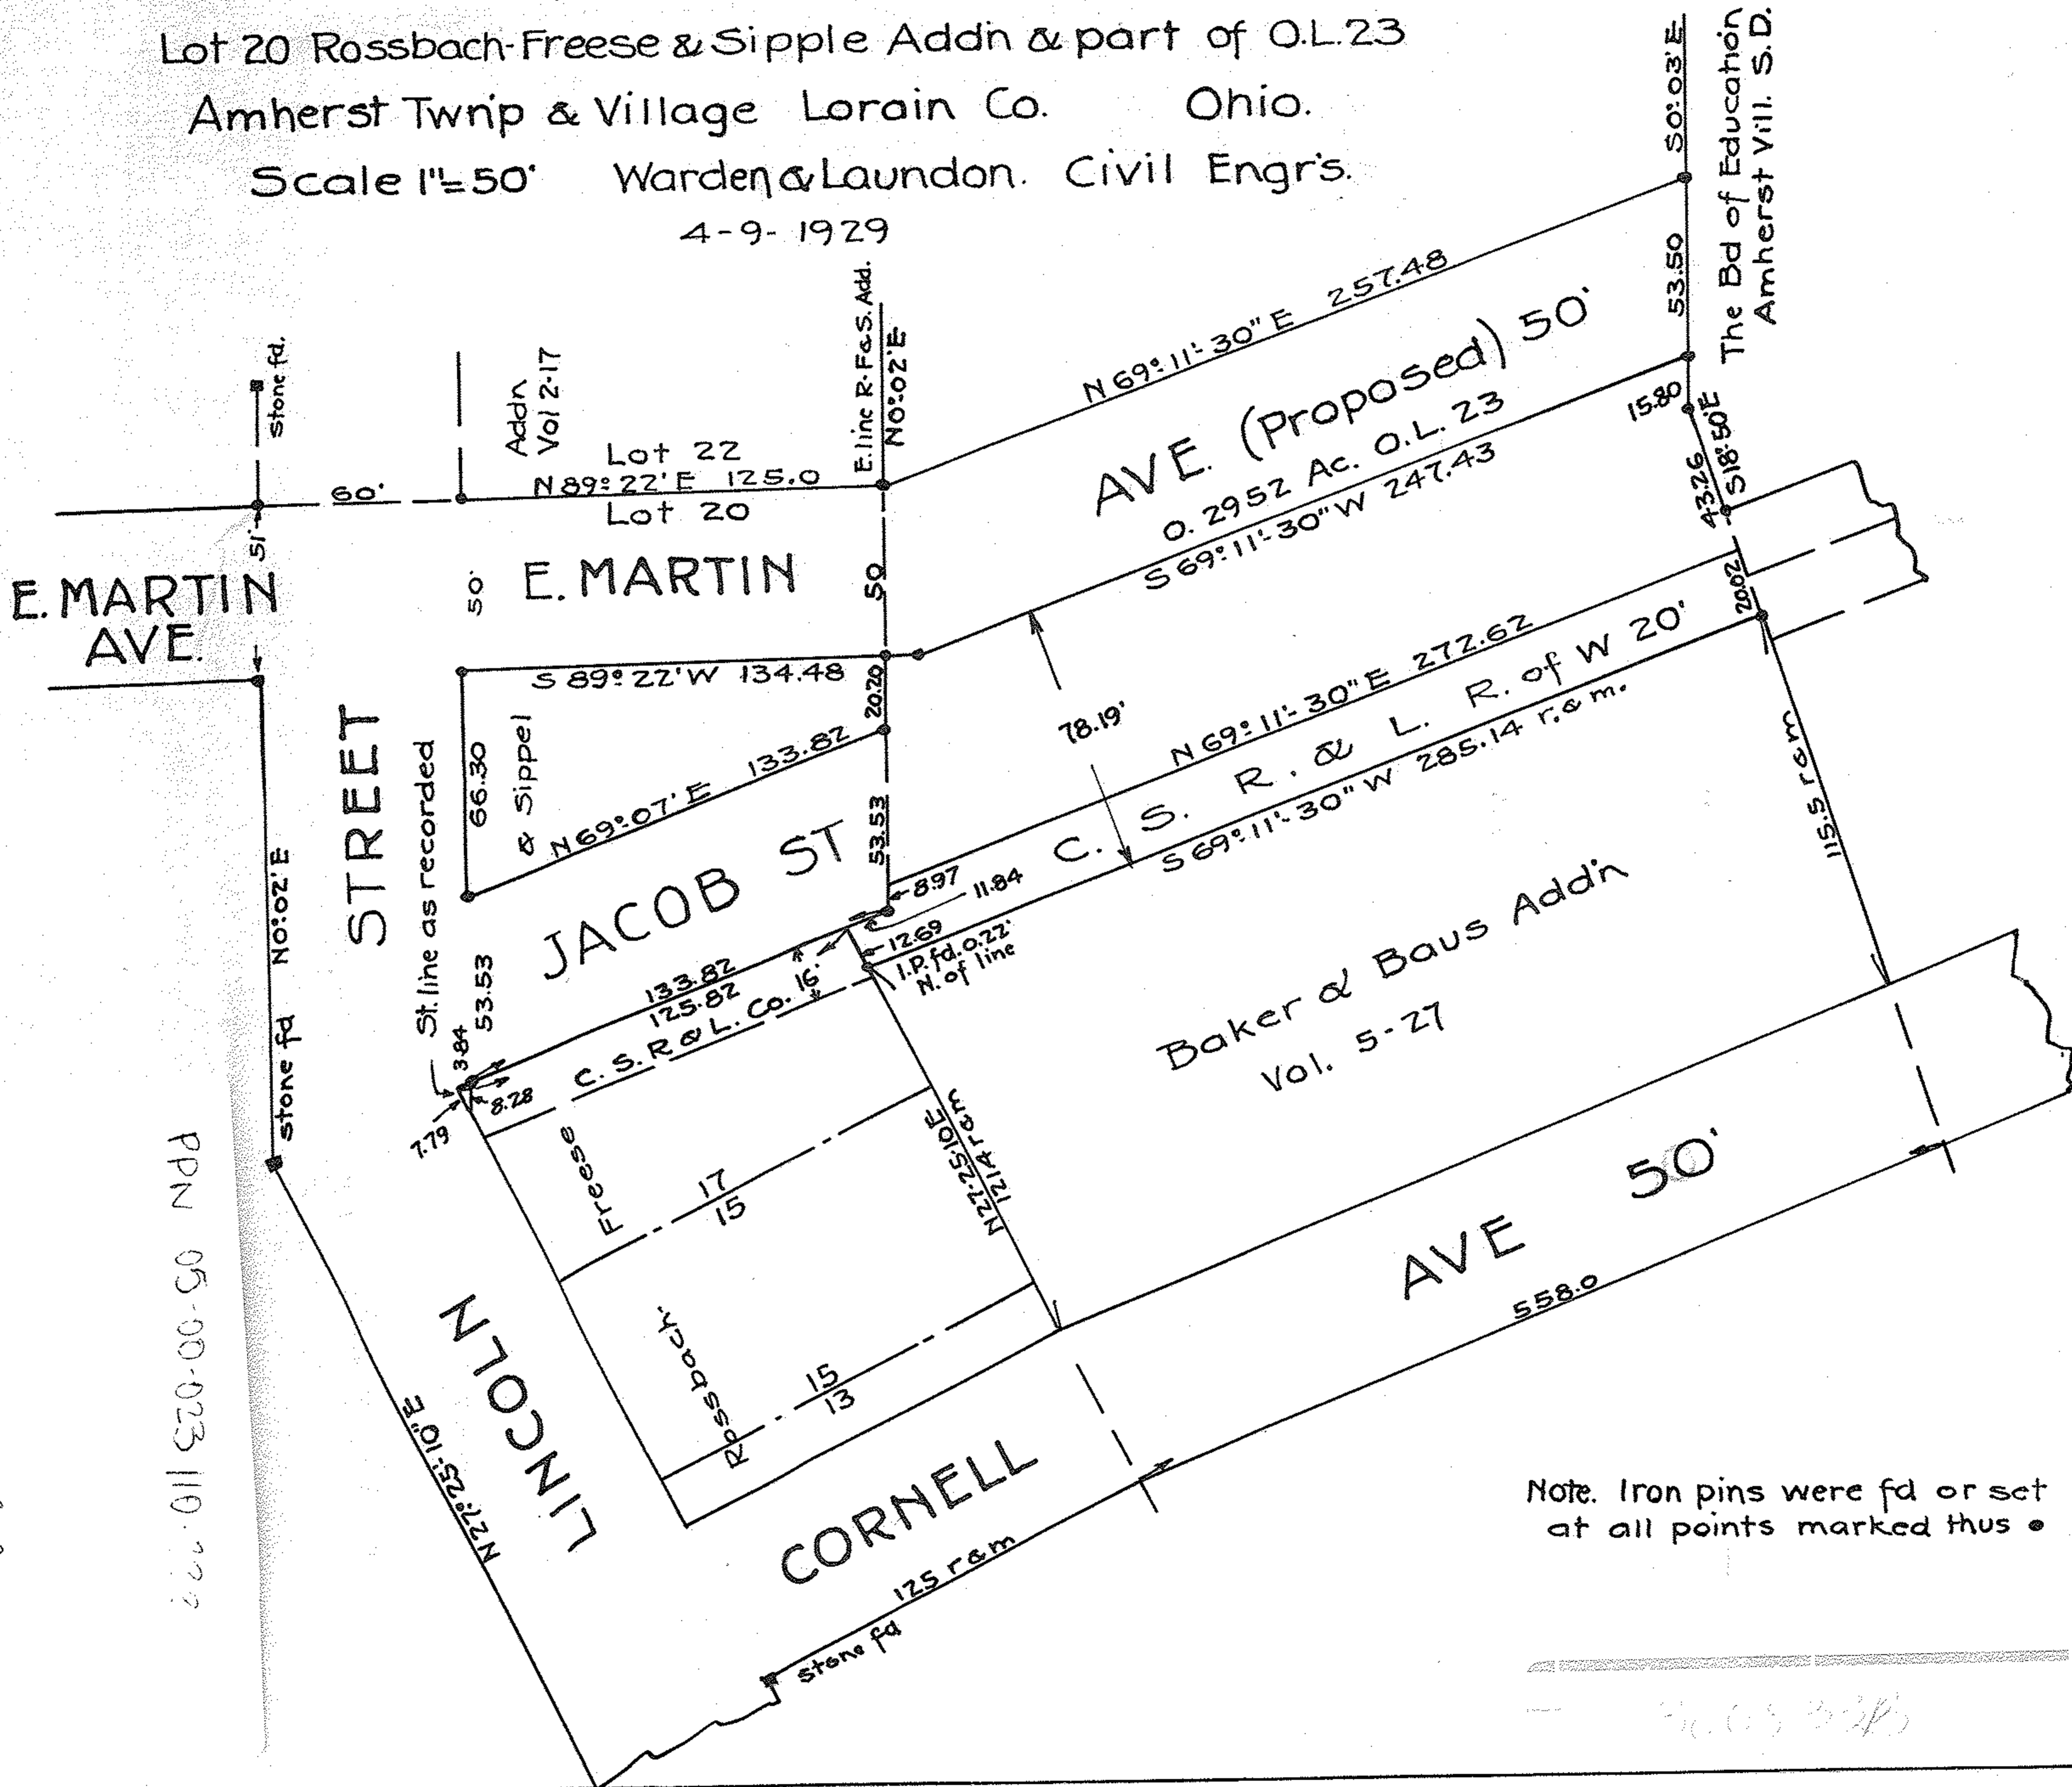

MAP PG 05-00-023-A 44025

PPN 05-00-023 110.772

Note. Iron pins were fd or set at all points marked thus •

30.05.328