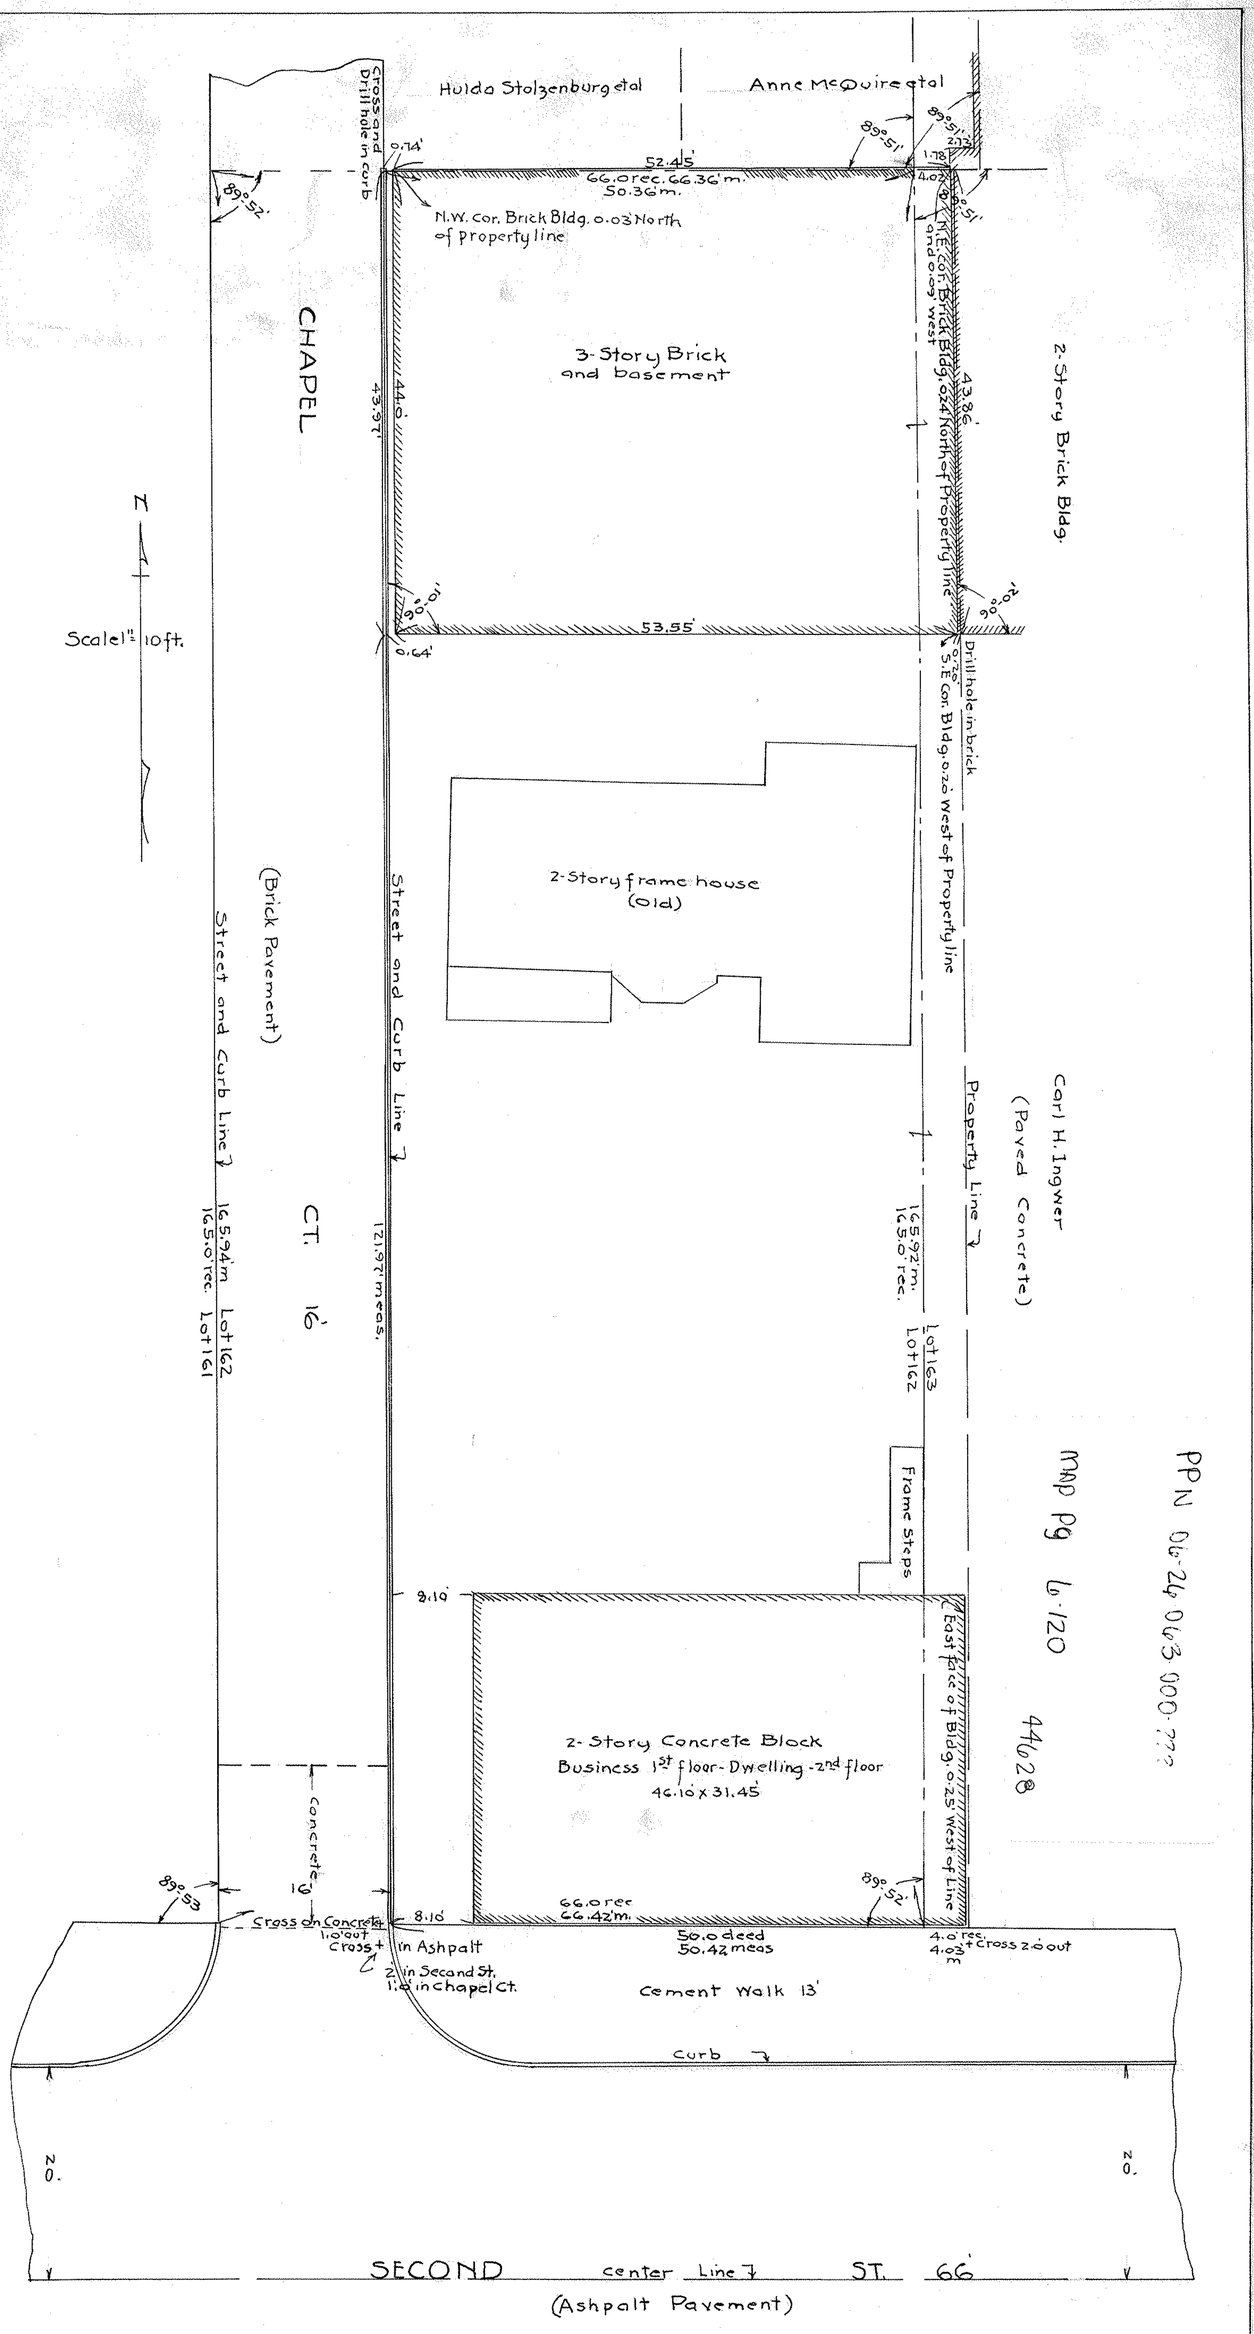

Survey for

HARVEY T. WINCKLES.

Lots 162-163-Block-63-Original Village Plat of Elyria,

Map Vol-3-Page-14,

Elyria - Lorain County - Ohio.

January 18-1941. J. W. Warden, Registered Surveyor.

300875B