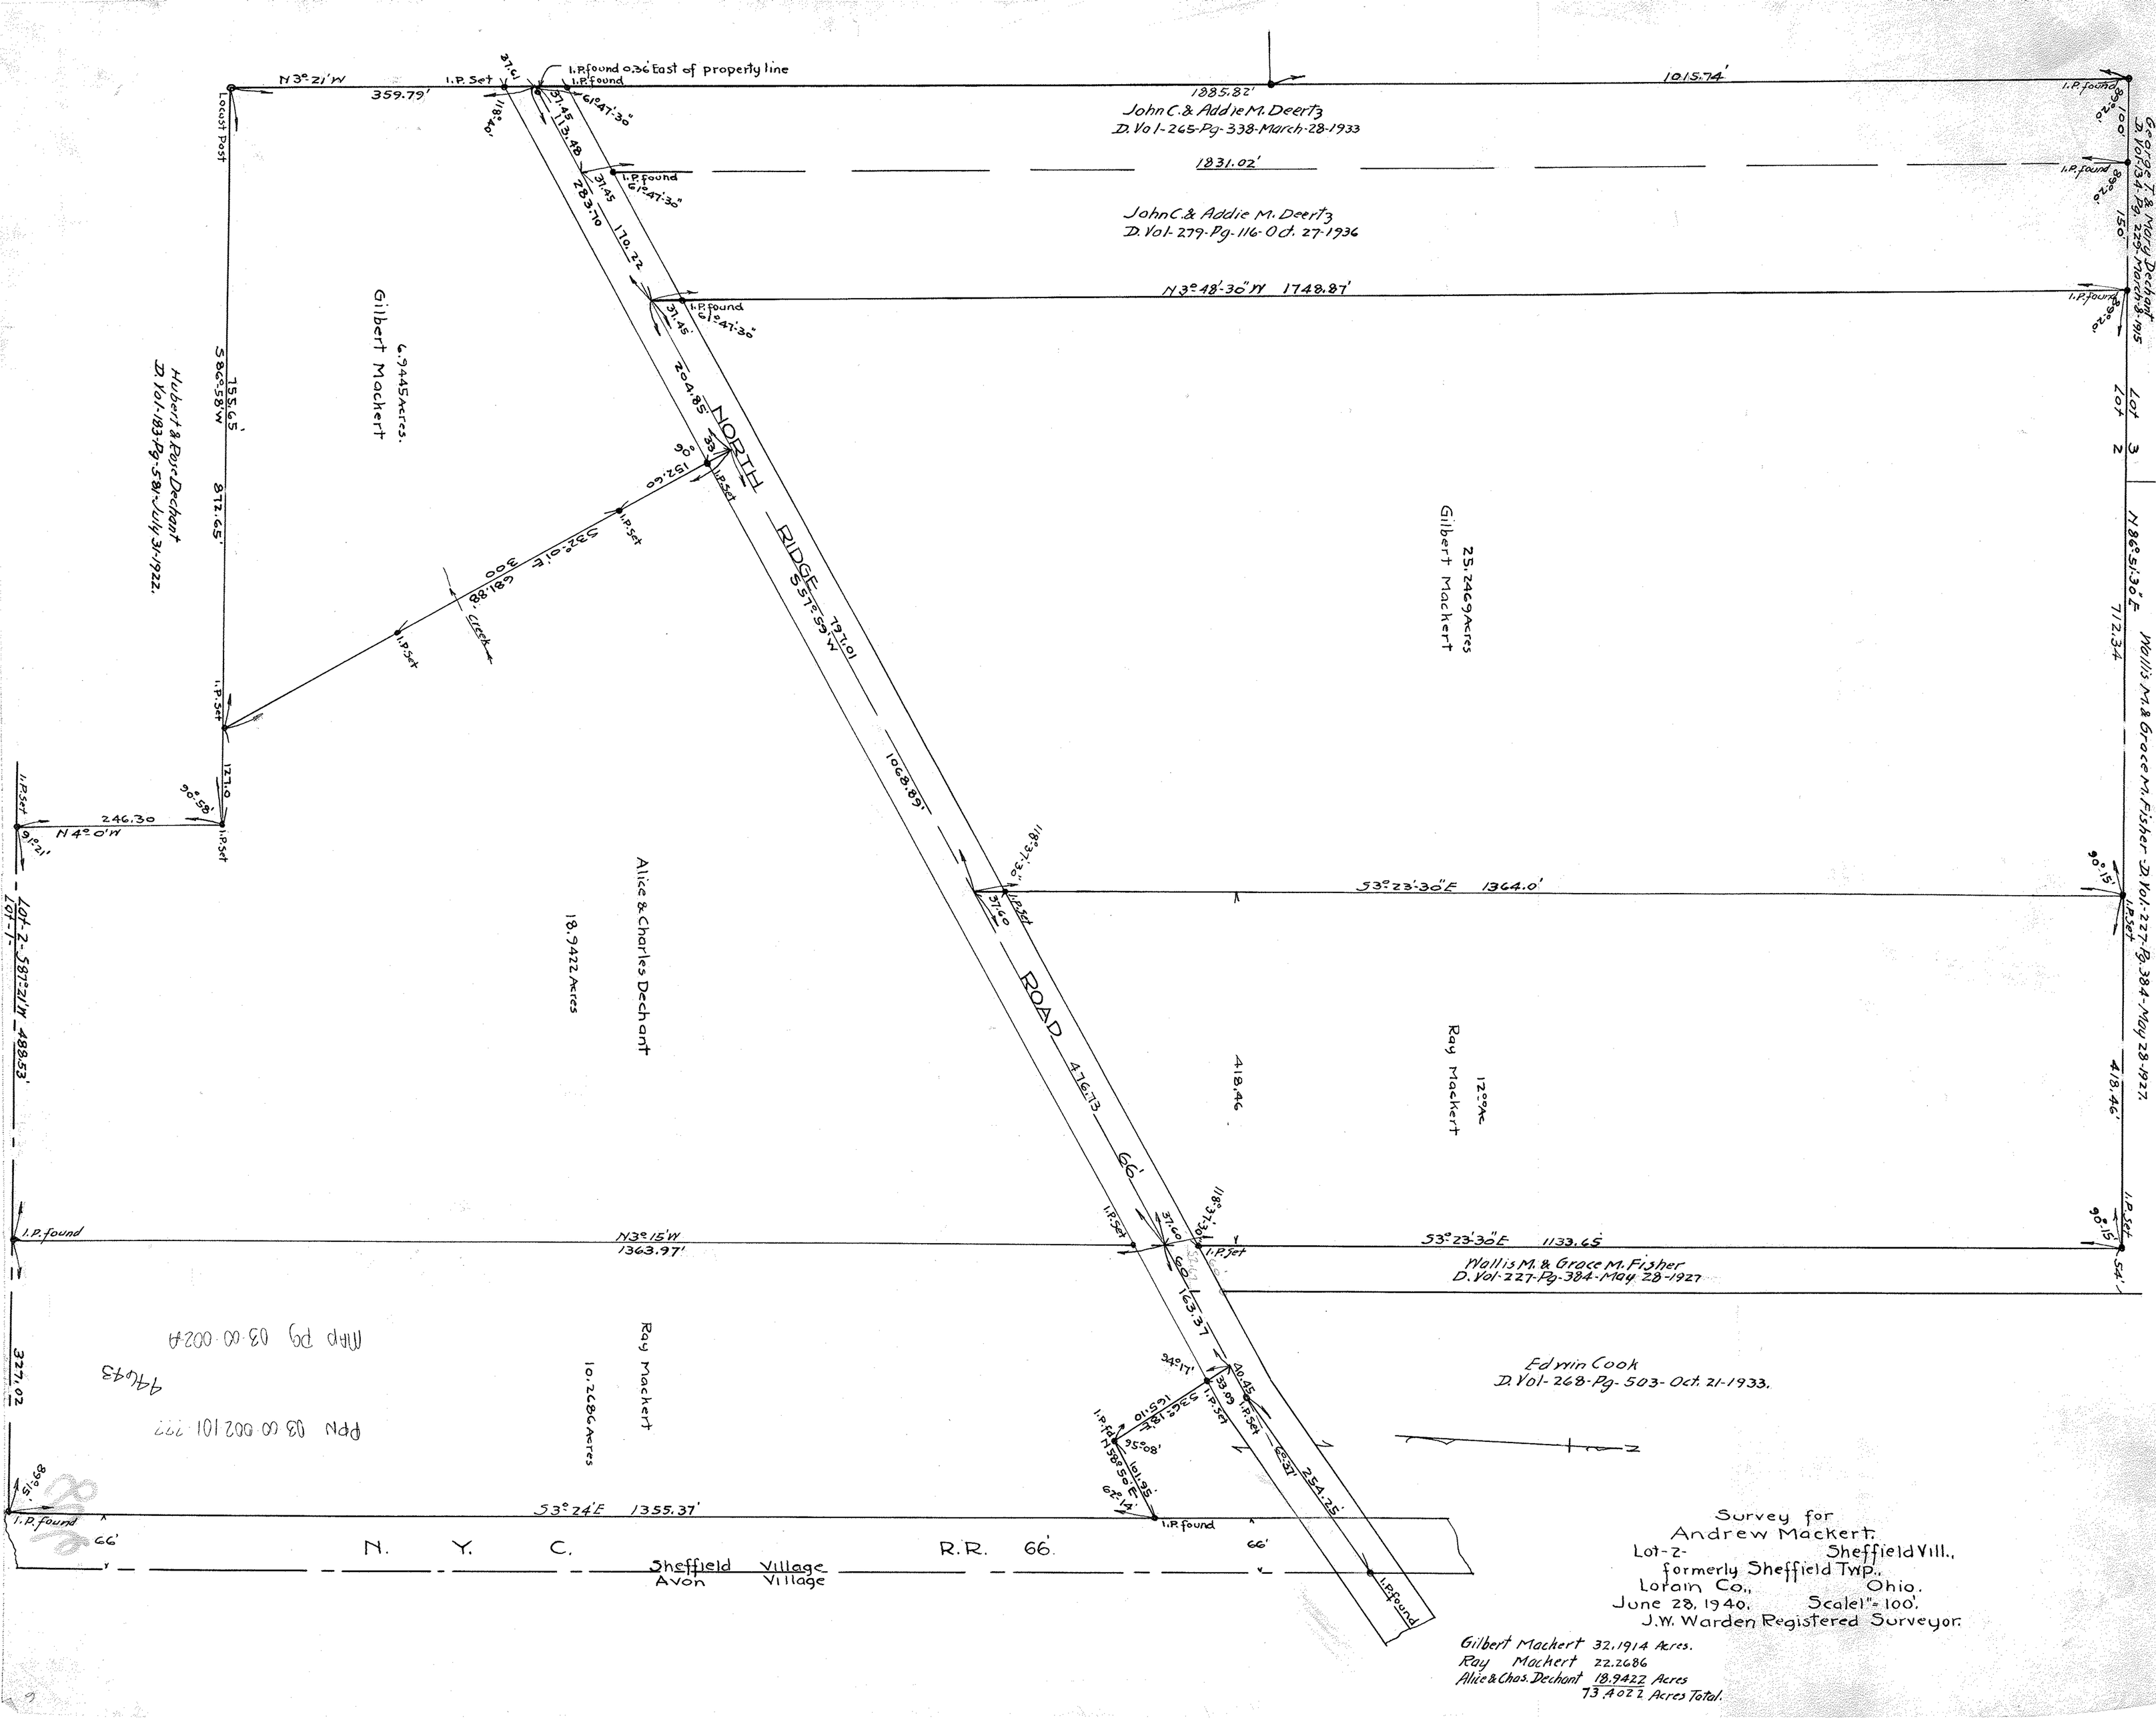

N3°21'W
359.79'
I.P. Set
I.P. found 0.36' East of property line
I.P. found
1885.82'
1015.74'
John C. & Addie M. Deertz
D. Vol-265-Pg-338-March-28-1933
1831.02'
John C. & Addie M. Deertz
D. Vol-279-Pg-116-Oct. 27-1936
N3°48'30"W 1748.87'
Locust Post
Gilbert Mackert
6.9445 Acres.
Hubert & Rose Dechant
D. Vol-183-Pg-581-July 31-1922.
S86°58'W
755.65'
872.65'
NORTH RIDGE ROAD
S57°59'W
797.01
1068.89'
25.2469 Acres
Gilbert Mackert
Wallis M. & Grace M. Fisher D. Vol-227-Pg-384-May 28-1927.
Lot 3
Lot 2
N86°51'30"E
712.34
Alice & Charles Dechant
18.9422 Acres
Lot-2-S87°21'W 488.53'
Lot-1-
S3°23'30"E 1364.0'
418.46
Ray Mackert
12.00 Ac
476.73
66'
N3°15'W
1363.97'
S3°23'30"E 1133.65'
Wallis M. & Grace M. Fisher
D. Vol-227-Pg-384-May 28-1927
Edwin Cook
D. Vol-268-Pg-503-Oct. 21-1933.
Ray Mackert
10.2686 Acres
Map Pg 03-00-002A
PPN 03-00-002101-222
S3°24'E 1355.37'
N. Y. C. R.R. 66'
Sheffield Village
Avon Village
Survey for
Andrew Mackert.
Lot-2- Sheffield Vill.,
formerly Sheffield Twp.,
Lorain Co., Ohio.
June 28, 1940. Scale 1" = 100'.
J.W. Warden Registered Surveyor.
Gilbert Mackert 32.1914 Acres.
Ray Mackert 22.2686
Alice & Chas. Dechant 18.9422 Acres
73.4022 Acres Total.