


700096.A

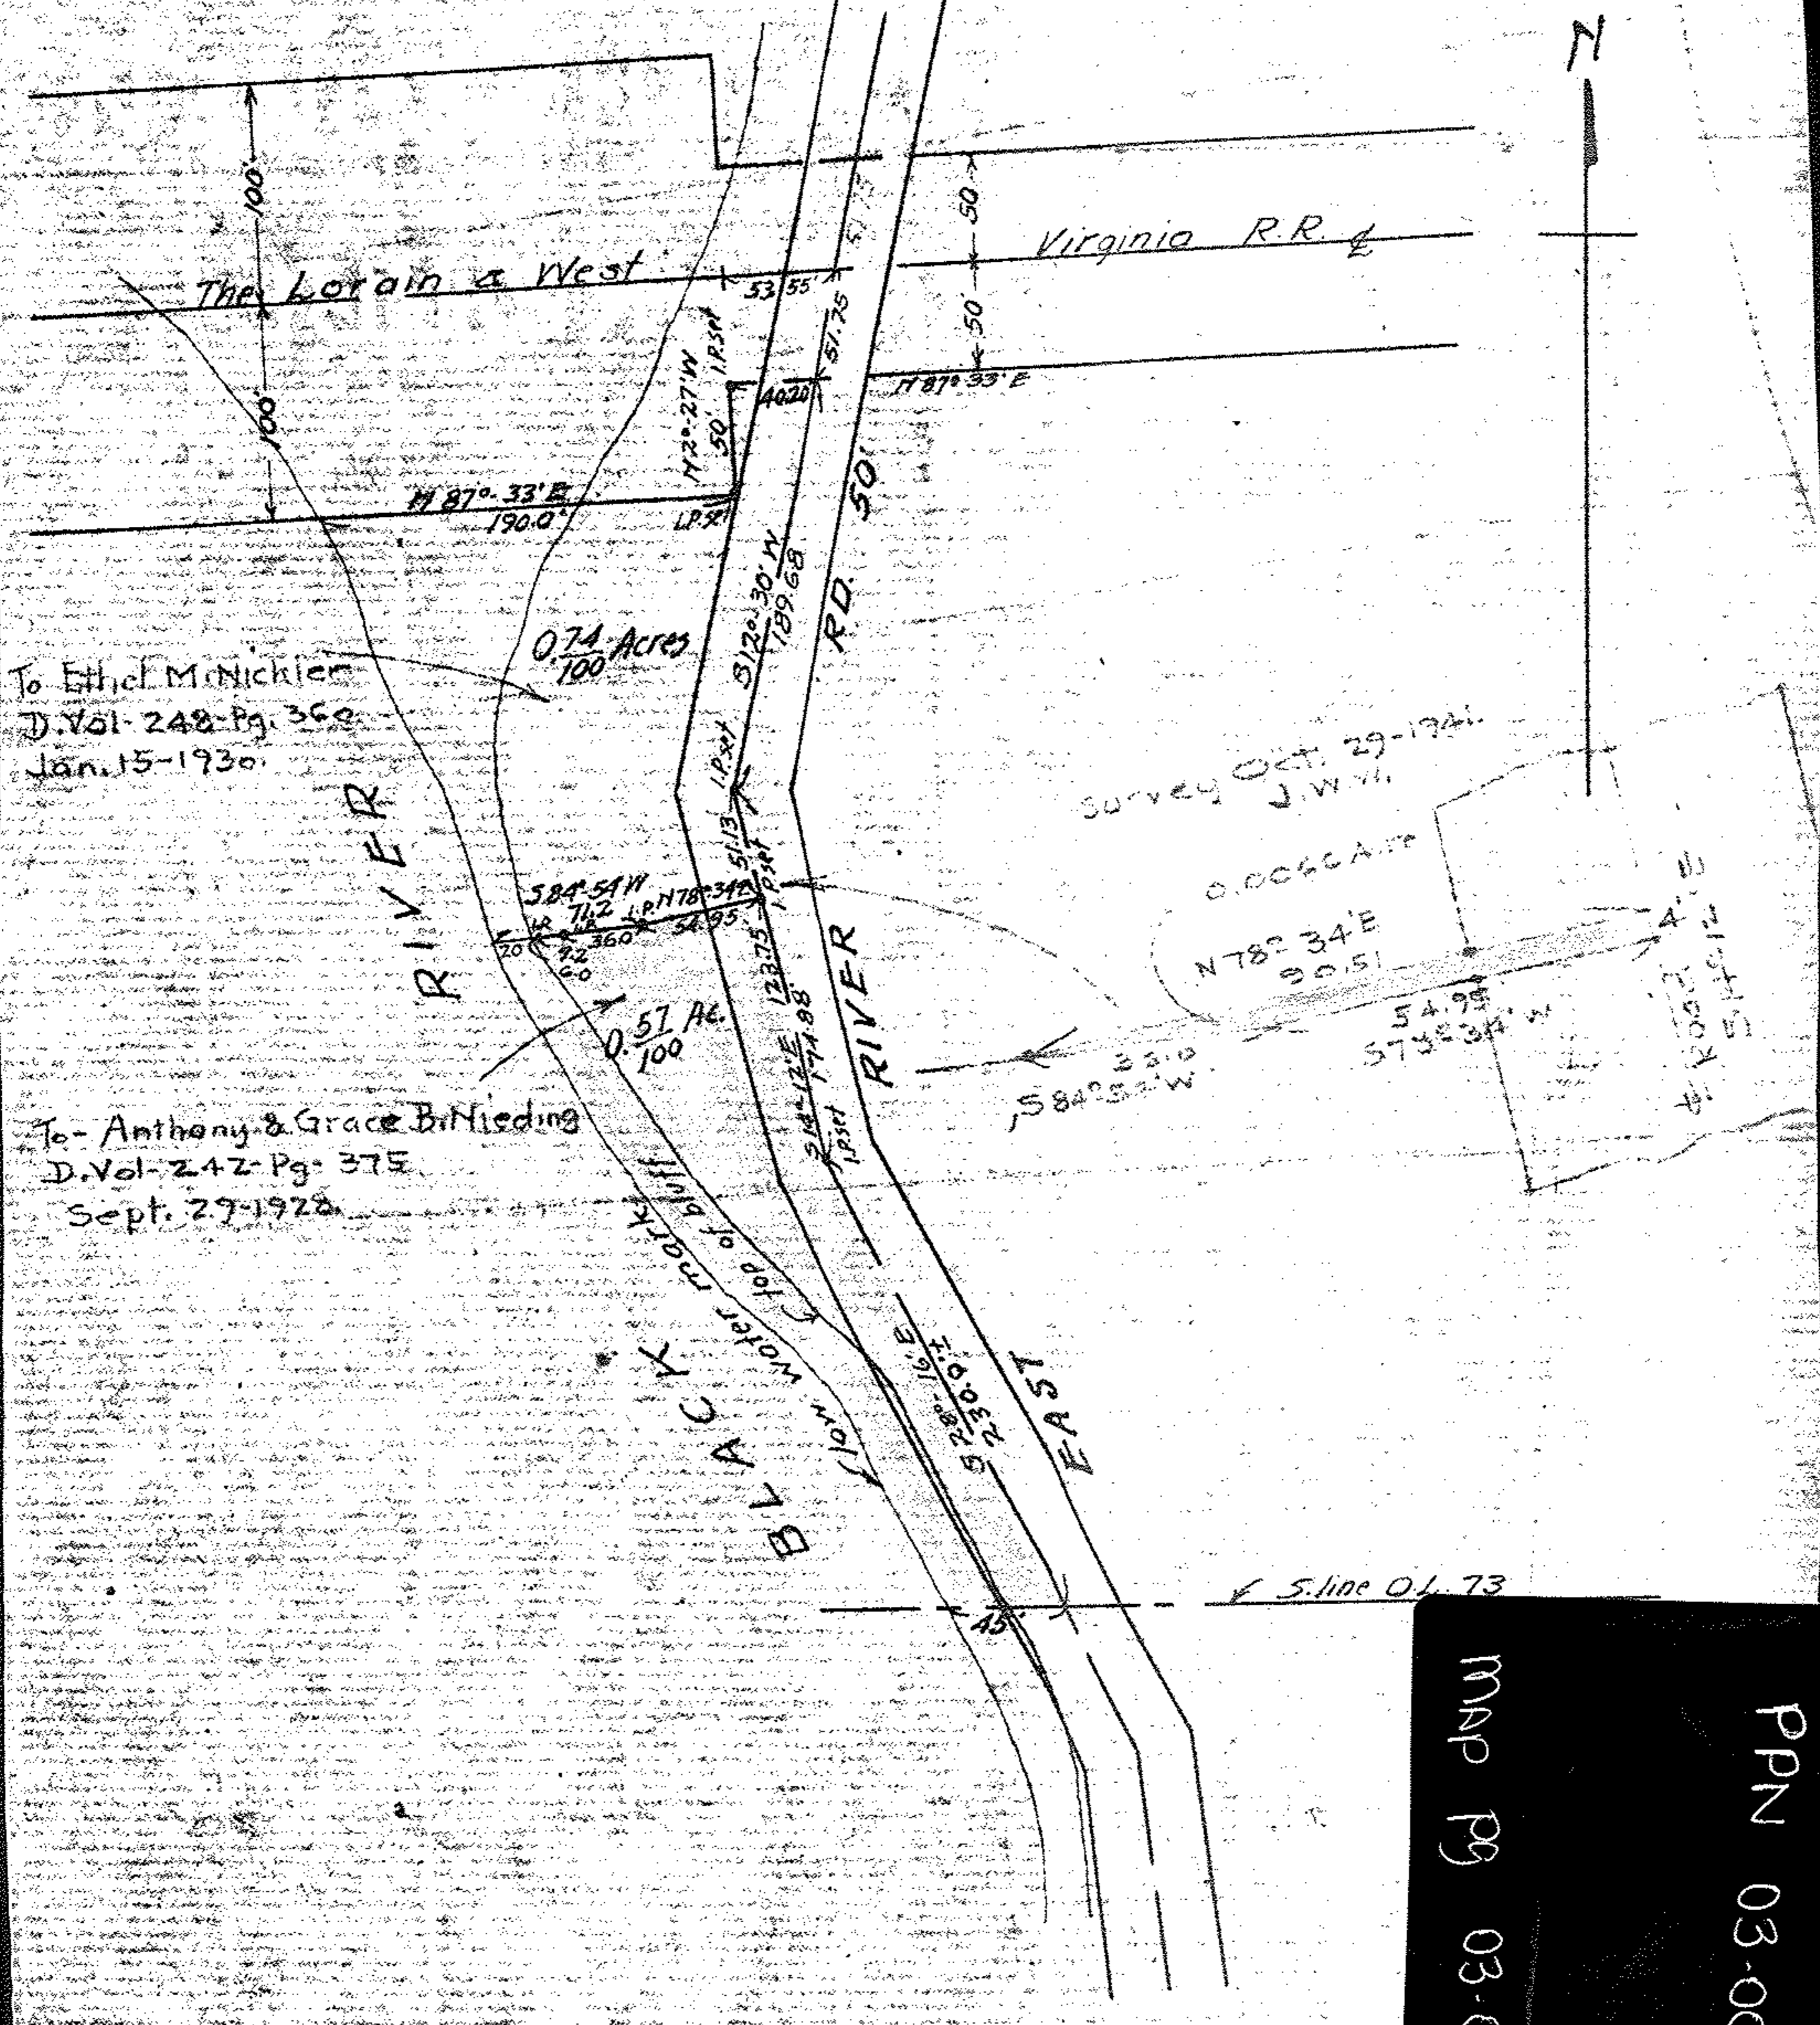

To Ethel Minickler  
 D. Vol. 248 Pg. 360  
 Jan. 15-1930.

To Anthony & Grace Bifielding  
 D. Vol. 242 Pg. 375  
 Sept. 29-1928.

Survey Oct. 29-1921  
 J.W.M.

Survey for Paul M. Taylor  
 Original Lot 73 Sheffield Lake Village  
 Lorain Co. Ohio.  
 Scale 1"=100 August 7, 1922  
 Warden & Laundon  
 Engineers.

PPN 03-00-073-101-049  
 MAP PG 03-00-073-A  
 44660  
 060