700665

J-1942

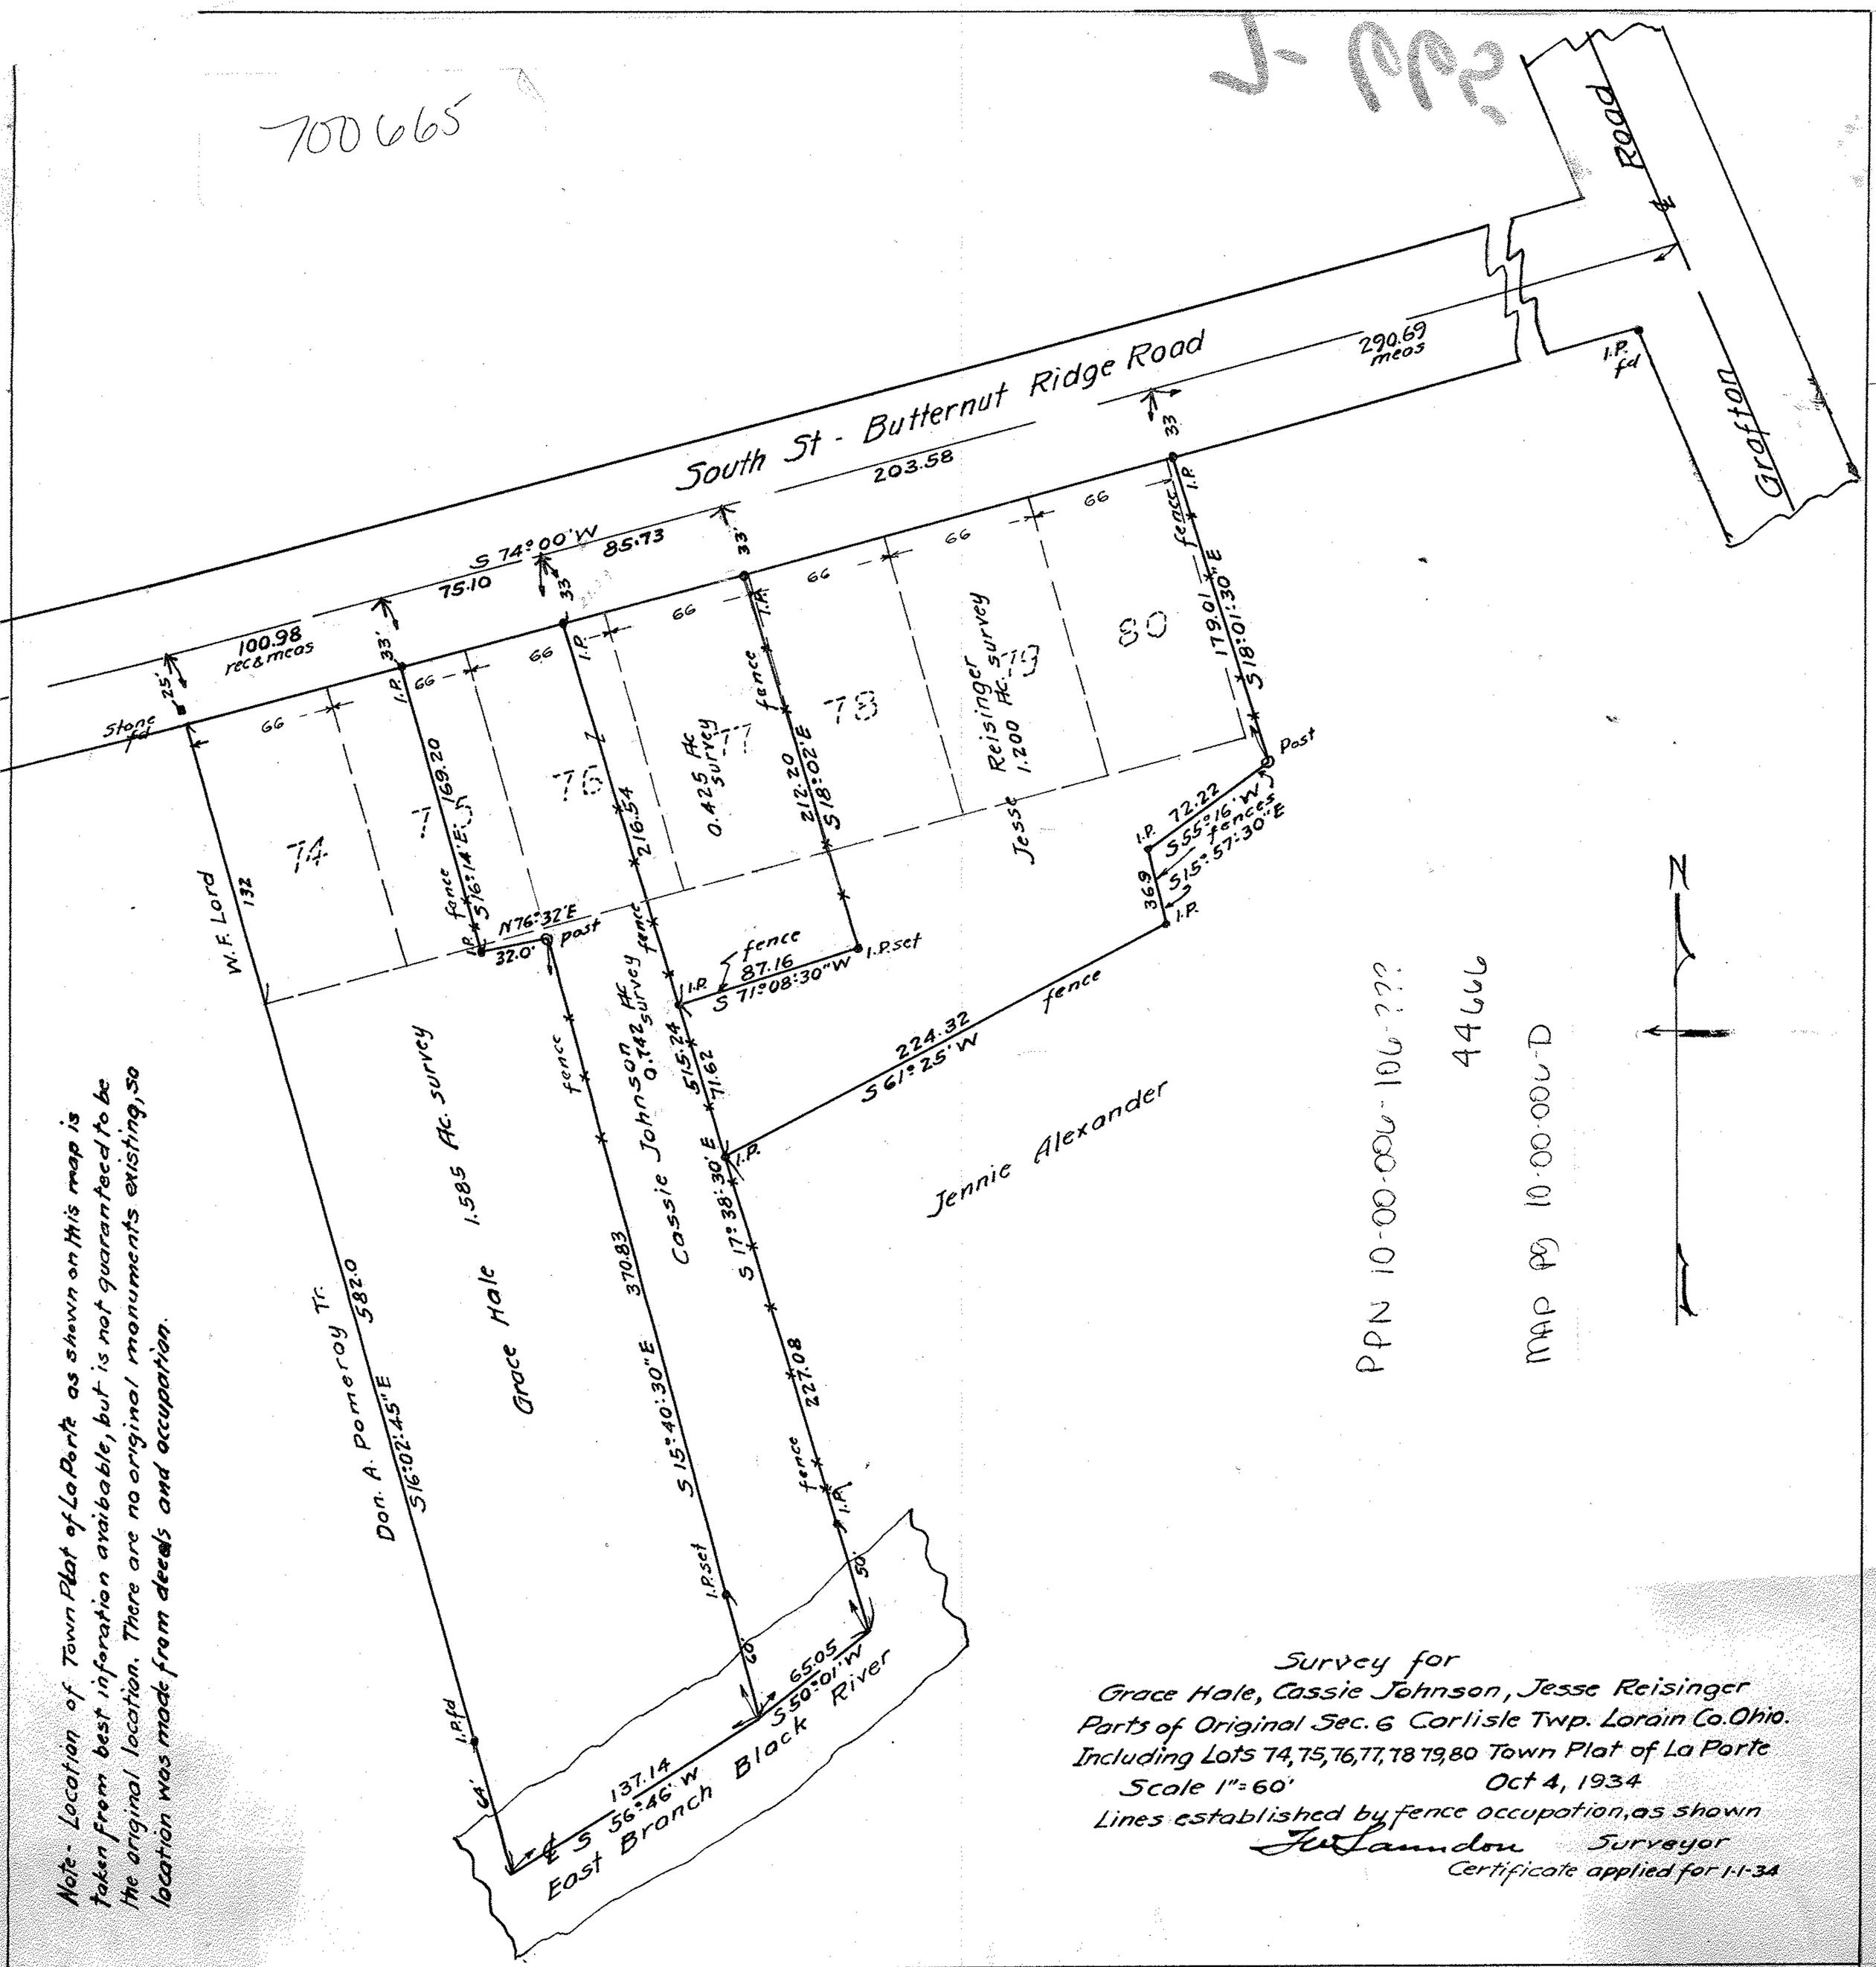

PPN 10-00-006-106.???

44466

Map 10-00-006-D

Note - Location of Town Plat of La Porte as shown on this map is taken from best information available, but is not guaranteed to be the original location. There are no original monuments existing, so location was made from deeds and occupation.

Survey for
Grace Hale, Cassie Johnson, Jesse Reisinger
Parts of Original Sec. 6 Carlisle Twp. Lorain Co. Ohio.
Including Lots 74, 75, 76, 77, 78 79, 80 Town Plat of La Porte
Scale 1" = 60' Oct 4, 1934
Lines established by fence occupation, as shown
Jul Lamdon Surveyor
Certificate applied for 1-1-34