


PPN 06-26-121-000-???

44684

MAP PG 6-100

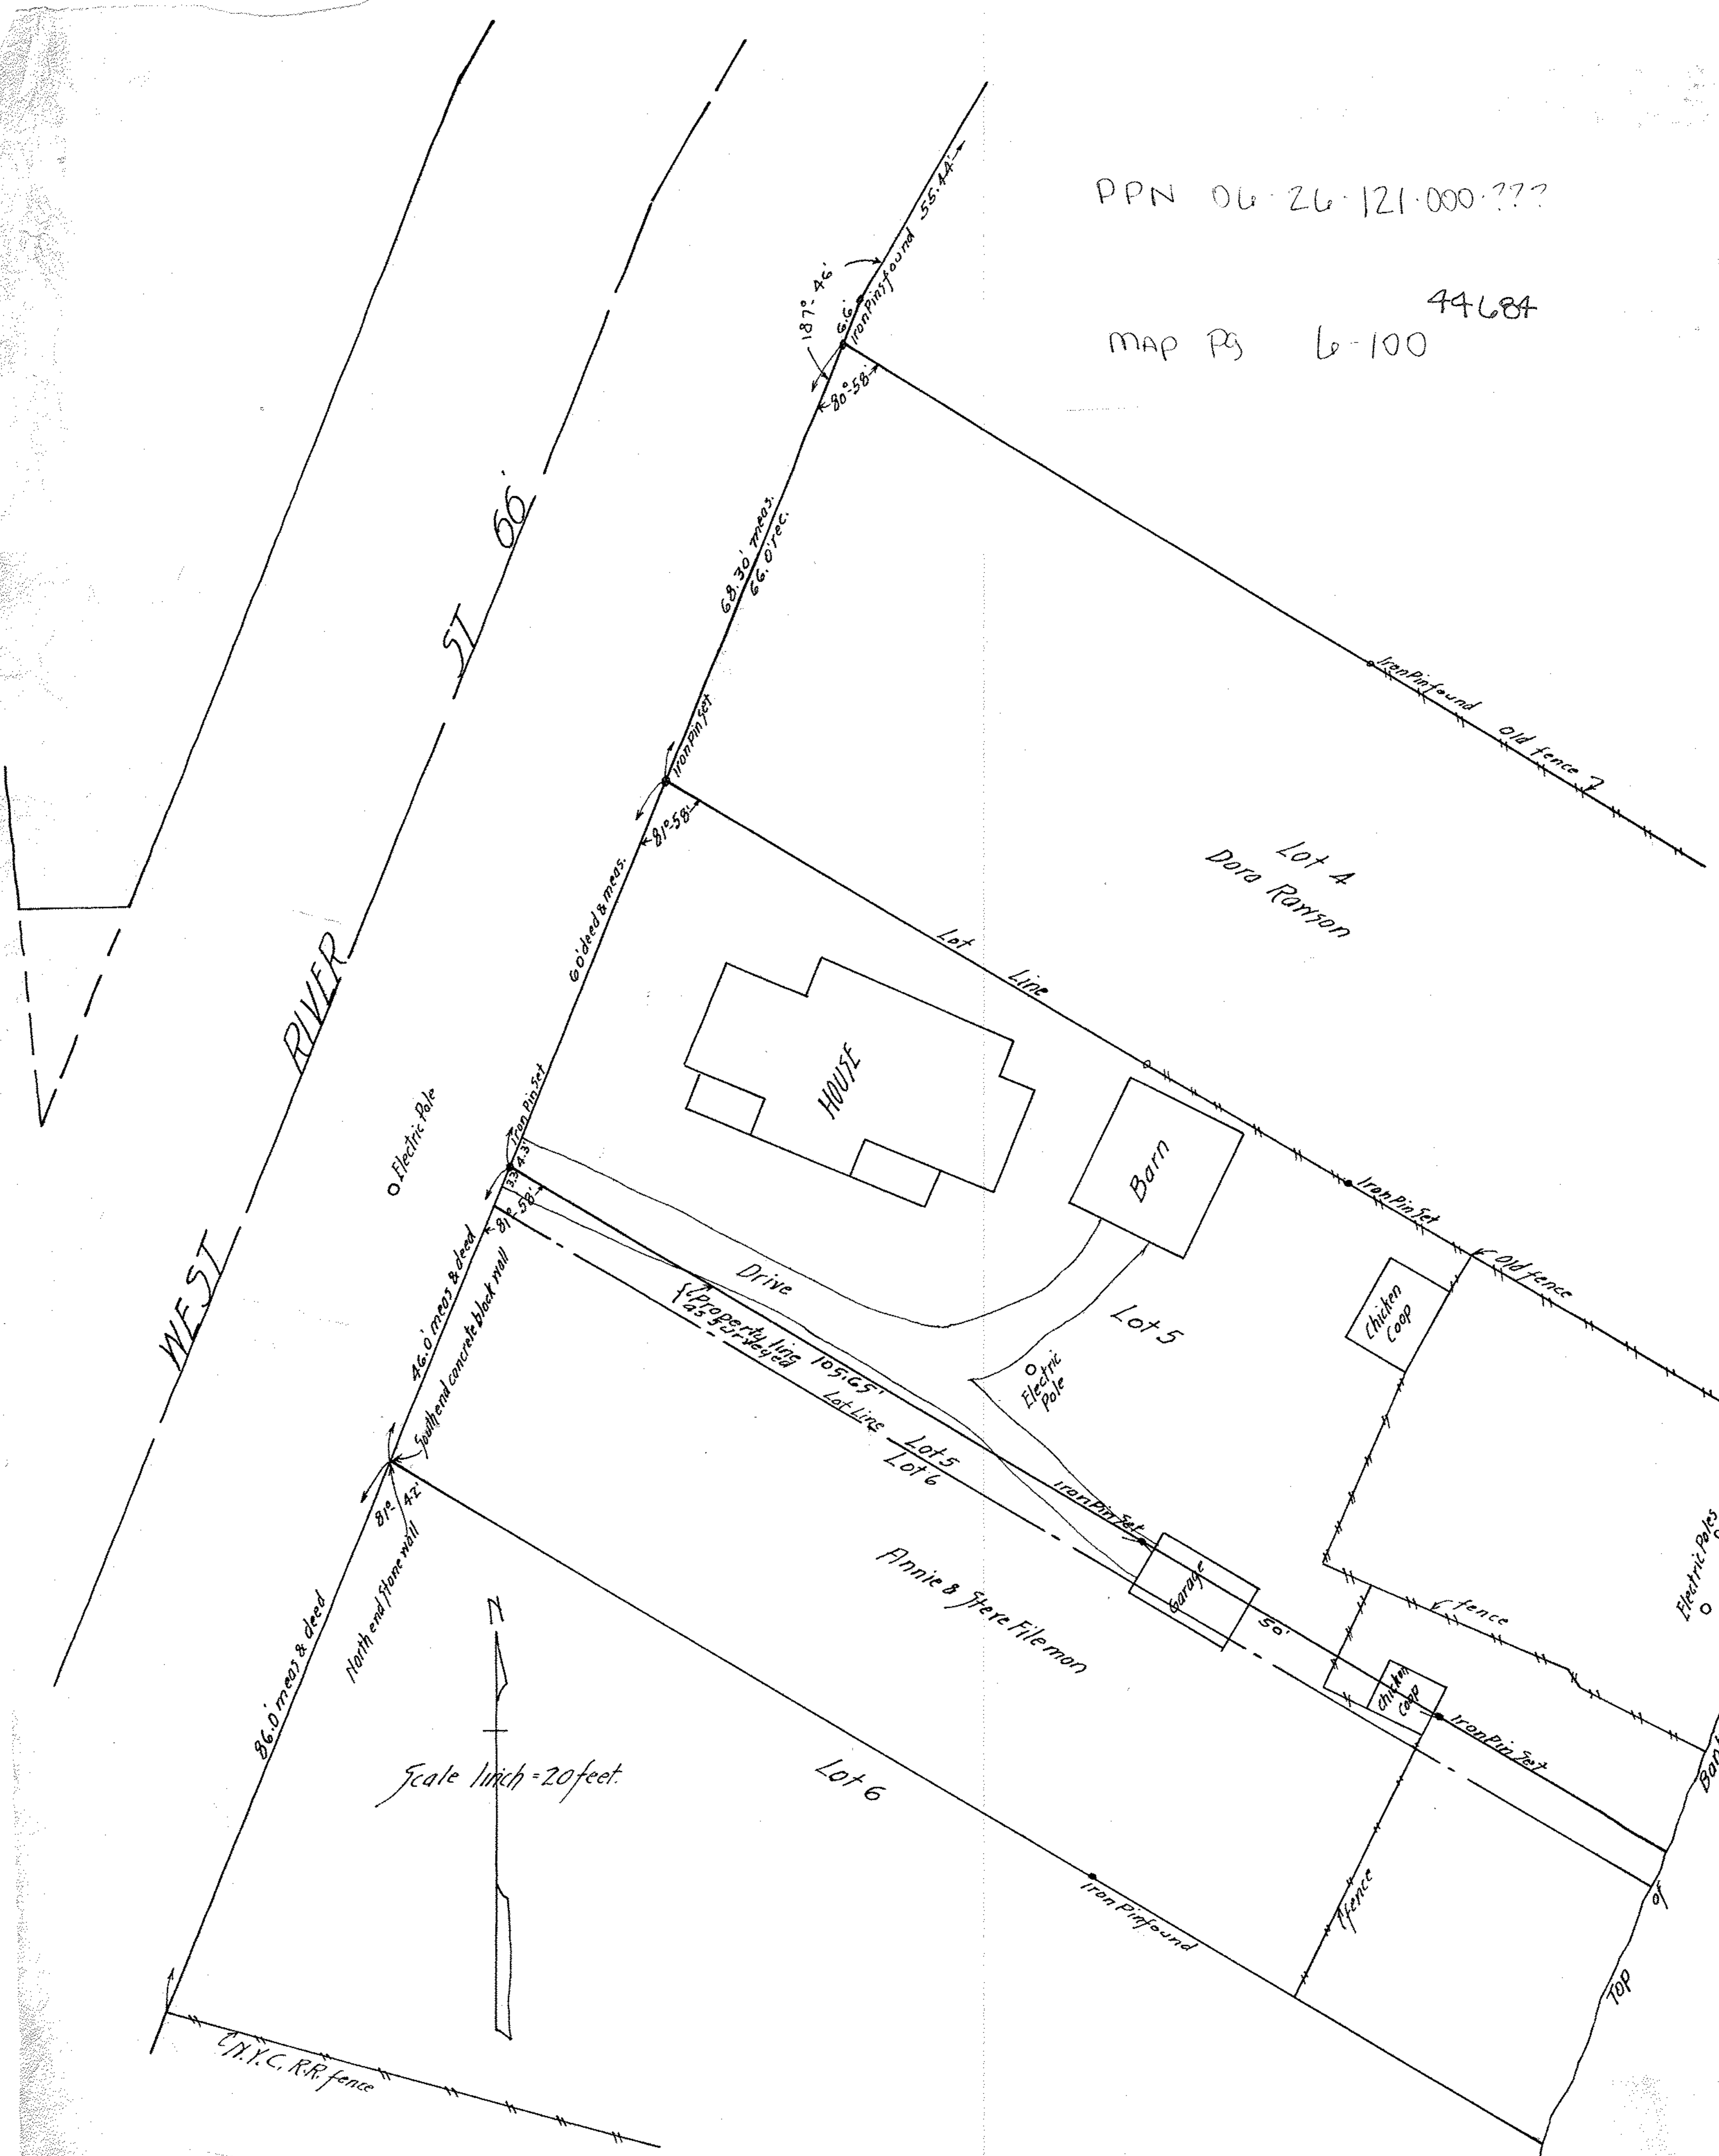

700293

Survey of Property of
 John & Ella McMullen.
 Lot 5. Bishop Addition
 Map Vol-2- Page 4.
 Elyria Lorain Co., Ohio.
 Jan. 28, 1922. Warden & Saunders
 Engineers.