01-00-002-111-002, 001, 005, 006
01-00-002-B
44699

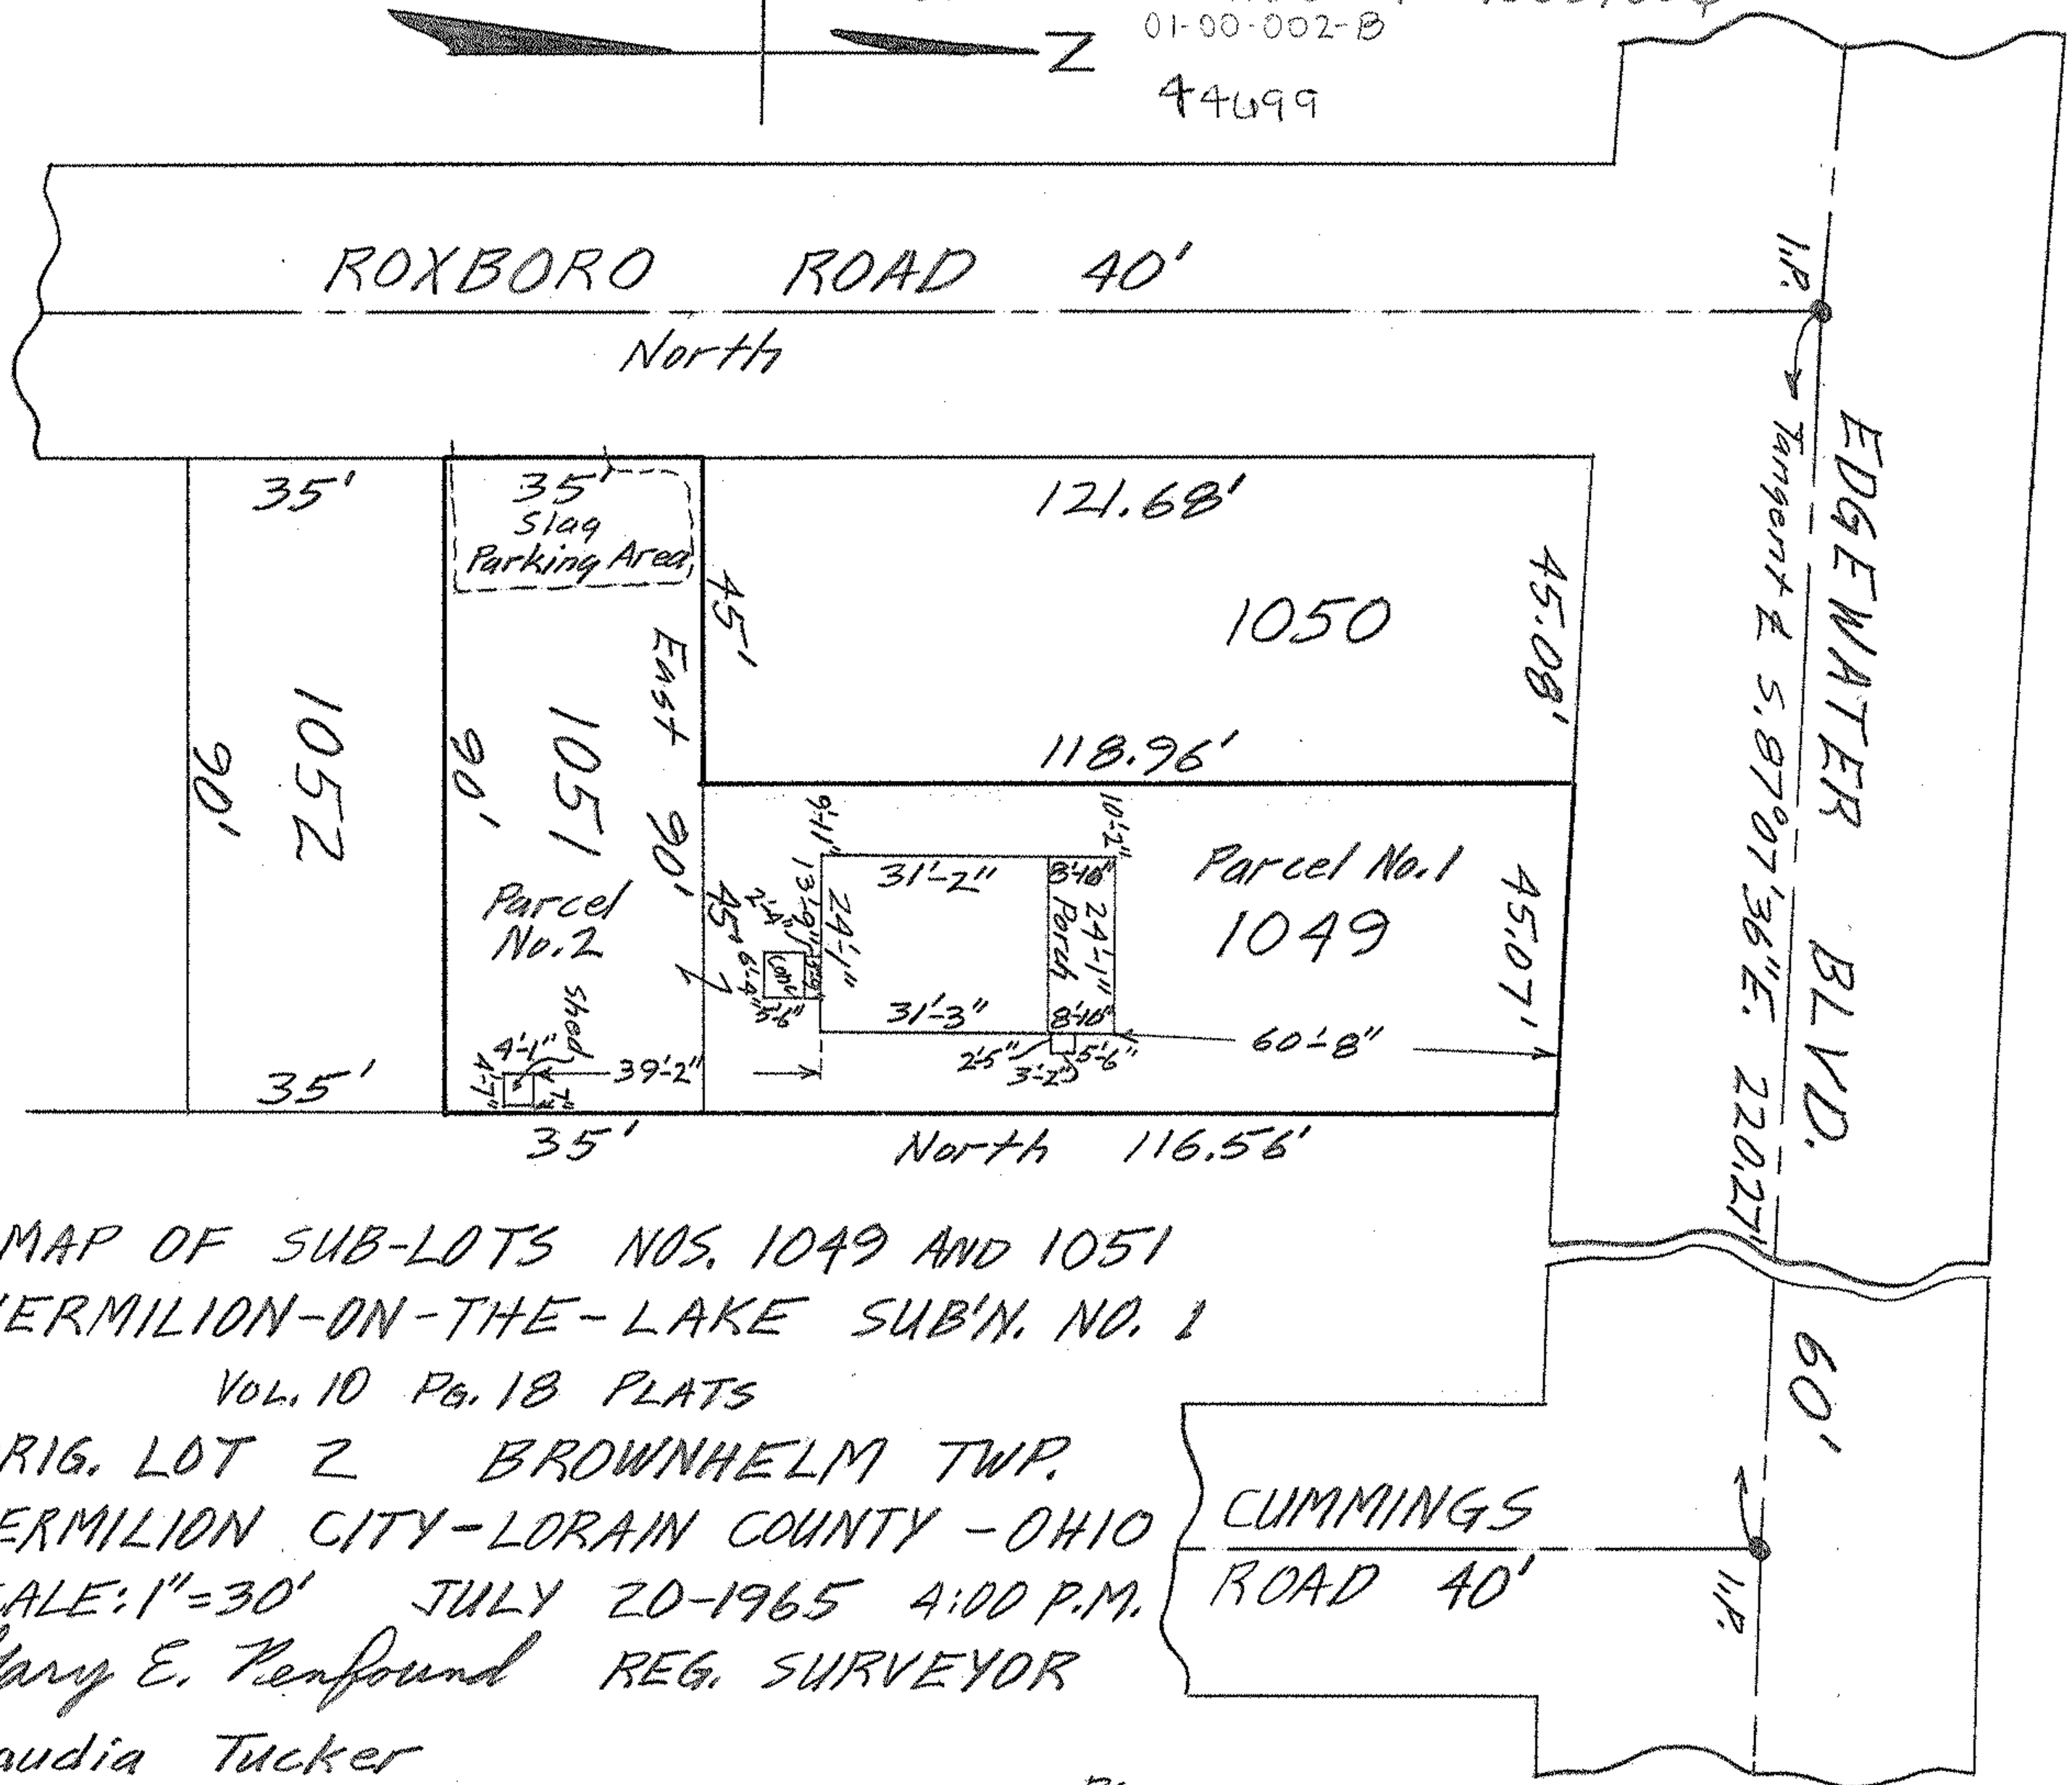

MAP OF SUB-LOTS NOS. 1049 AND 1051
VERMILION-ON-THE-LAKE SUB'N. NO. 1
VOL. 10 PG. 18 PLATS
ORIG. LOT 2 BROWNHELM TWP.
VERMILION CITY-LORAIN COUNTY-OHIO
SCALE: 1"=30' JULY 20-1965 4:00 P.M.
Gary E. Penfound REG. SURVEYOR
Claudia Tucker

PC