


Russell A. & Jeanne B. Blakeslee

01-00-002-106-036-2038

44701

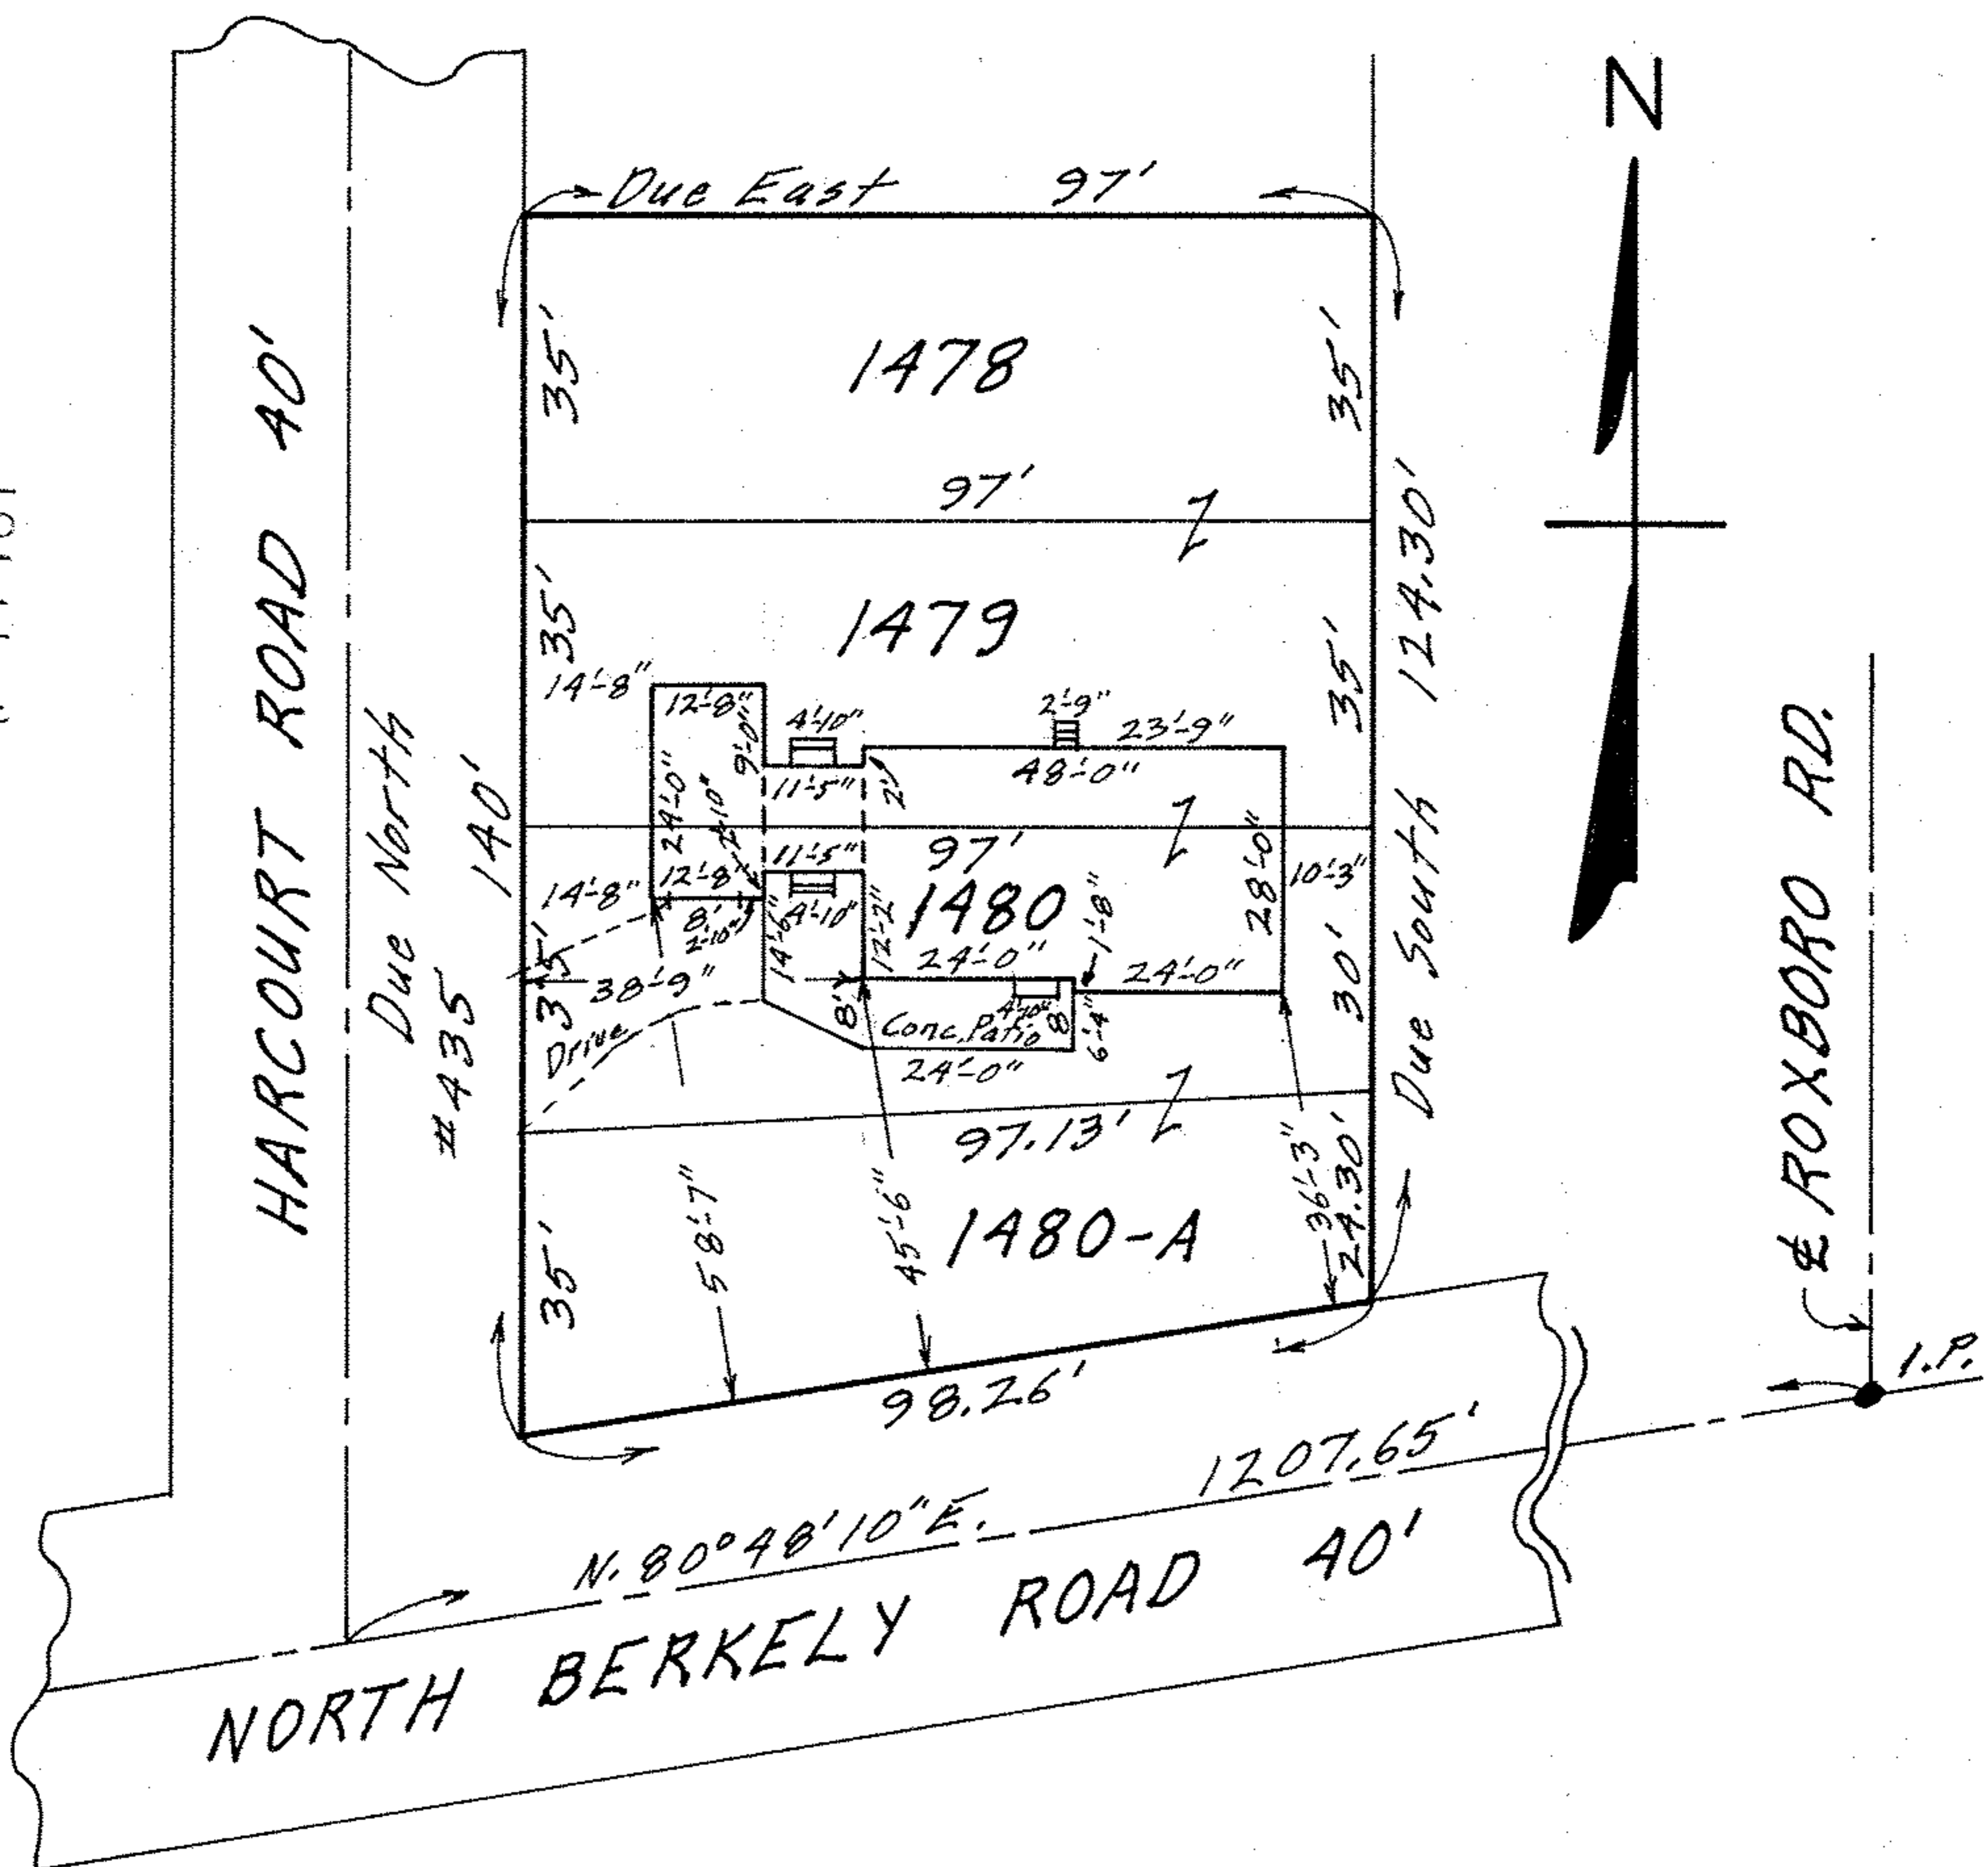

MAP OF SUB-LOTS 1478, 1479, 1480 & 1480A
 VERMILION-ON-THE-LAKE SUB'N. NO. 1 VOL. 10 PG. 18
 RESTORED VOL. 16 PG. 32 PLATS
 ORIG. LOT 2 BROWNHELM TWP.
 VERMILION CITY - LORAIN CO. - OHIO
 SCALE: 1" = 30' FEB. 25 - 1968 1:30 P.M.
 Gary E. Penfound REG. SURVEYOR