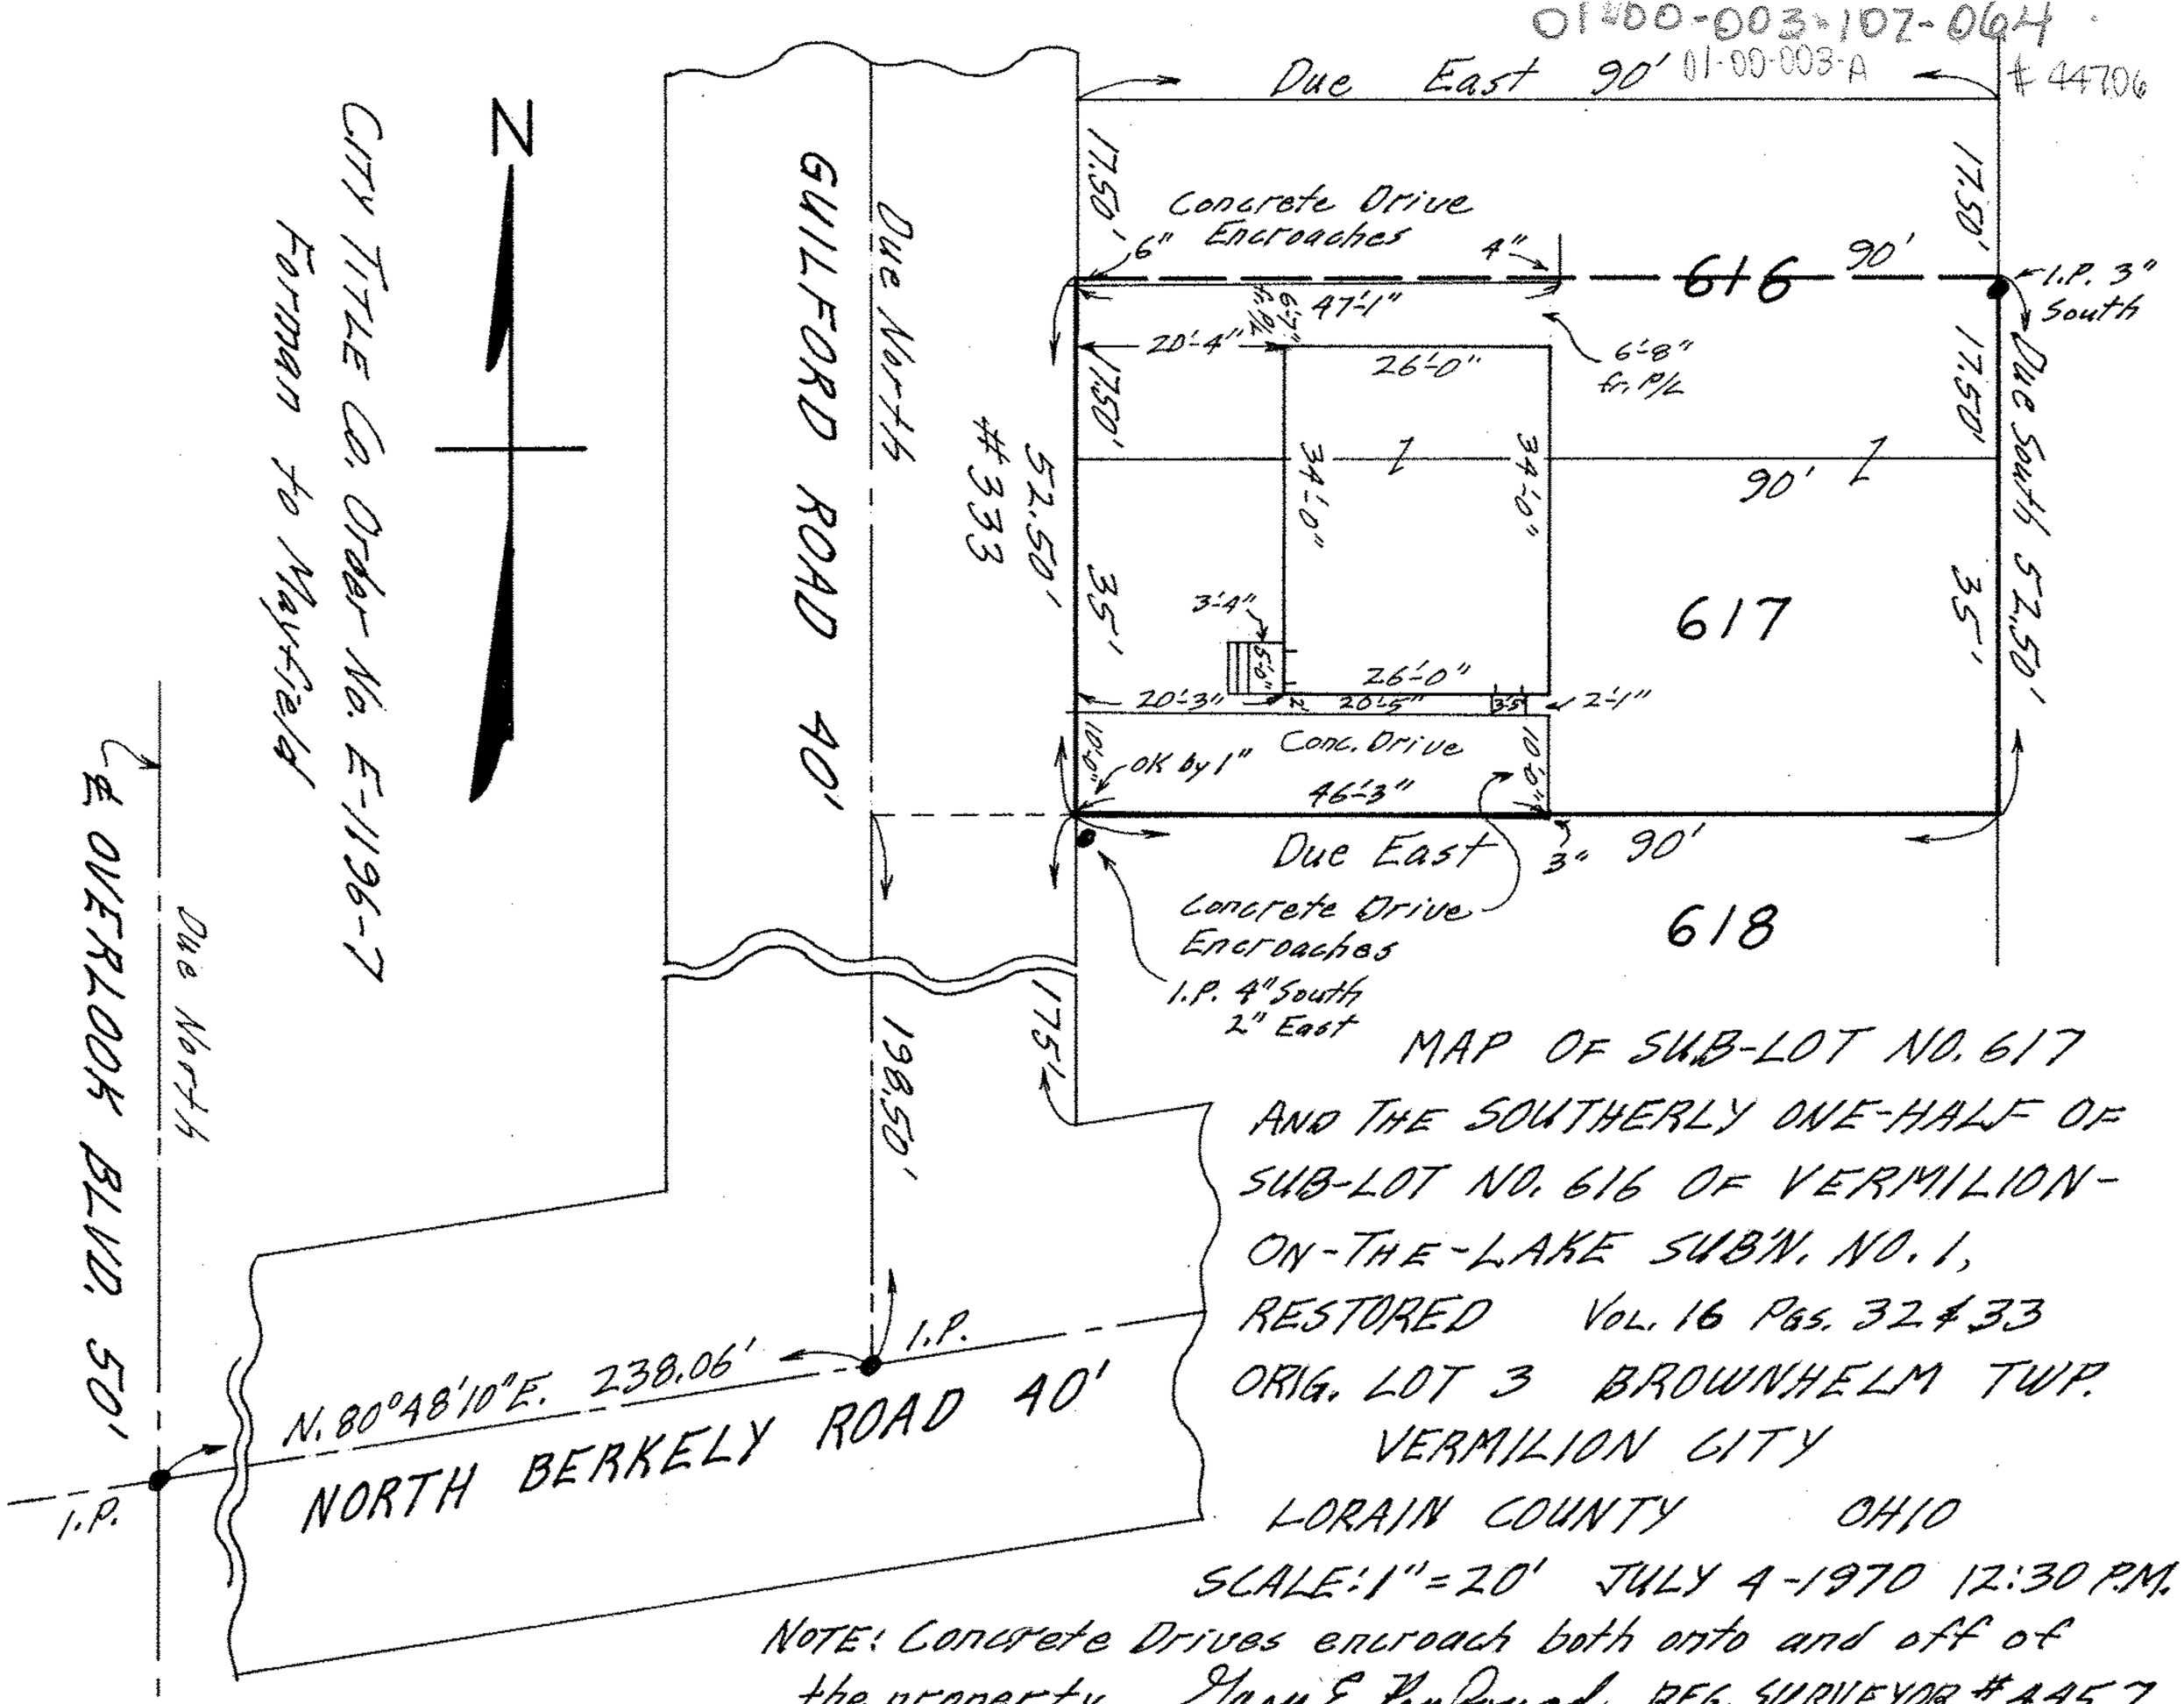

MAP OF SUB-LOT NO. 617
AND THE SOUTHERLY ONE-HALF OF
SUB-LOT NO. 616 OF VERMILION-
ON-THE-LAKE SUB'N. NO. 1,
RESTORED VOL. 16 PGS. 32 & 33
ORIG. LOT 3 BROWNHELM TWP.
VERMILION CITY
LORAIN COUNTY OHIO
SCALE: 1" = 20' JULY 4-1970 12:30 P.M.

NOTE: Concrete Drives encroach both onto and off of the property. Gary E. Penfound REG. SURVEYOR #4457