


01-00-005-110-033, 034
 01-00-003-A
 # 44708

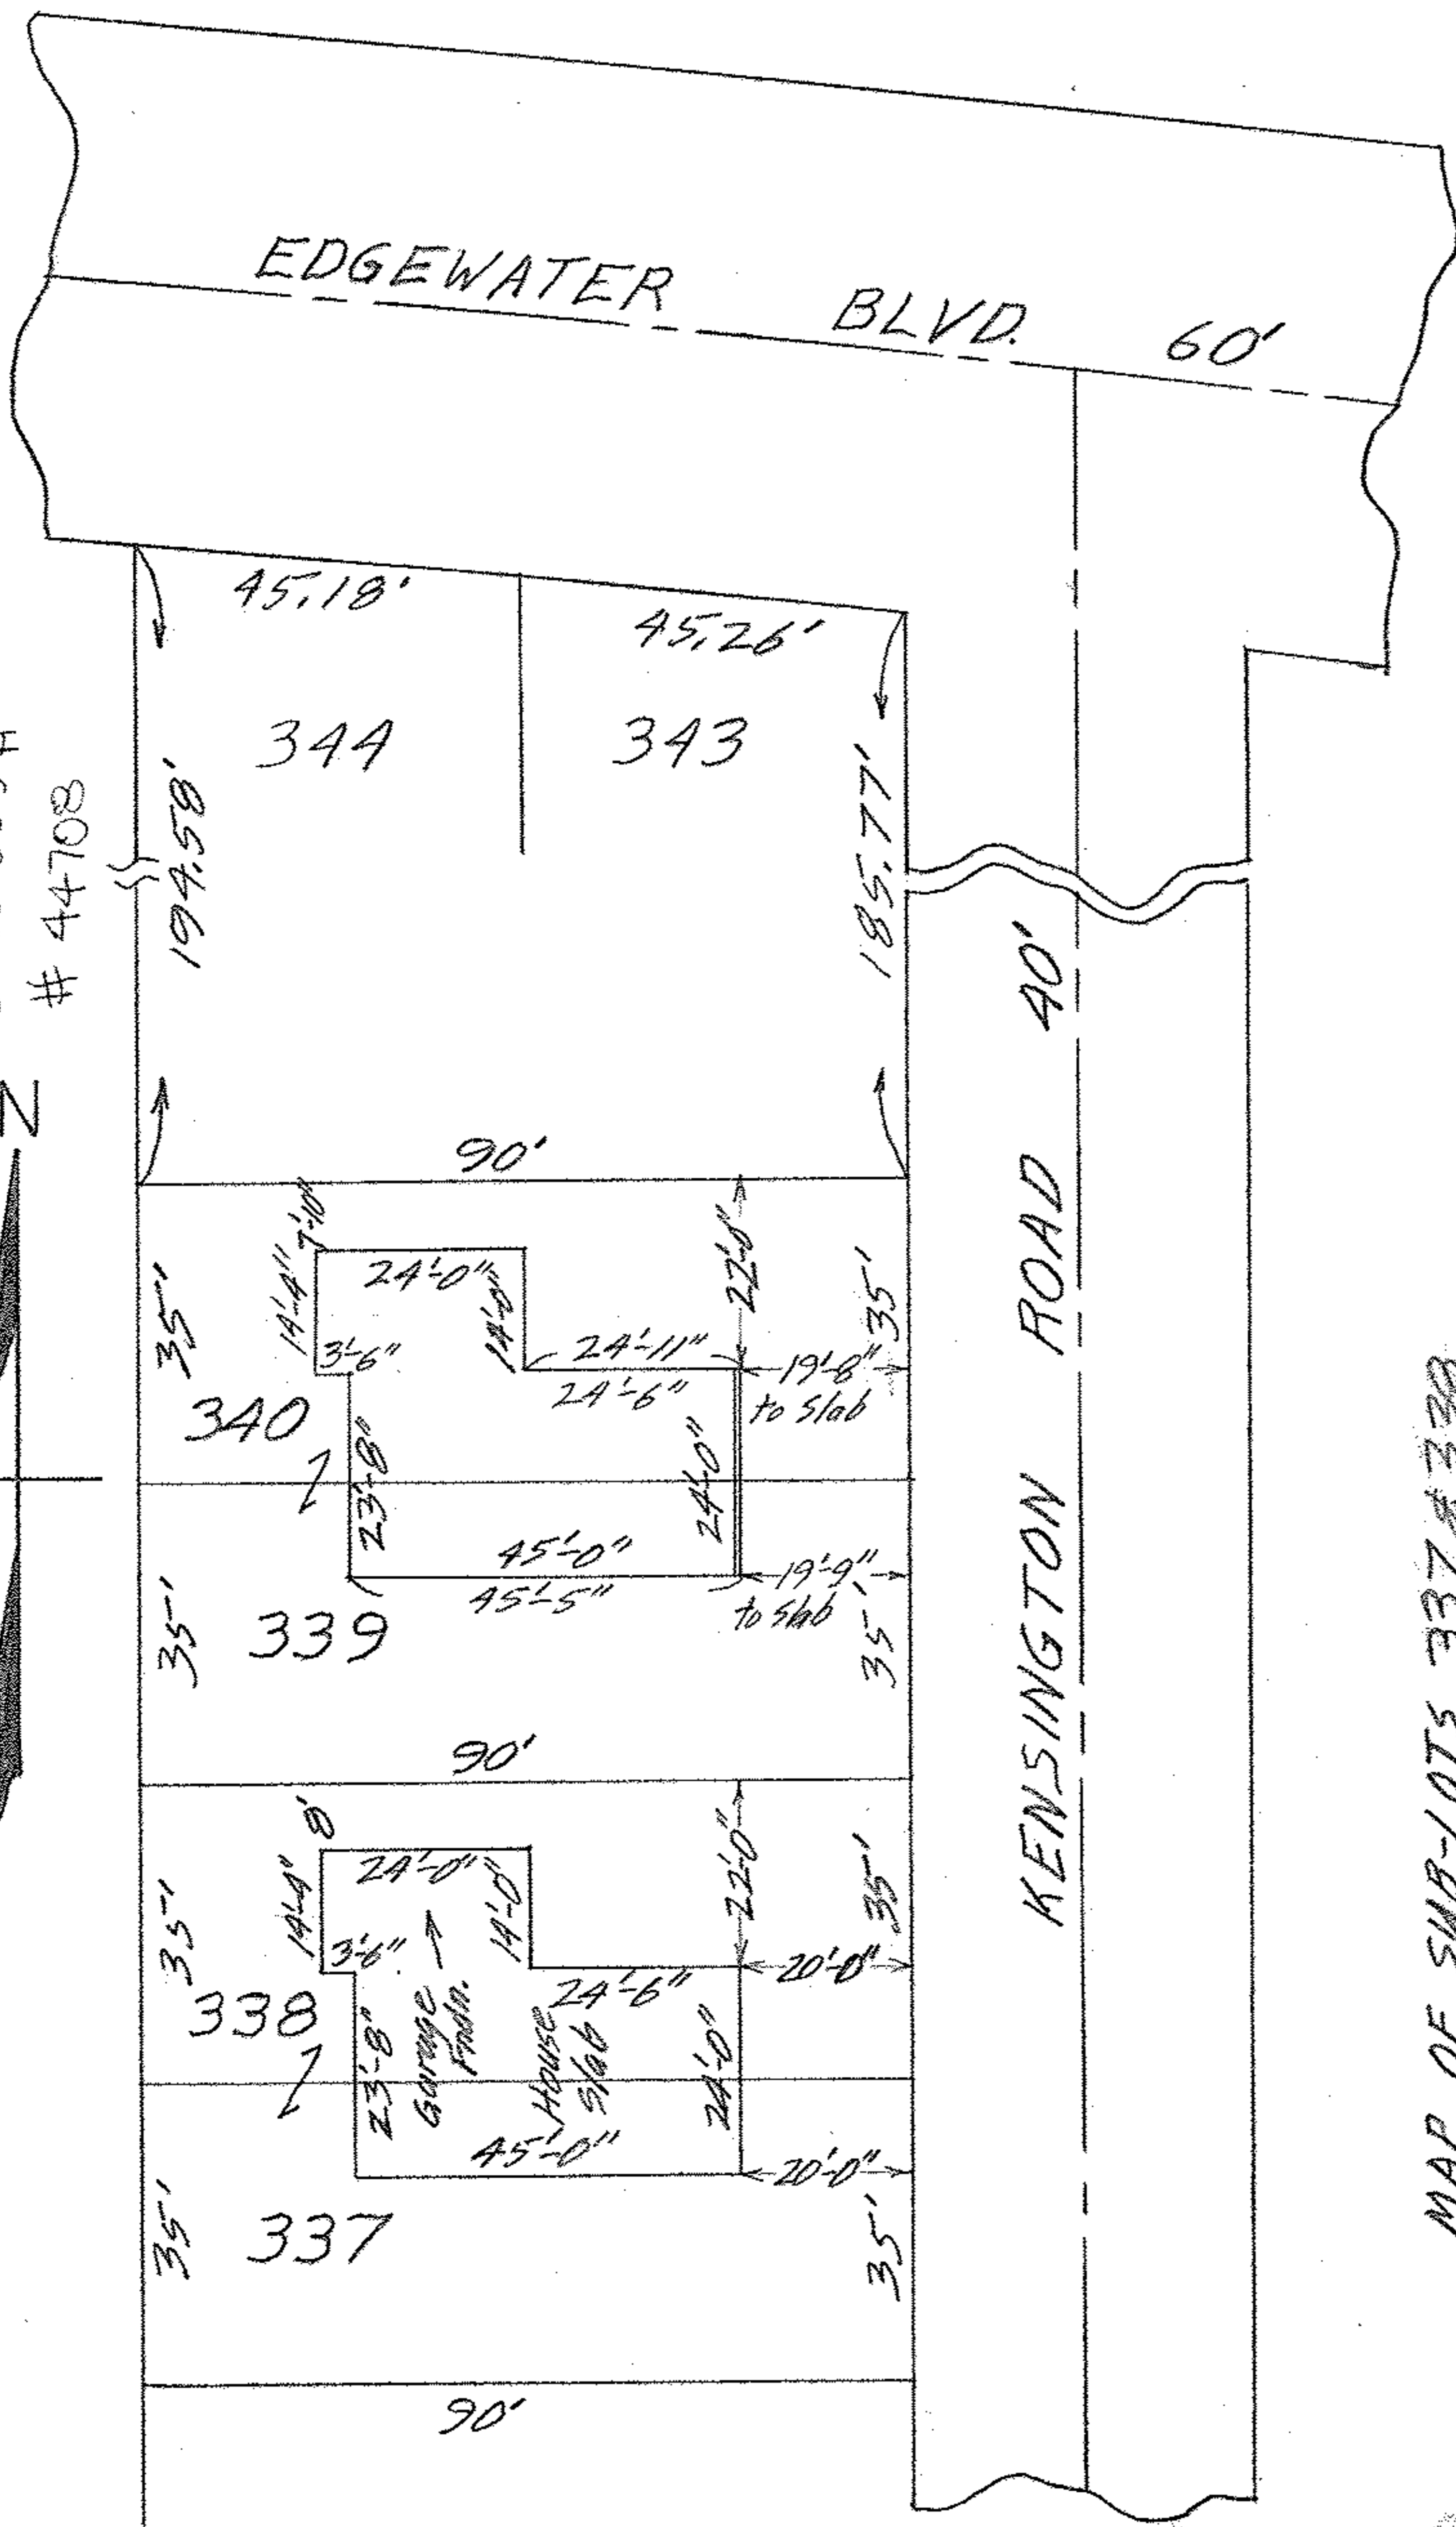

MAP OF SUB-LOTS 337 & 338

VERMILION-ON-THE-LAKE SUB'D. NO. 1
 VOL. 10 Pgs. 18 & 19 AND VOL. 16 Pgs. 32 & 33 PLATS

ORIG. LOTS 2 & 3 BROWNHELM TWP.
 VERMILION-ON-THE-LAKE VILLAGE

LORAIN COUNTY OHIO

SCALE: 1" = 30' FEB. 22-1961 3:30 P.M.

Mary E. Penfound
 for C. E. Penfound

REG. SURVEYORS

CH-8290 John A. & Marie Bader