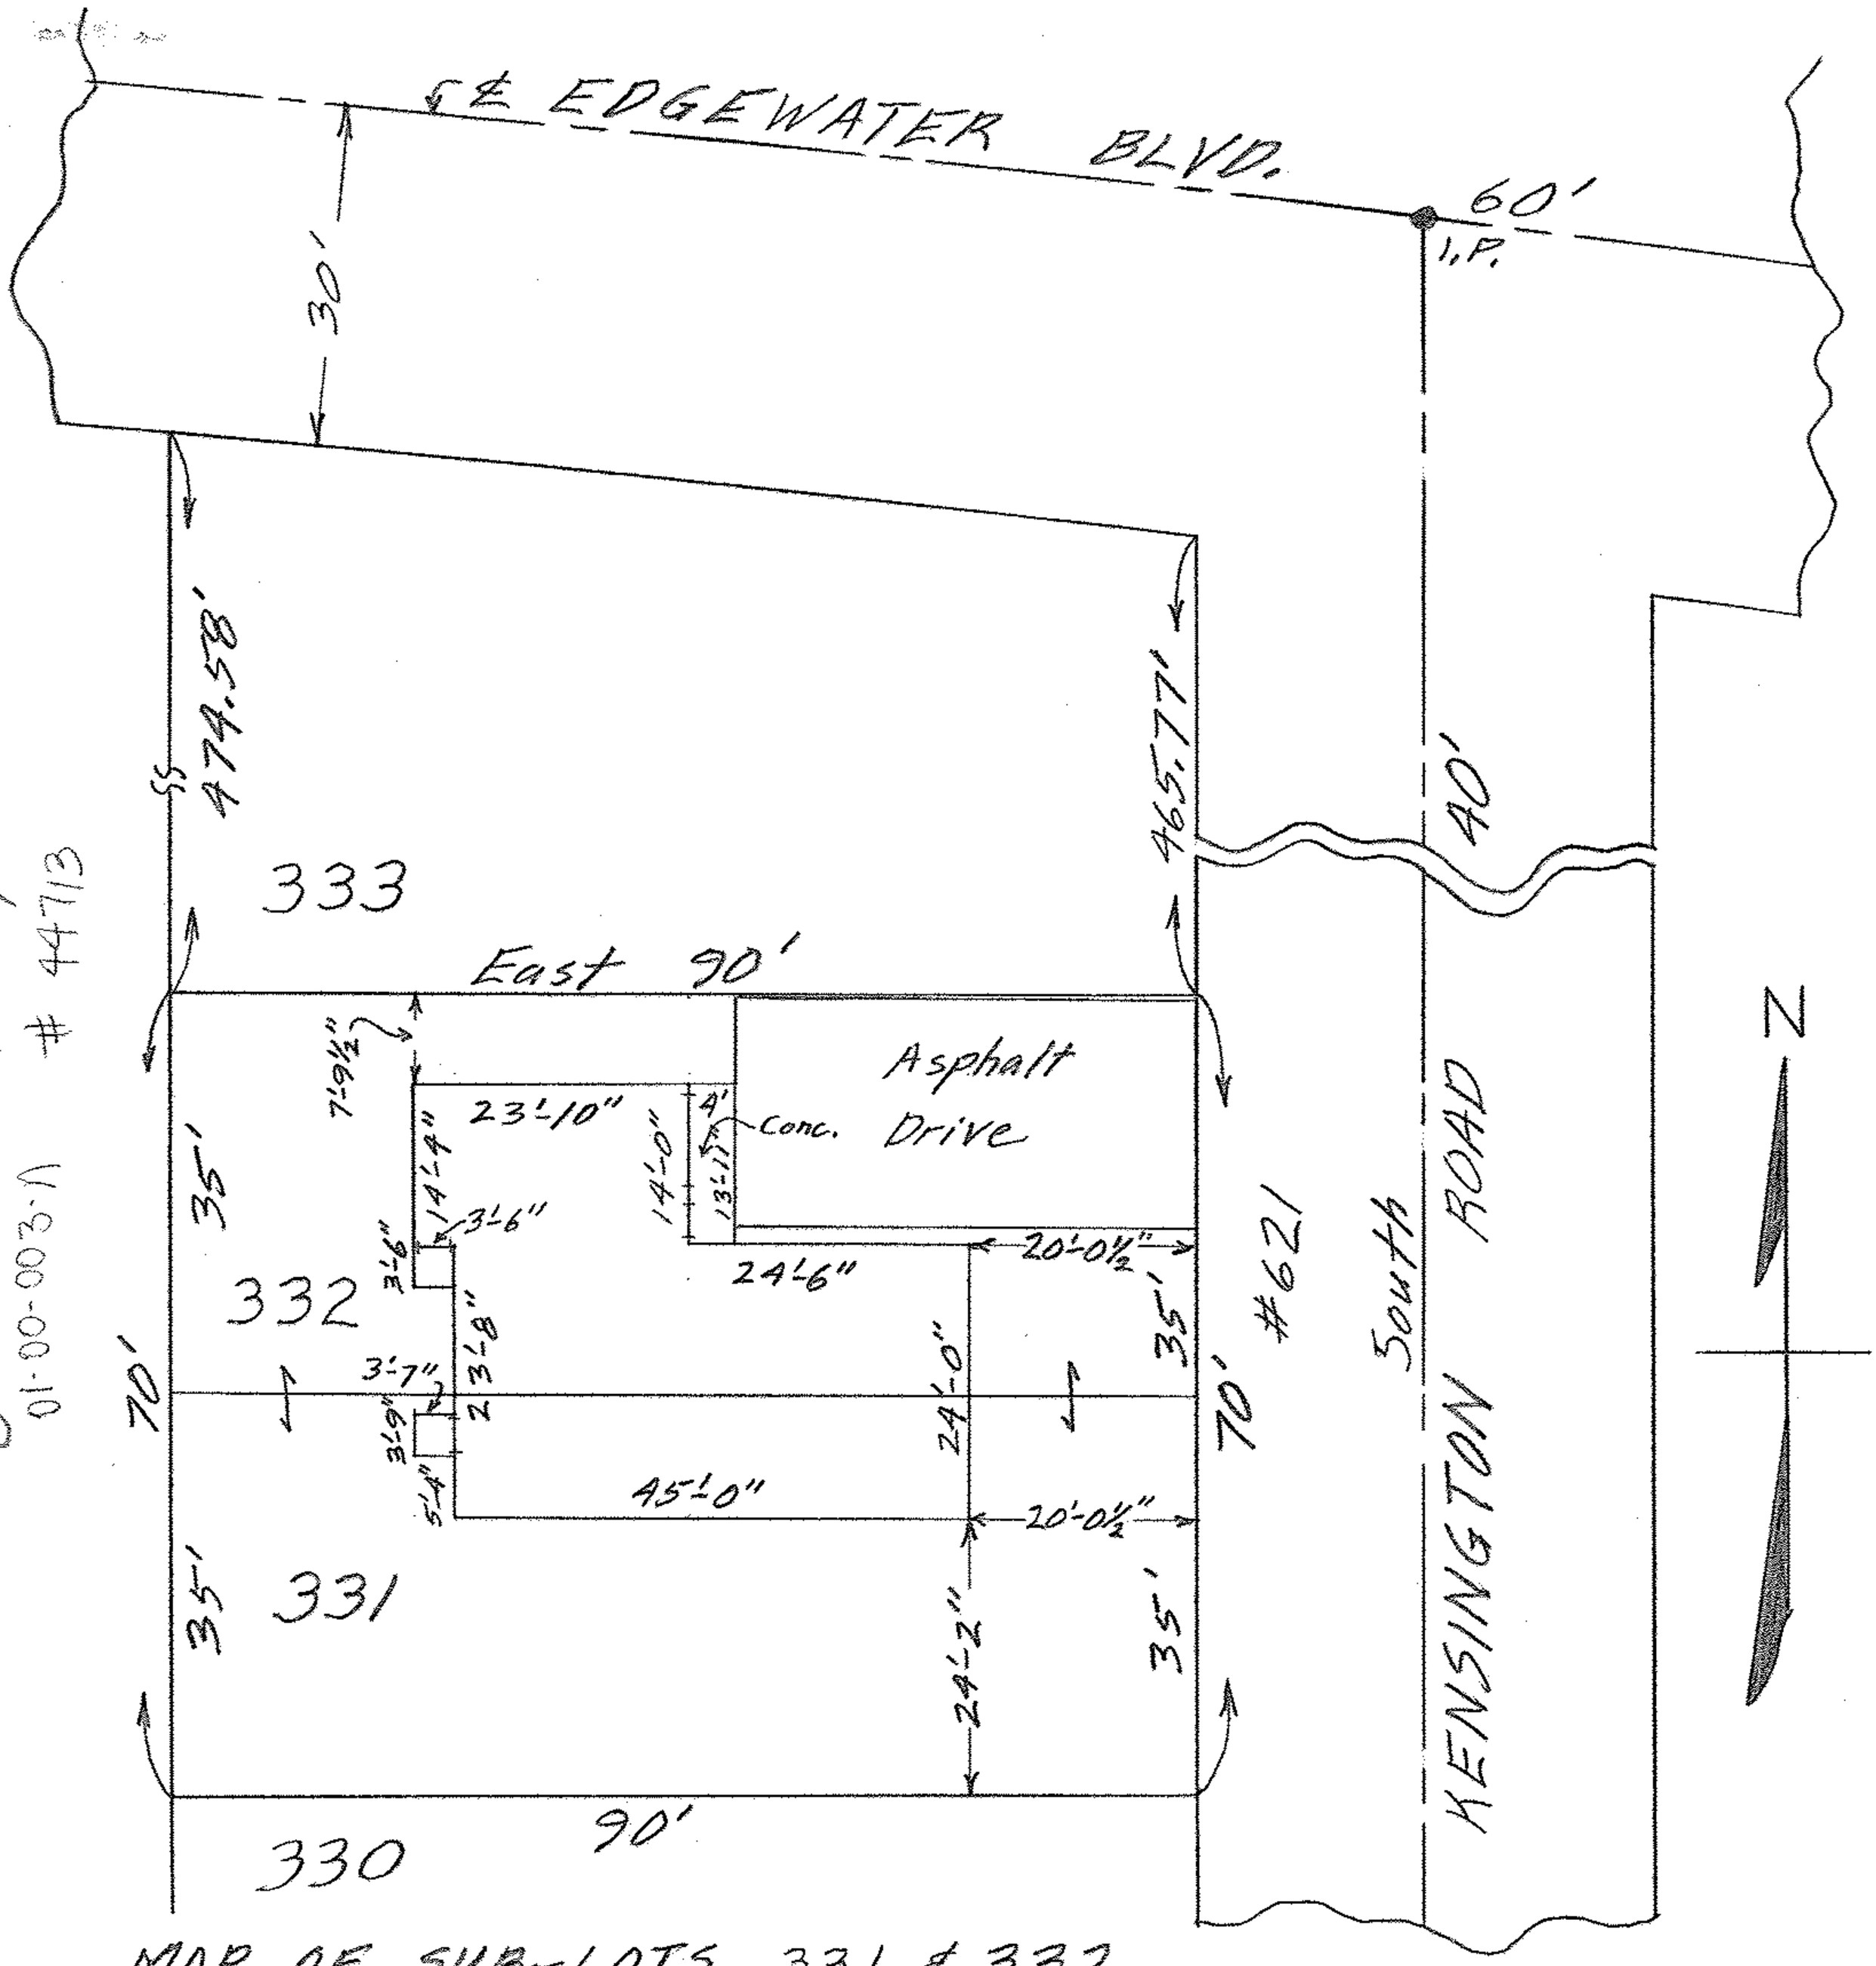

01-00-003-110-037
44713

MAP OF SUB-LOTS 331 & 332
VERMILION-ON-THE-LAKE SUB'N. NO. 1 Vol. 16 Pgs. 32 & 33
VERMILION-ON-THE-LAKE VILLAGE
LORAIN COUNTY OHIO
SCALE: 1"=20' FEB. 21-1964 5:30 P.M.
Gary E. Penfound REG. SURVEYOR
John D. Bunt, Jr. & Arbutus M. Bunt