
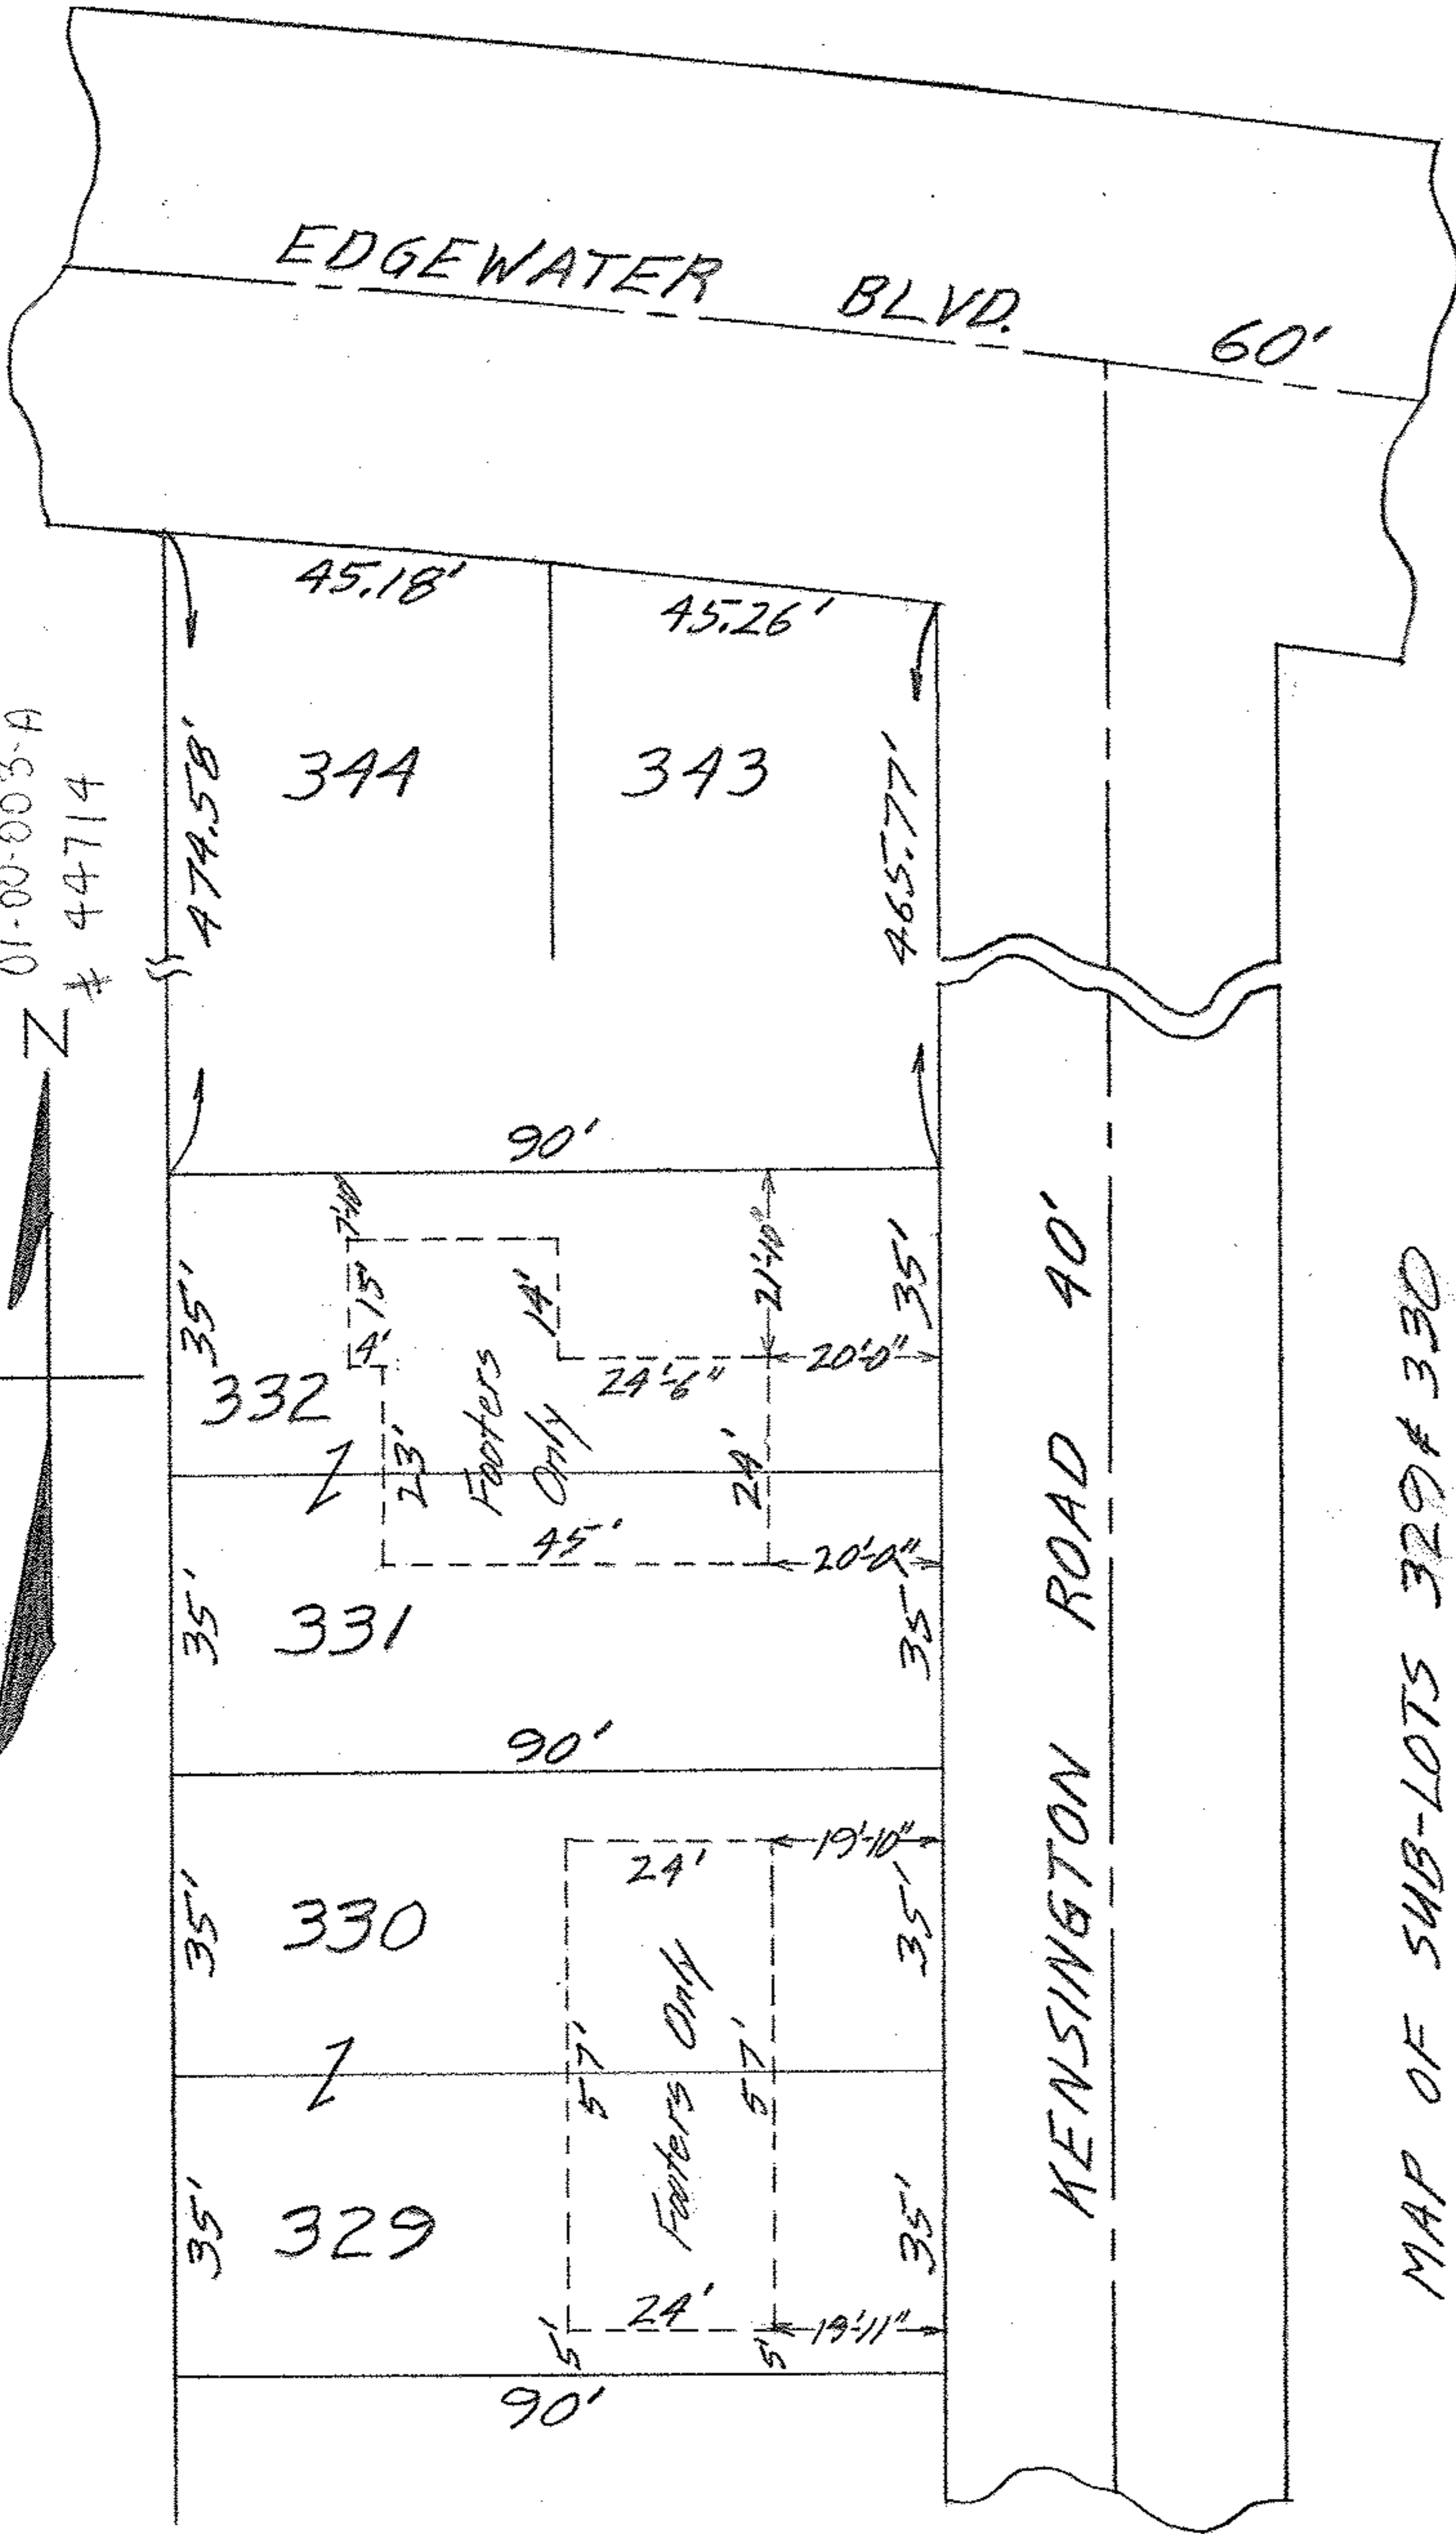


01-00-003-110-038, 037

01-00-003-A

44714

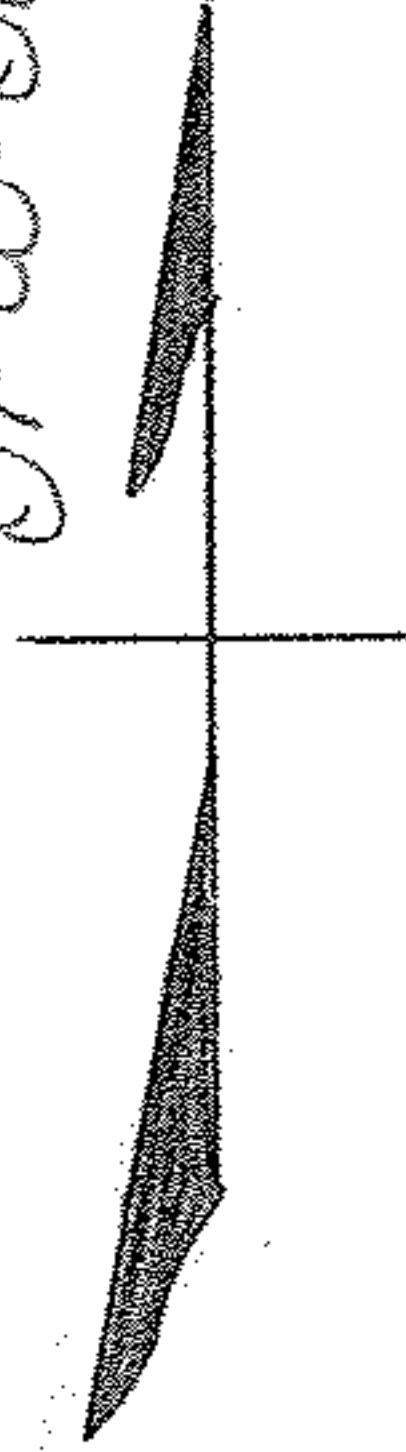

MAP OF SUB-LOTS 329 & 330

VERMILION ON THE LAKE SUB'D. NO. 1

VOL. 10 PGS. 18 & 19 AND VOL. 16 PGS. 32 & 33 PLATS

ORIG. LOTS 2 & 3 BROWNHELM TWP.

VERMILION - ON - THE - LAKE VILLAGE

LOBAIN COUNTY OHIO

SCALE: 1" = 30' FEB. 22-1961 1:30 P.M.

Mary E. Penfound

for C. E. Penfound

REG. SURVEYORS

CH-8286 John A. & Marie Bader