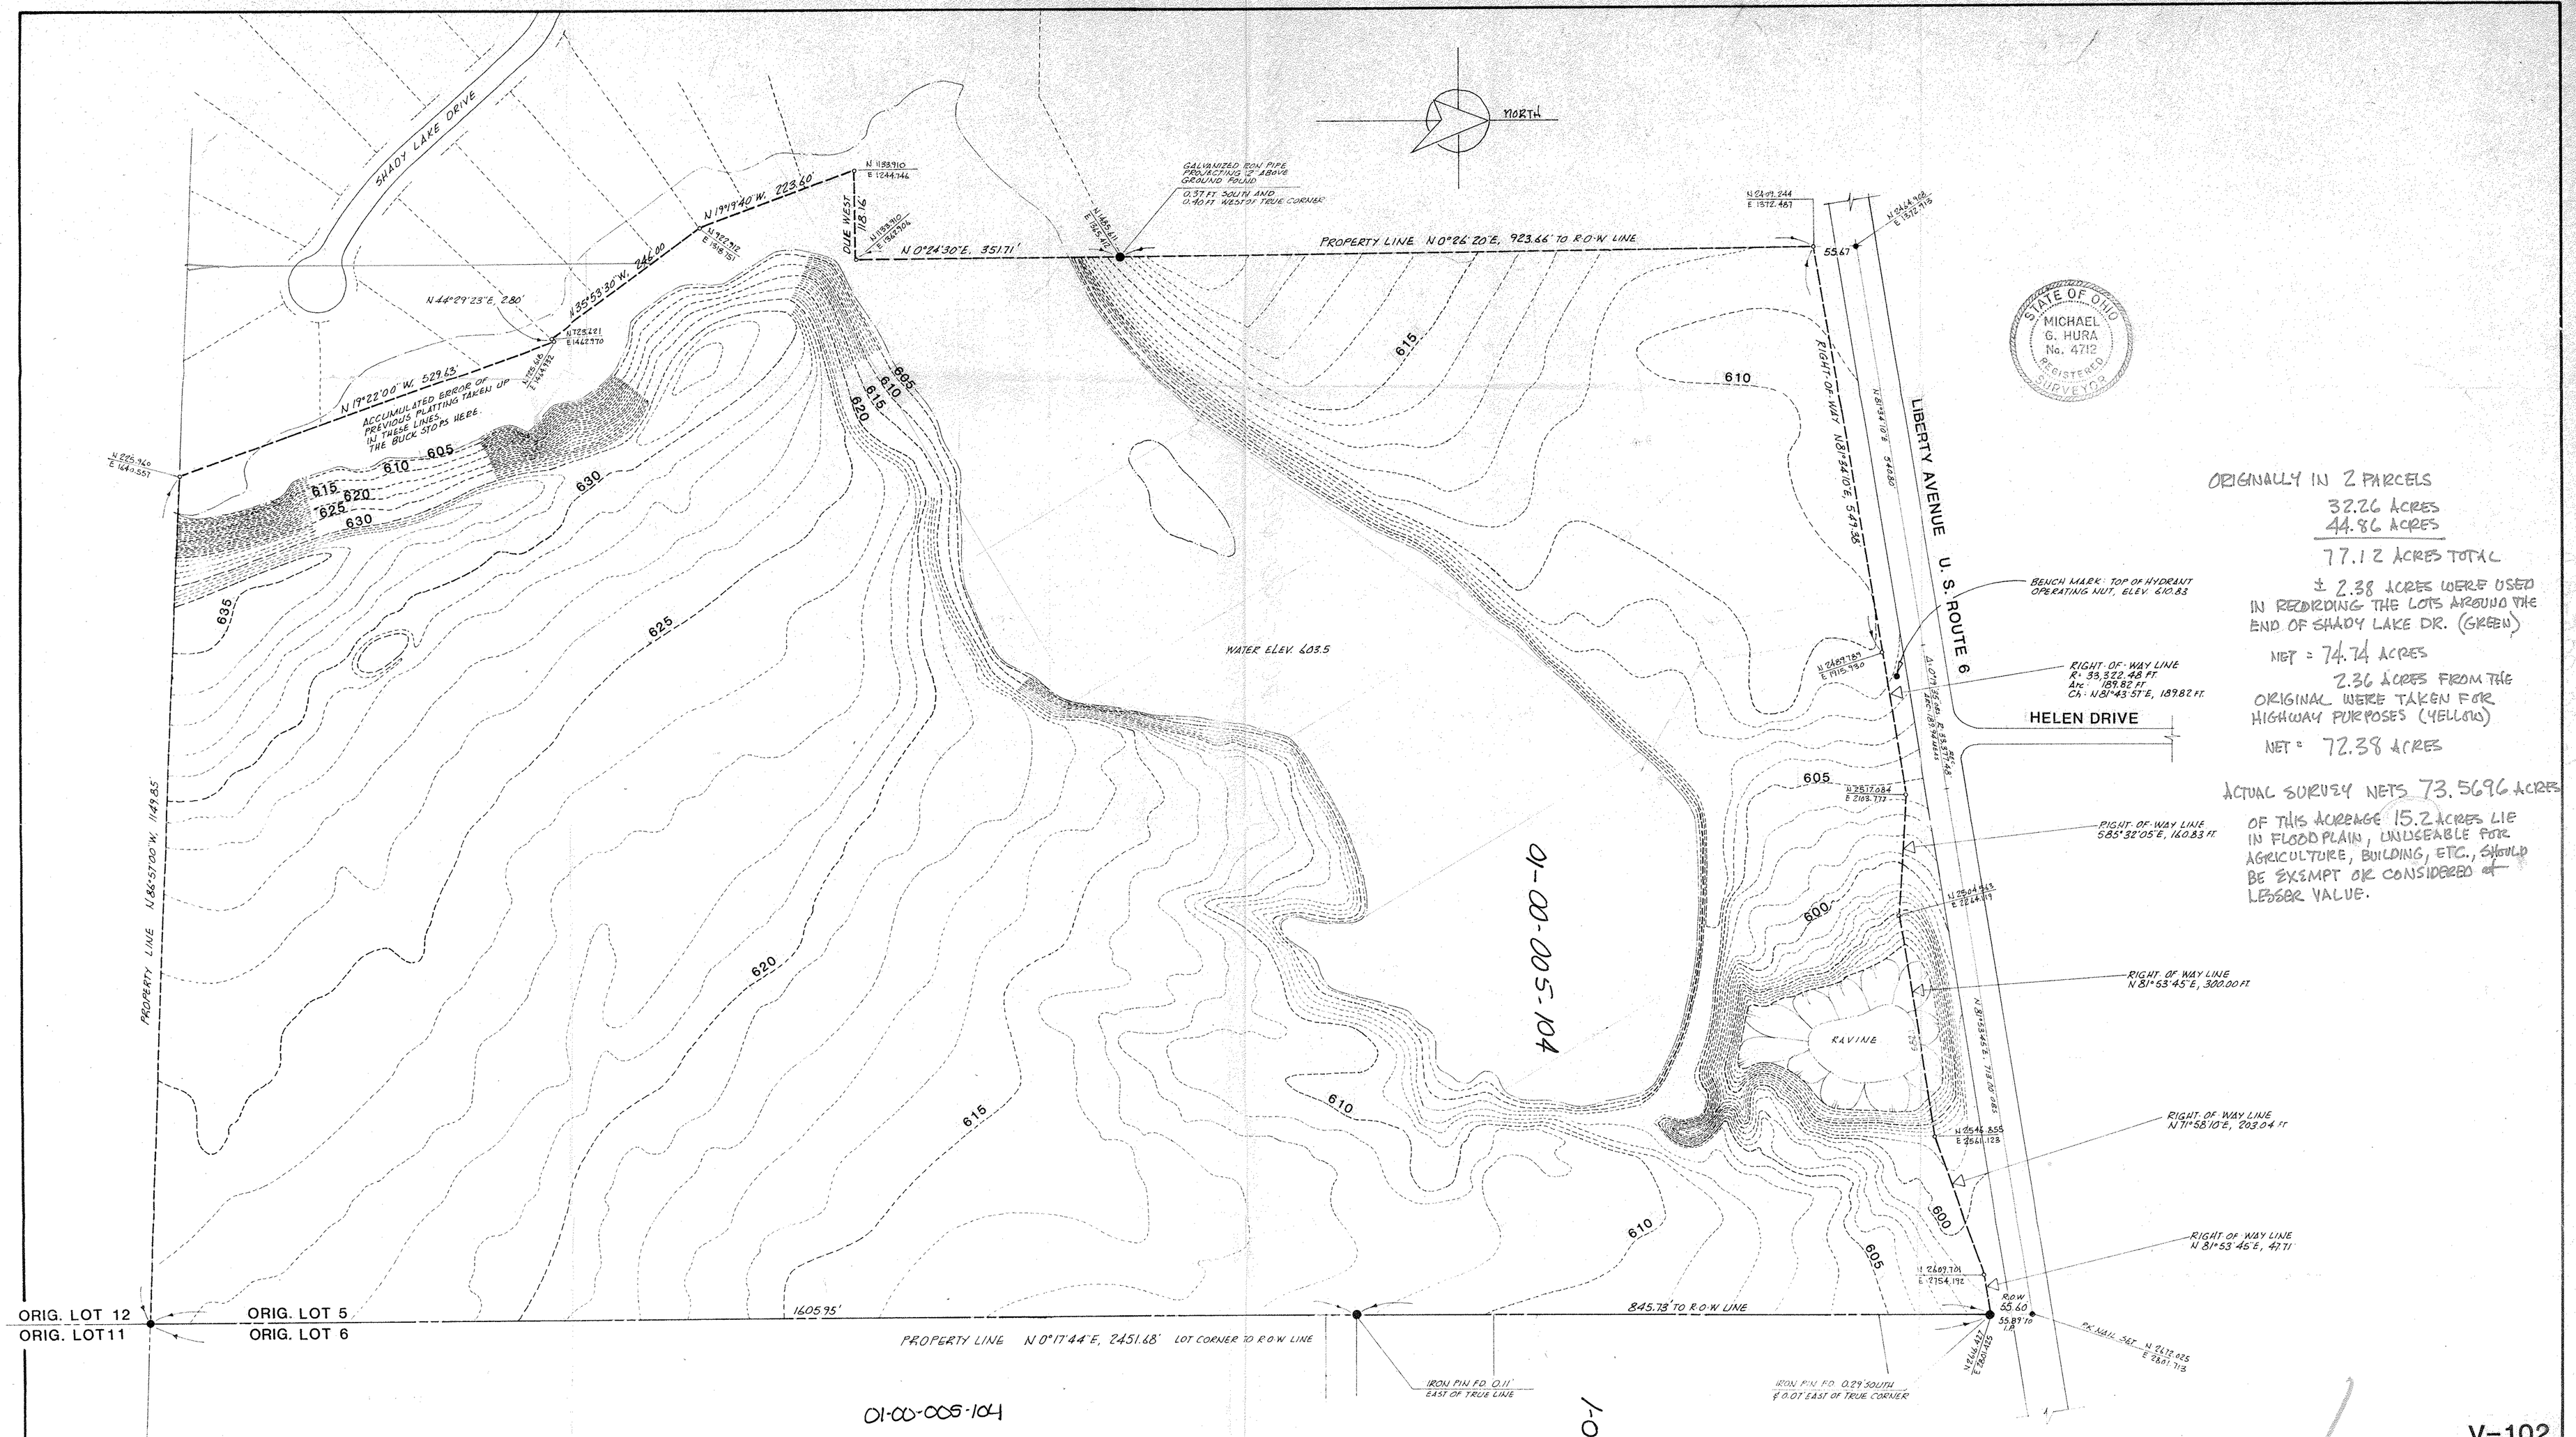

ORIGINALLY IN 2 PARCELS

32.26 ACRES
44.86 ACRES

77.12 ACRES TOTAL

± 2.38 ACRES WERE USED IN REDRIDING THE LOTS AROUND THE END OF SHADY LAKE DR. (GREEN)

NET = 74.74 ACRES

2.36 ACRES FROM THE ORIGINAL WERE TAKEN FOR HIGHWAY PURPOSES (YELLOW)

NET = 72.38 ACRES

ACTUAL SURVEY NETS 73.5696 ACRES

OF THIS ACREAGE 15.2 ACRES LIE IN FLOODPLAIN, UNUSEABLE FOR AGRICULTURE, BUILDING, ETC., SHOULD BE EXEMPT OR CONSIDERED OF LESSER VALUE.

V-102

Michael G. Hura and Associates
4560 LIBERTY AVENUE, VERMILION, OHIO
A Division of National Survey Service, Inc.

ENGINEERING
SURVEYING
IMAGINATION

PREPARED FOR

PERIMETER SURVEY & GENERAL TOPOGRAPHY - 73.5696 ACRE PARCEL
PART OF ORIGINAL BROWNHELM TOWNSHIP LOT 5.
NOW CITY OF VERMILION, LORAIN COUNTY, OHIO

REVISION No.	DATE	DESCRIPTION

DATE 02-15-80
DRAWN MGH
SCALE 1" = 100'
CHECKED
REFERENCE No

DRAWING No V-102
SHEET 1 OF 1