


01-00-016-115-021

01-00-016-A

44723

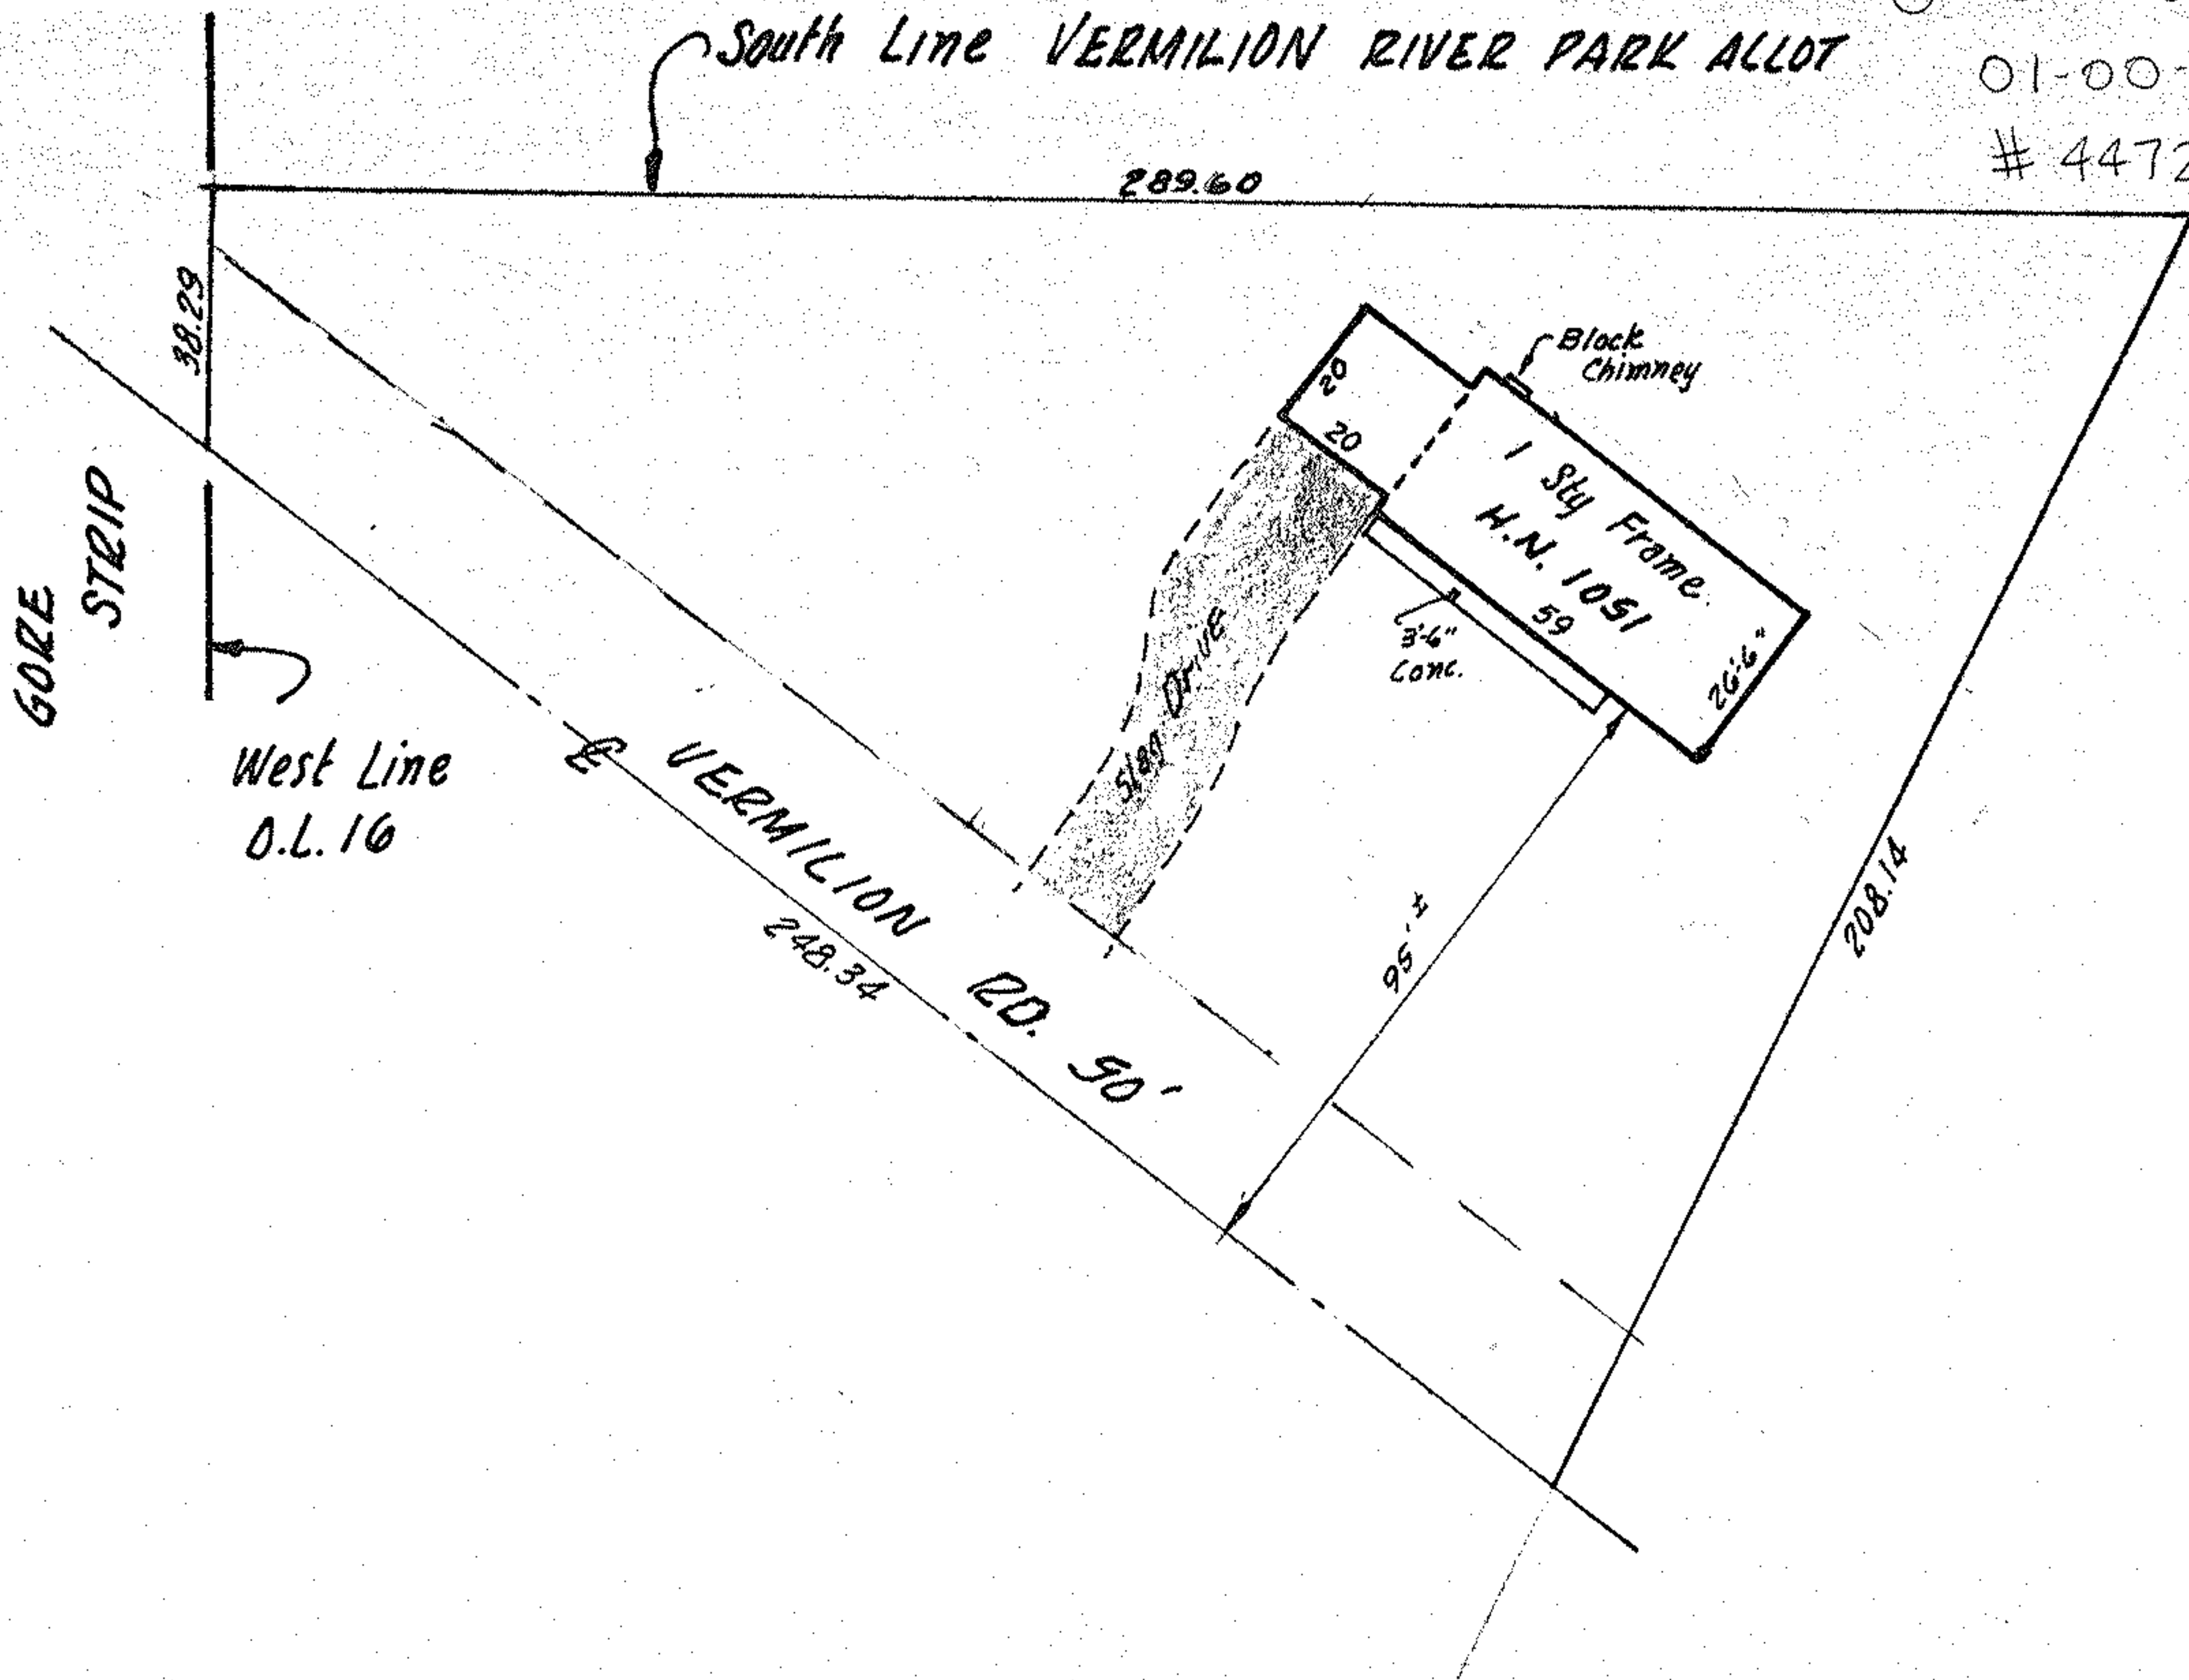

1" = 40'

P.P. # 01-00-016-115-021 .6675 Ac
 Part of ORIG. BROWHELM TWP. O.L. 16
 NOW in CITY OF VERMILION, OHIO

Mc GLINCHY & ASSOCIATES
 FEB. 9, 1976 # 76733

Parcel #2
 LT # EL 43,591