01-00-046-000-004, 005, 006

01-00-046-A

44728

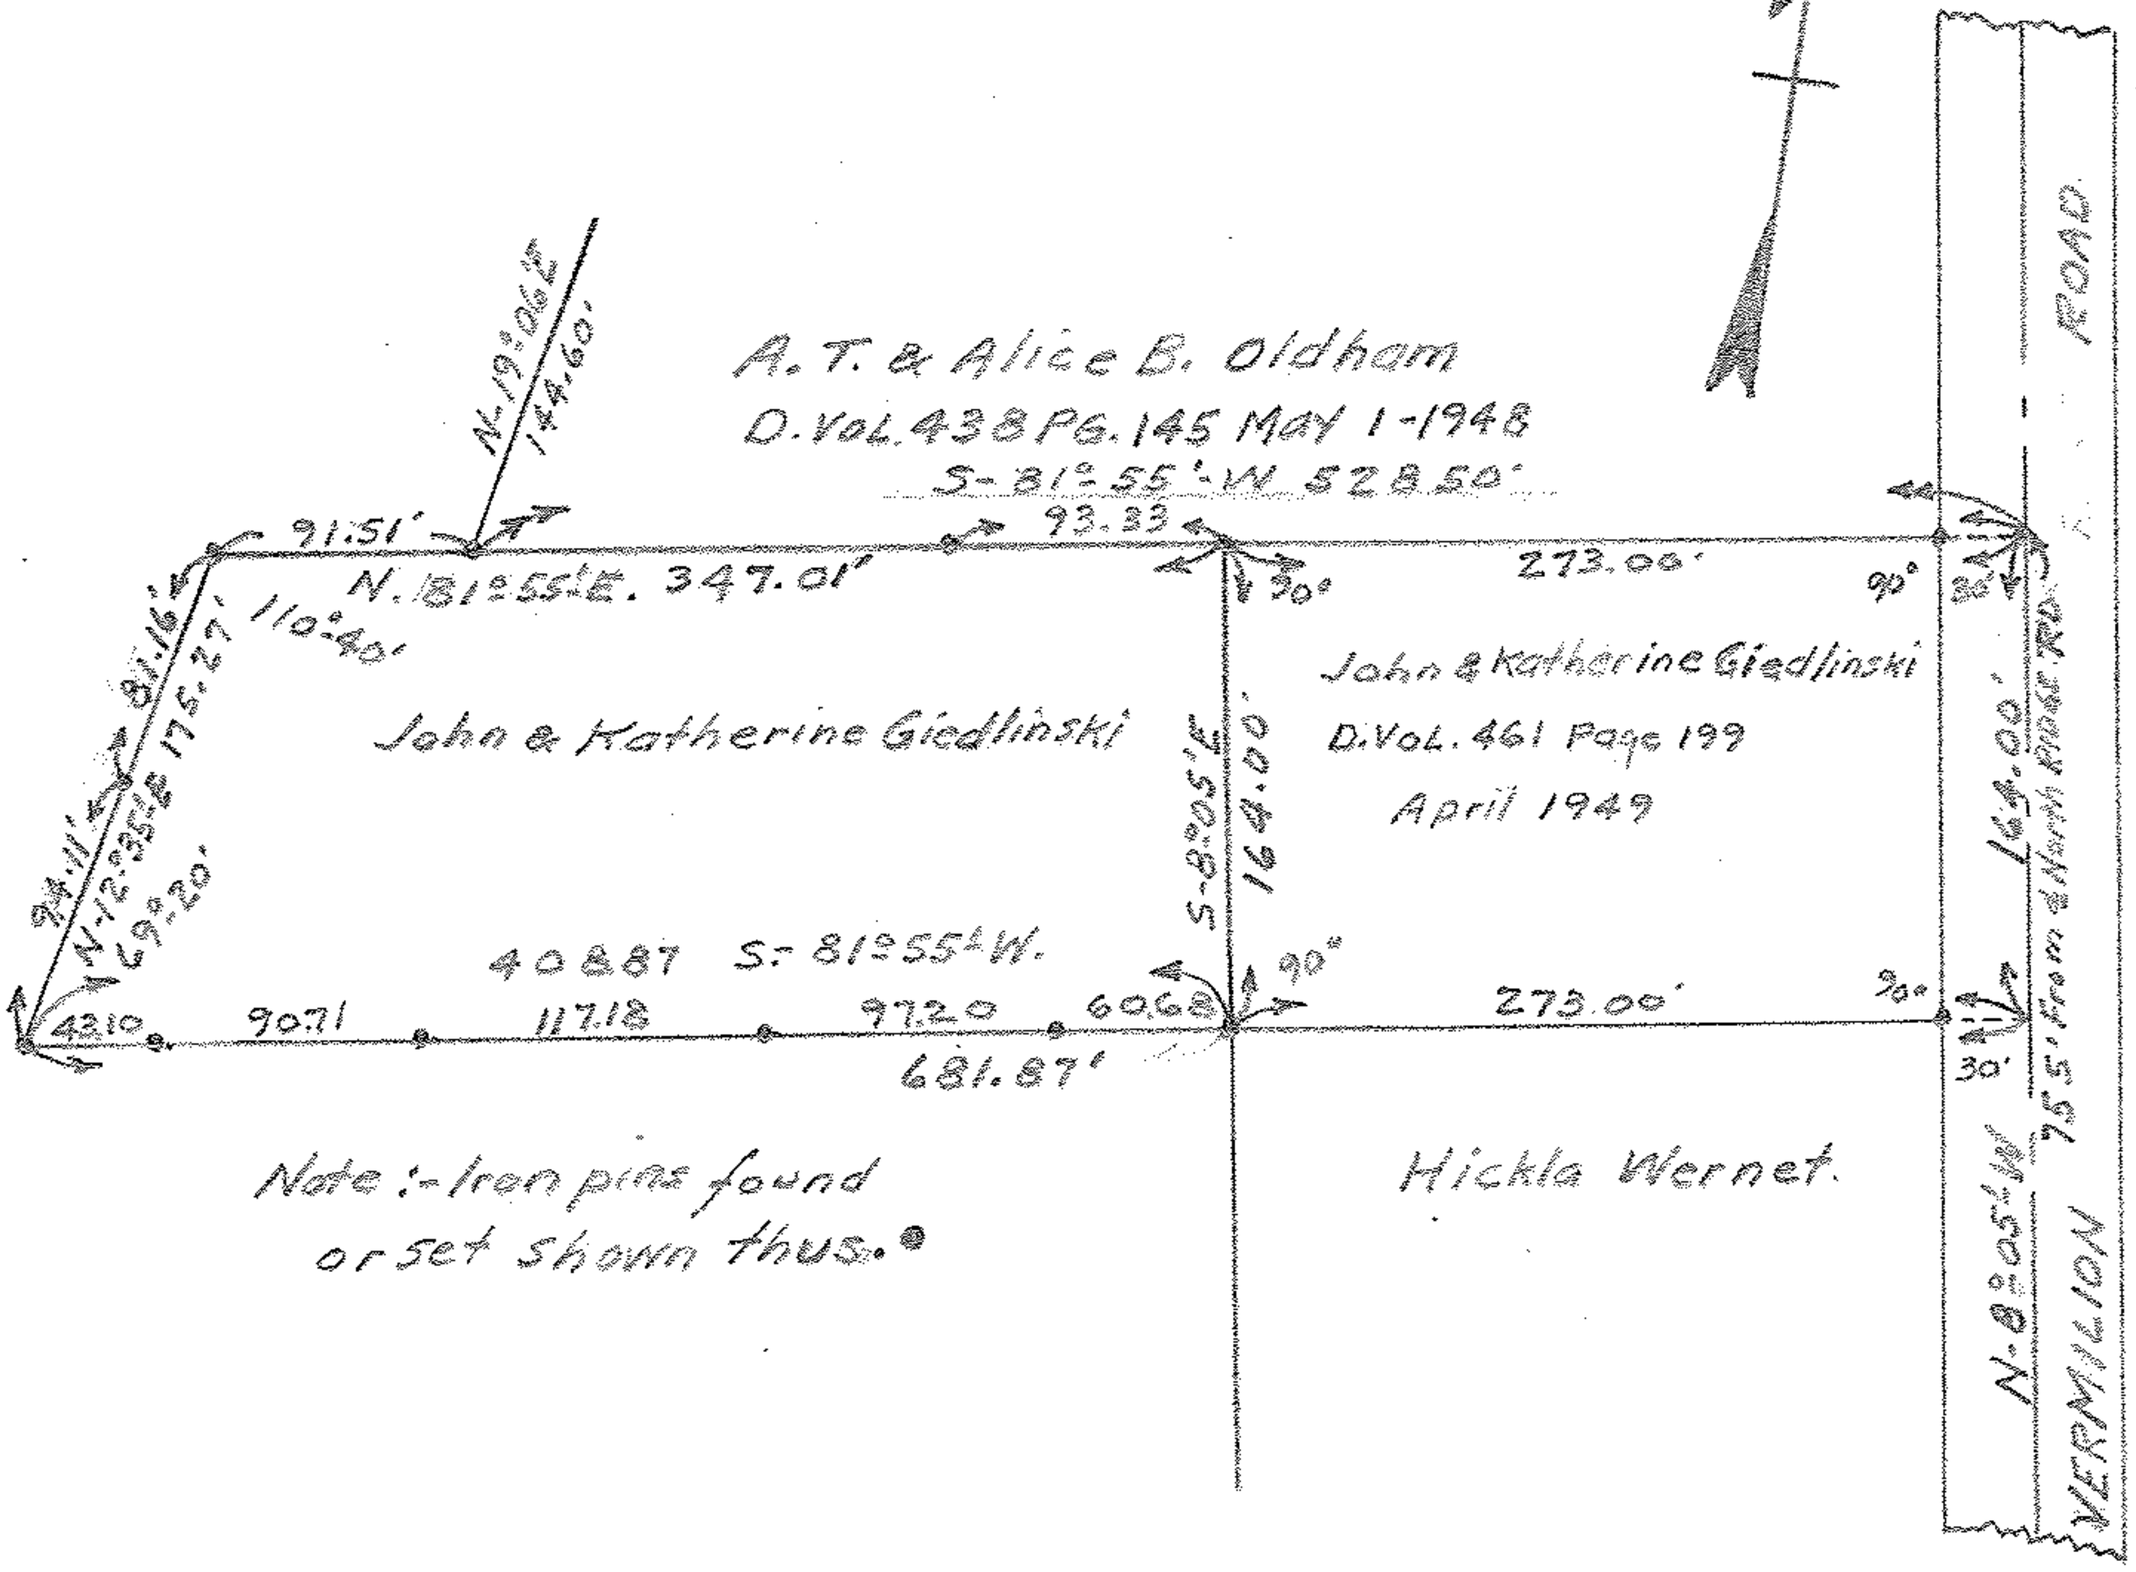

Note :- Iron pins found or set shown thus. ⊕

SURVEY FOR
John & Katherine Giedlinski
O.L. 46 BROWNHELM TOWNSHIP
LORAIN COUNTY OHIO
Scale 1" = 100 FT. May 15-1950
C.E. Penfound Registered Surveyor