44783

04-00-025-000-116
04-00-025-E,F

LAUNDON • SIMON • CAHL & ASSOC., INC.
CONSULTING ENGINEERS & SURVEYORS
110 MIDDLE AVE., ELYRIA, O. 44035

SURVEY FOR:

RONALD T. ZALESKI
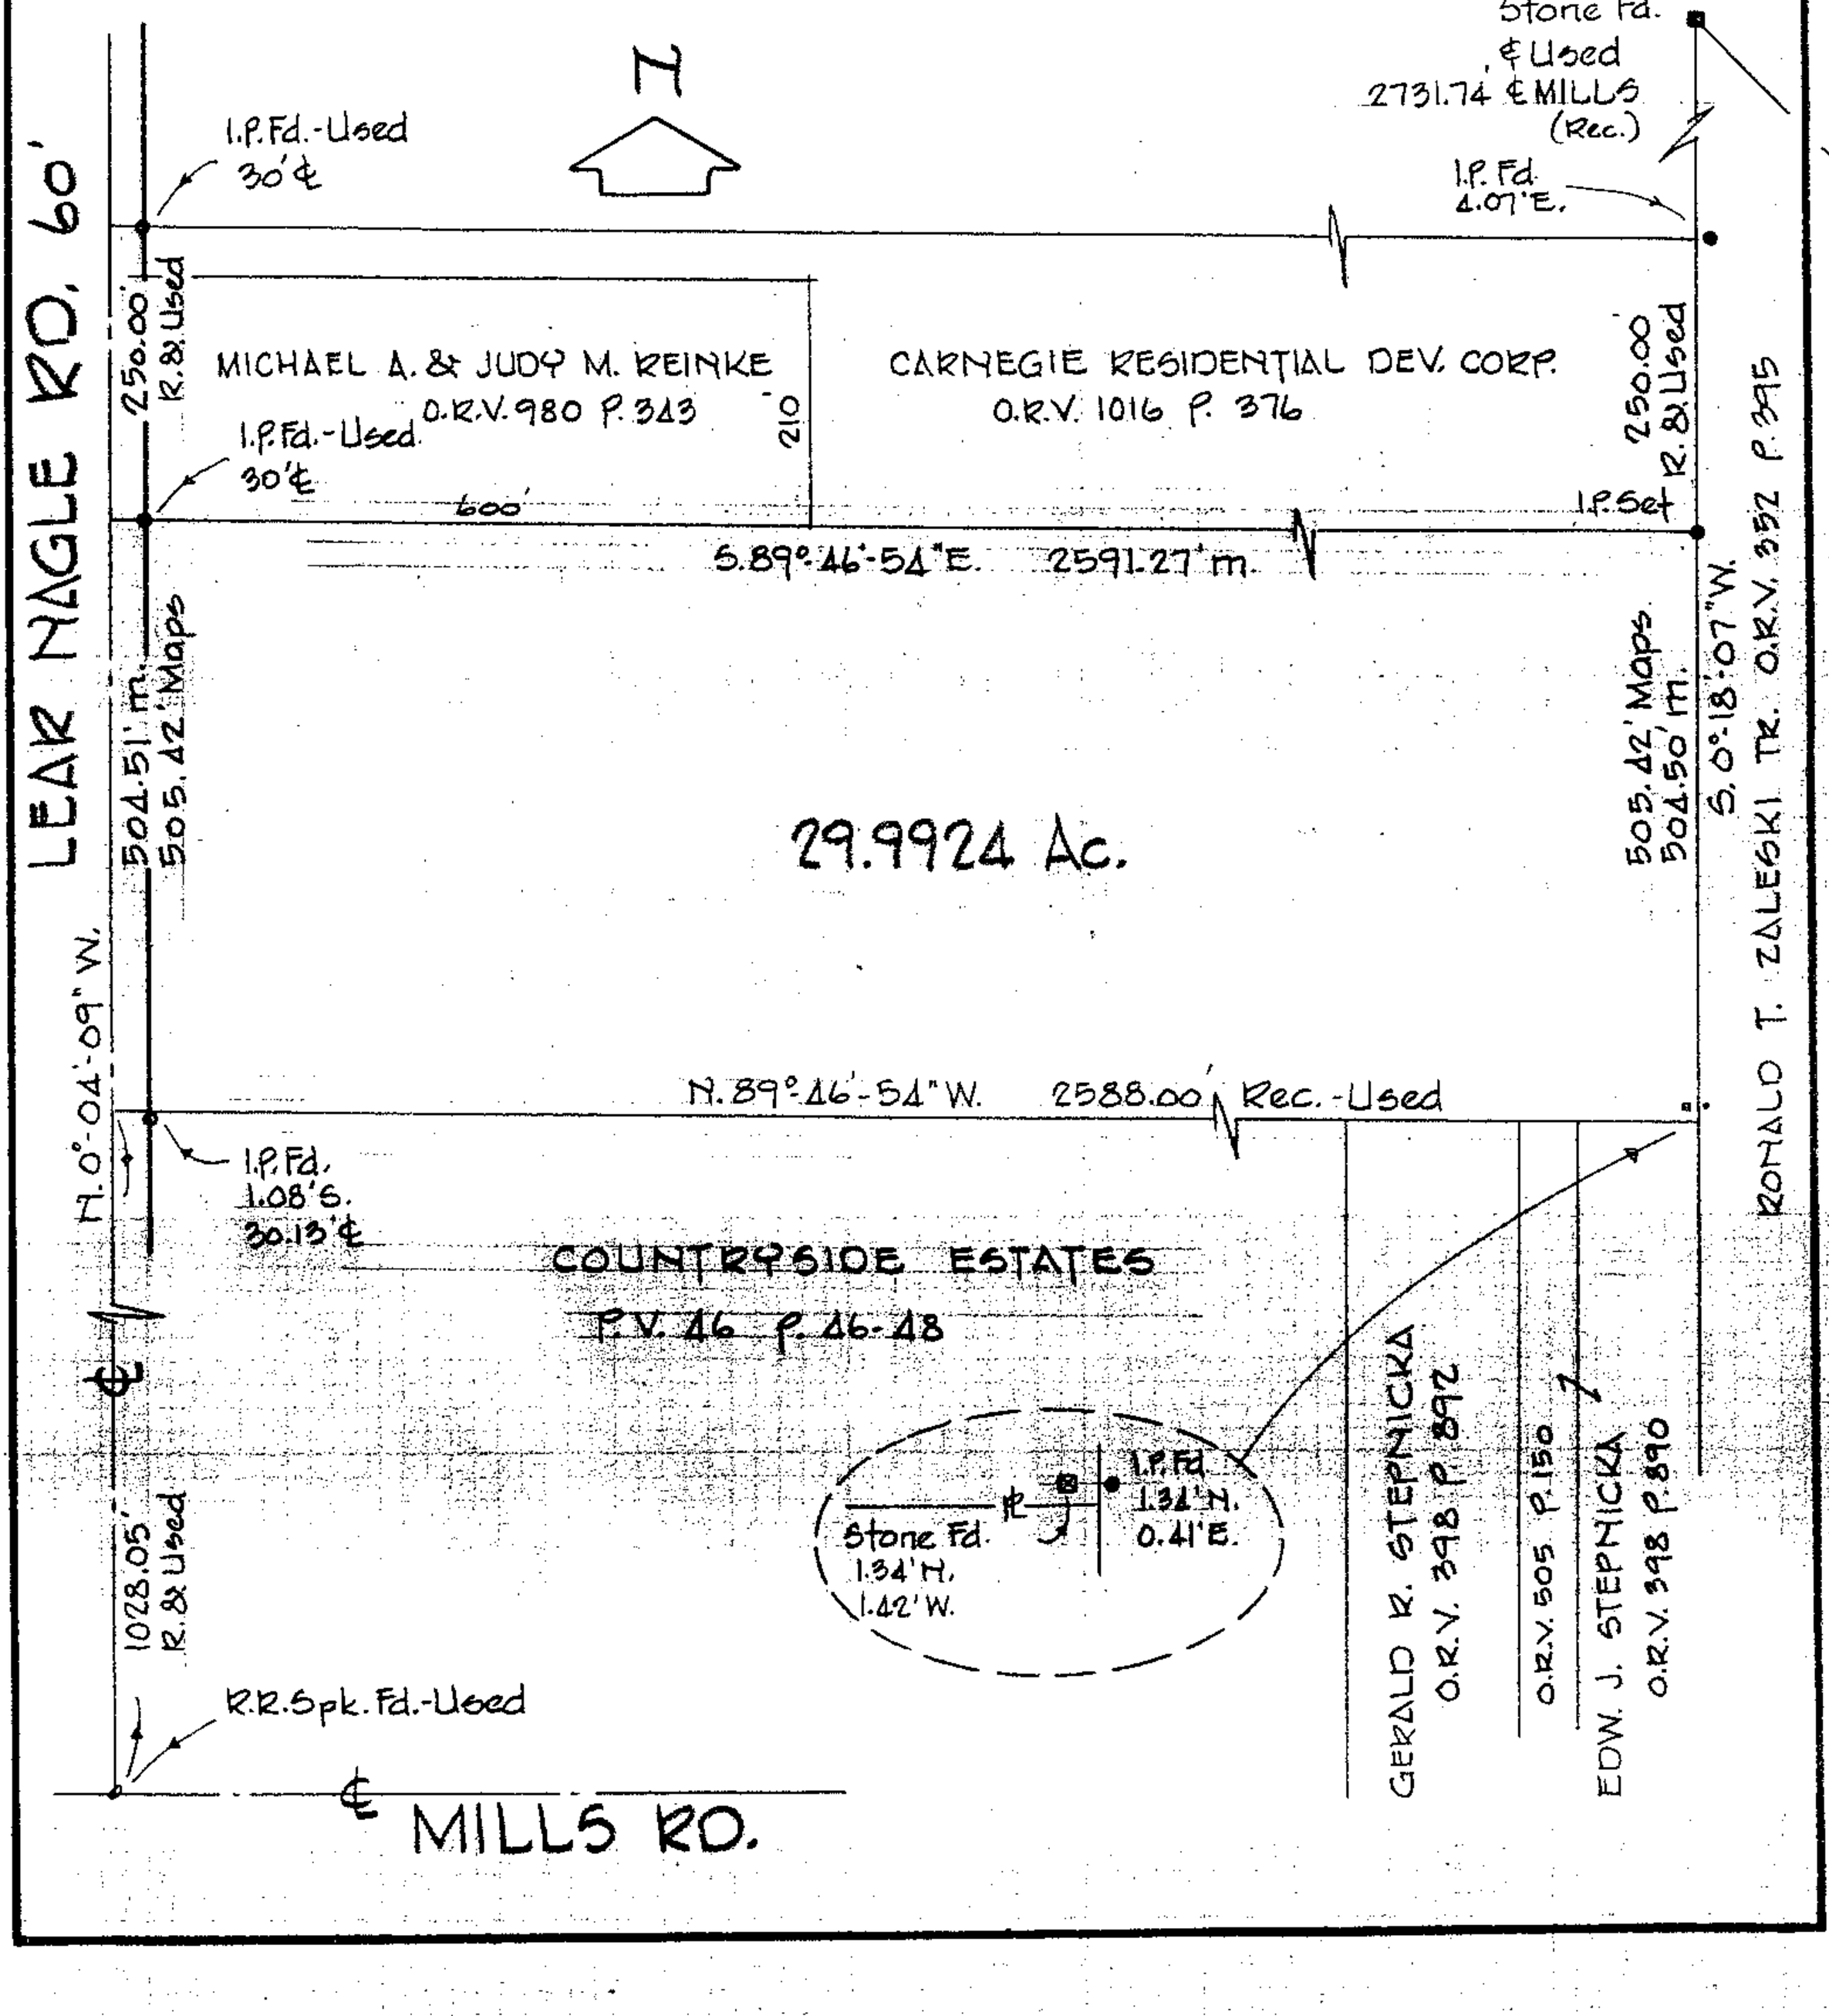
Orig. Lot	City of AVON	Date MAR. '95 Scale 1"=200'
Orig. Sec 25	Village of	Dwn. by R.G.S. Chkd. by R.C.
Tract	County of LORAIN	Job No. 95-2689 F.B.
Township of AVON	State of OHIO	Printed