#44791

14-00-062-000-016
14-D

LAUNDON • SIMON • CAHL & ASSOC., INC.
CONSULTING ENGINEERS & SURVEYORS
110 MIDDLE AVE., ELYRIA, O. 44035

SURVEY FOR:
TIM H. WEAVER
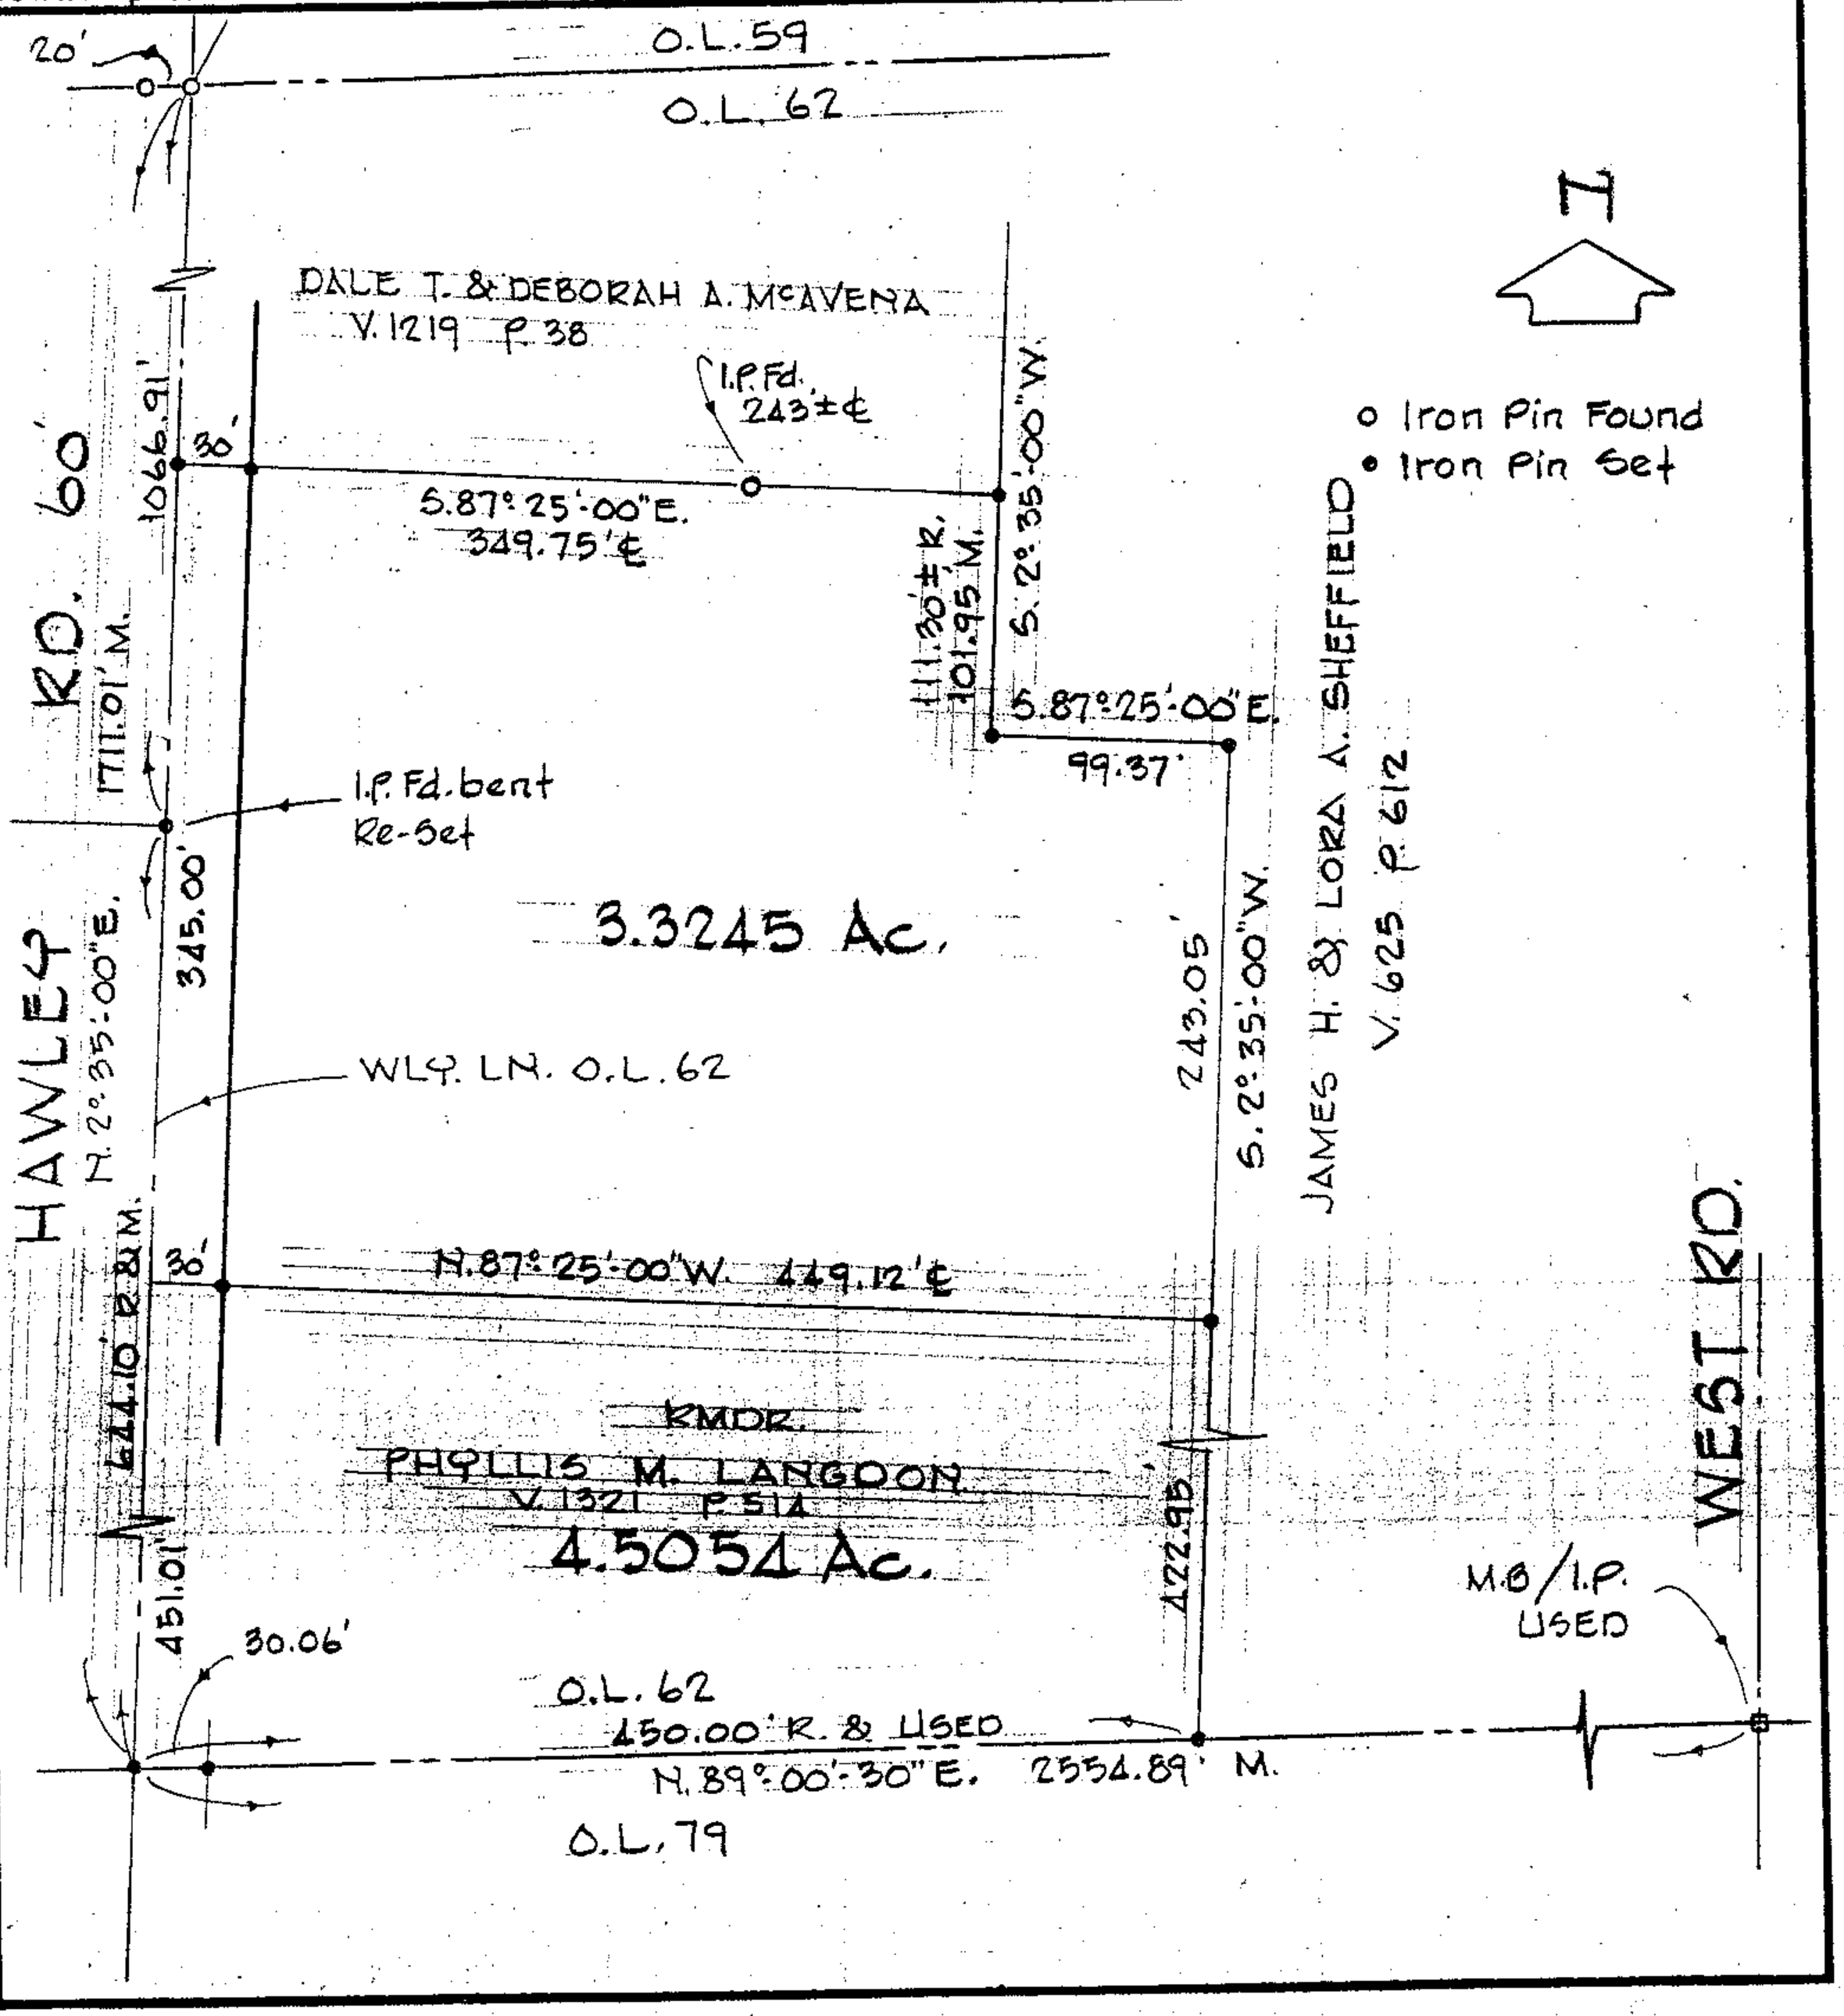
Orig. Lot 62	City of	Date AUG. '94 Scale 1"=100'
Orig. Sec	Village of	Dwn. by R.G.S. Chkd. by R.C.
Tract	County of LORAIN	Job No. 94-2618 F.B. 233/31
Township of PITTSFIELD	State of OHIO	Printed