# 44797

09-00-084-101-049 thru -052

LAUNDON • SIMON • CAHL & ASSOC., INC.
CONSULTING ENGINEERS & SURVEYORS
110 MIDDLE AVE., ELYRIA, O. 44035

SURVEY FOR: 09-00-084-B

# CATHY A. IVES
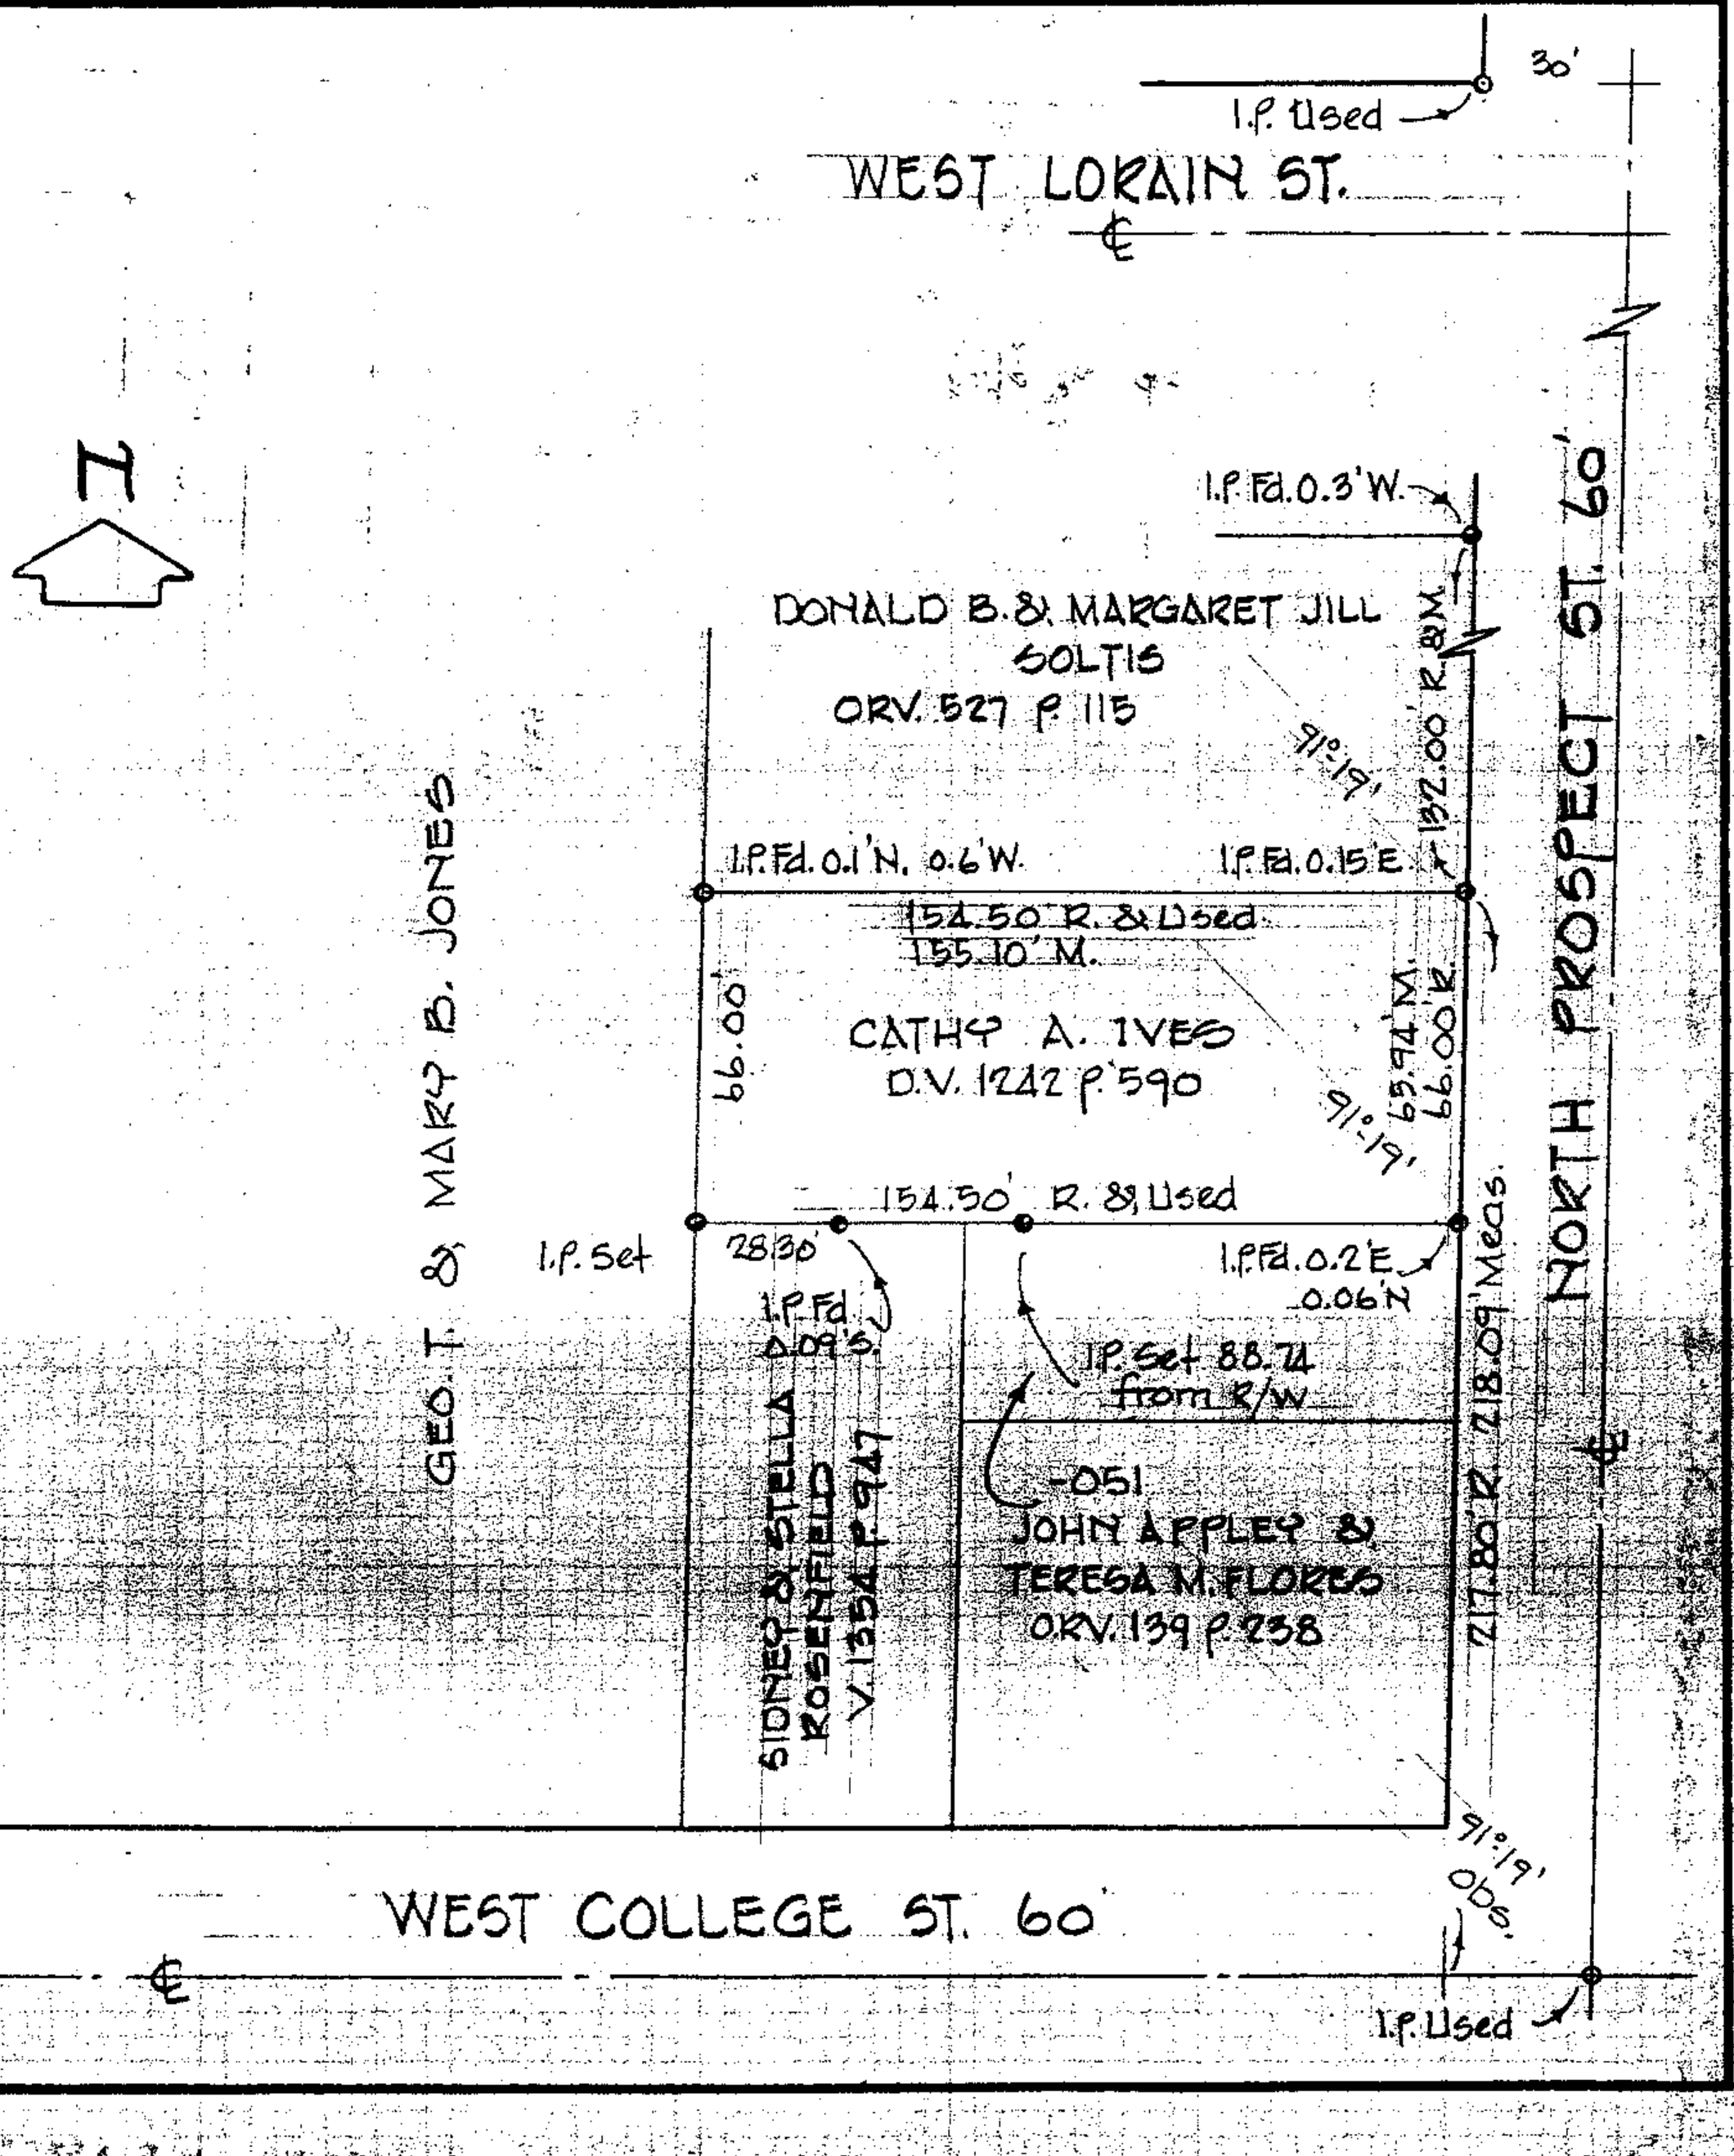
| | | |
|---|---|---|
| Orig. Lot 85-84 | City of OBERLIN | Date SEPT. '94 Scale 1"=50' |
| Orig. Sec. | Village of | Dwn. by R.G.S. Chkd. by R.C. |
| Tract | County of LORAIN | Job No. 94-2598 F.B. 233/42 |
| Township of RUSSIA | State of OHIO | Printed |