44817

04-00-011-108-019
04-00-011-H

LAUNDON • SIMON • CAHL & ASSOC., INC.
CONSULTING ENGINEERS & SURVEYORS
110 MIDDLE AVE., ELYRIA, O. 44035

SURVEY FOR:

ANNA N. VONTORCIK
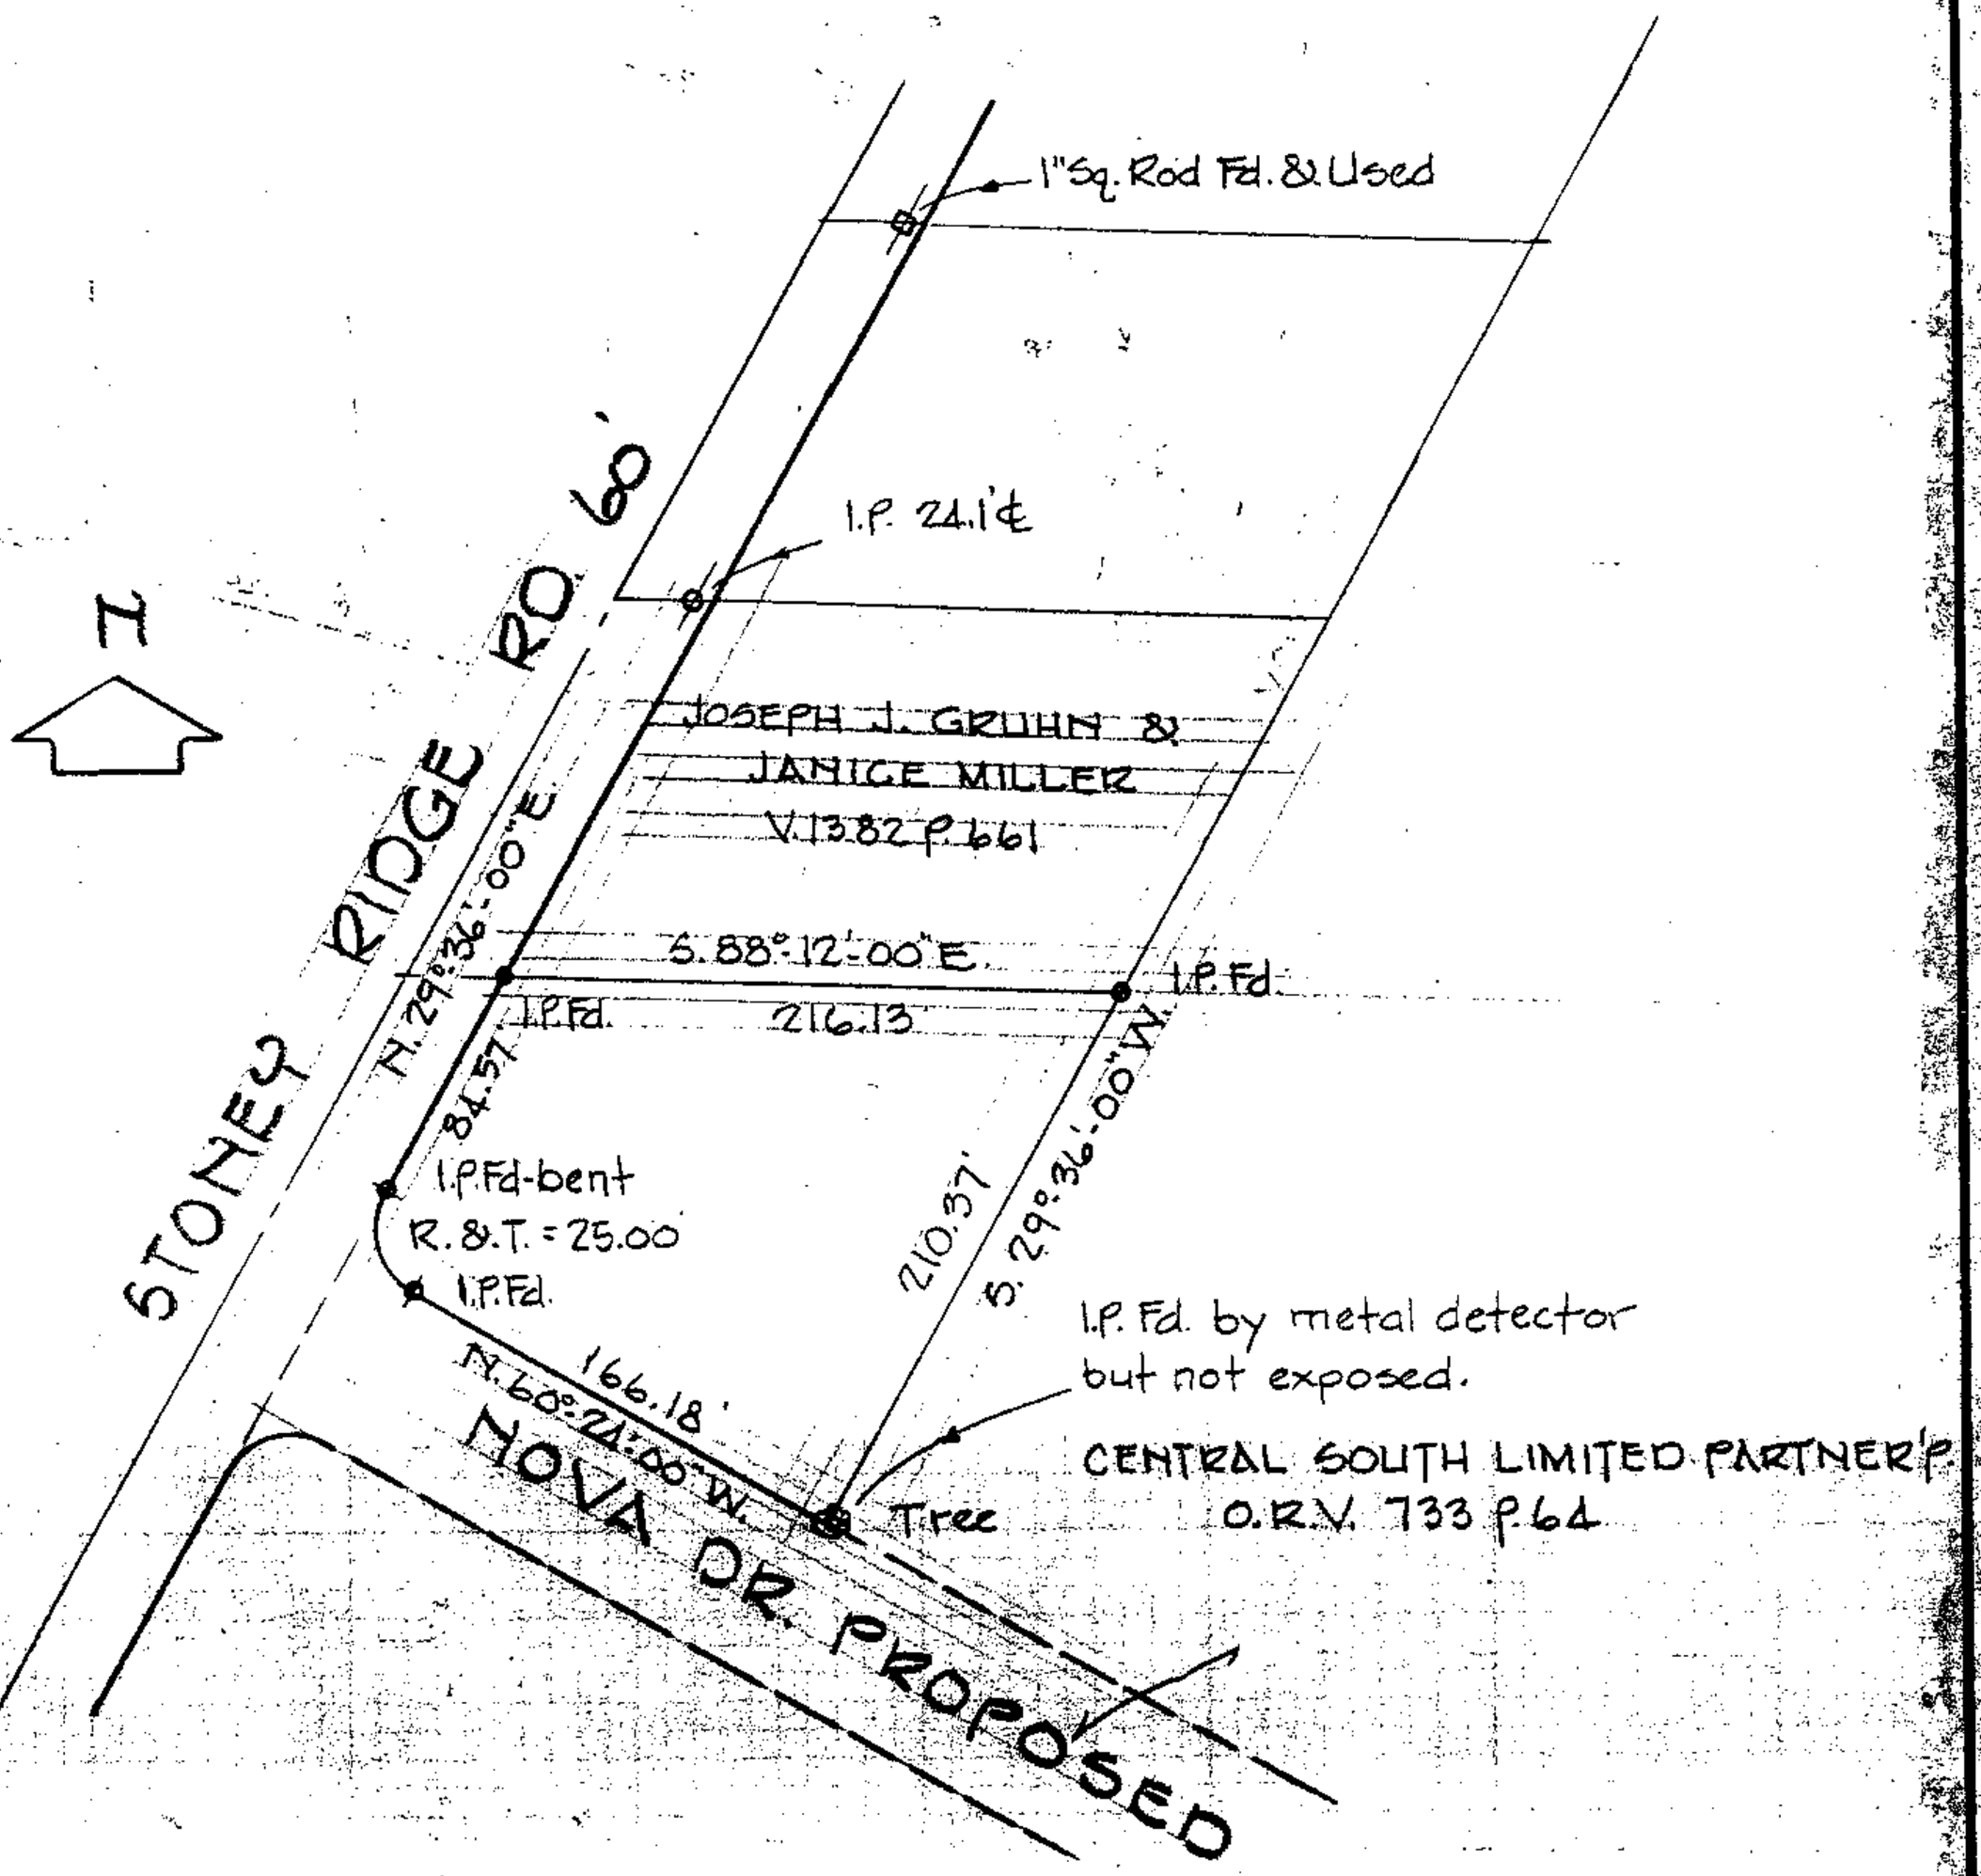
Orig. Lot	City of AVON	Date 8-3-93 Scale 1"=100'
Orig. Sec 11	Village of	Dwn. by R.G.S. Chkd. by R.C.
Tract	County of LORAIN	Job No. 93-2444 F.B. 229/69
Township of AVON	State of OHIO	Printed