44824

05-00-011-101-022 thru 028

LAUNDON • SIMON • CAHL & ASSOC., INC.
CONSULTING ENGINEERS & SURVEYORS
110 MIDDLE AVE., ELYRIA, O. 44035

SURVEY FOR 05-00-011-A

ROBT. P. & MARIAN J. KOVACH

Orig. Lot 11	City of	Date FEB. 5, '93 Scale 1" = 60'
Orig. Sec	Village of SOUTH AMHERST	Dwn. by R.G.S. Chkd. by R.C.
Tract	County of LORAIN	Job No. 93-2294 F.B. 229/2
Township of AMHERST	State of OHIO	Printed

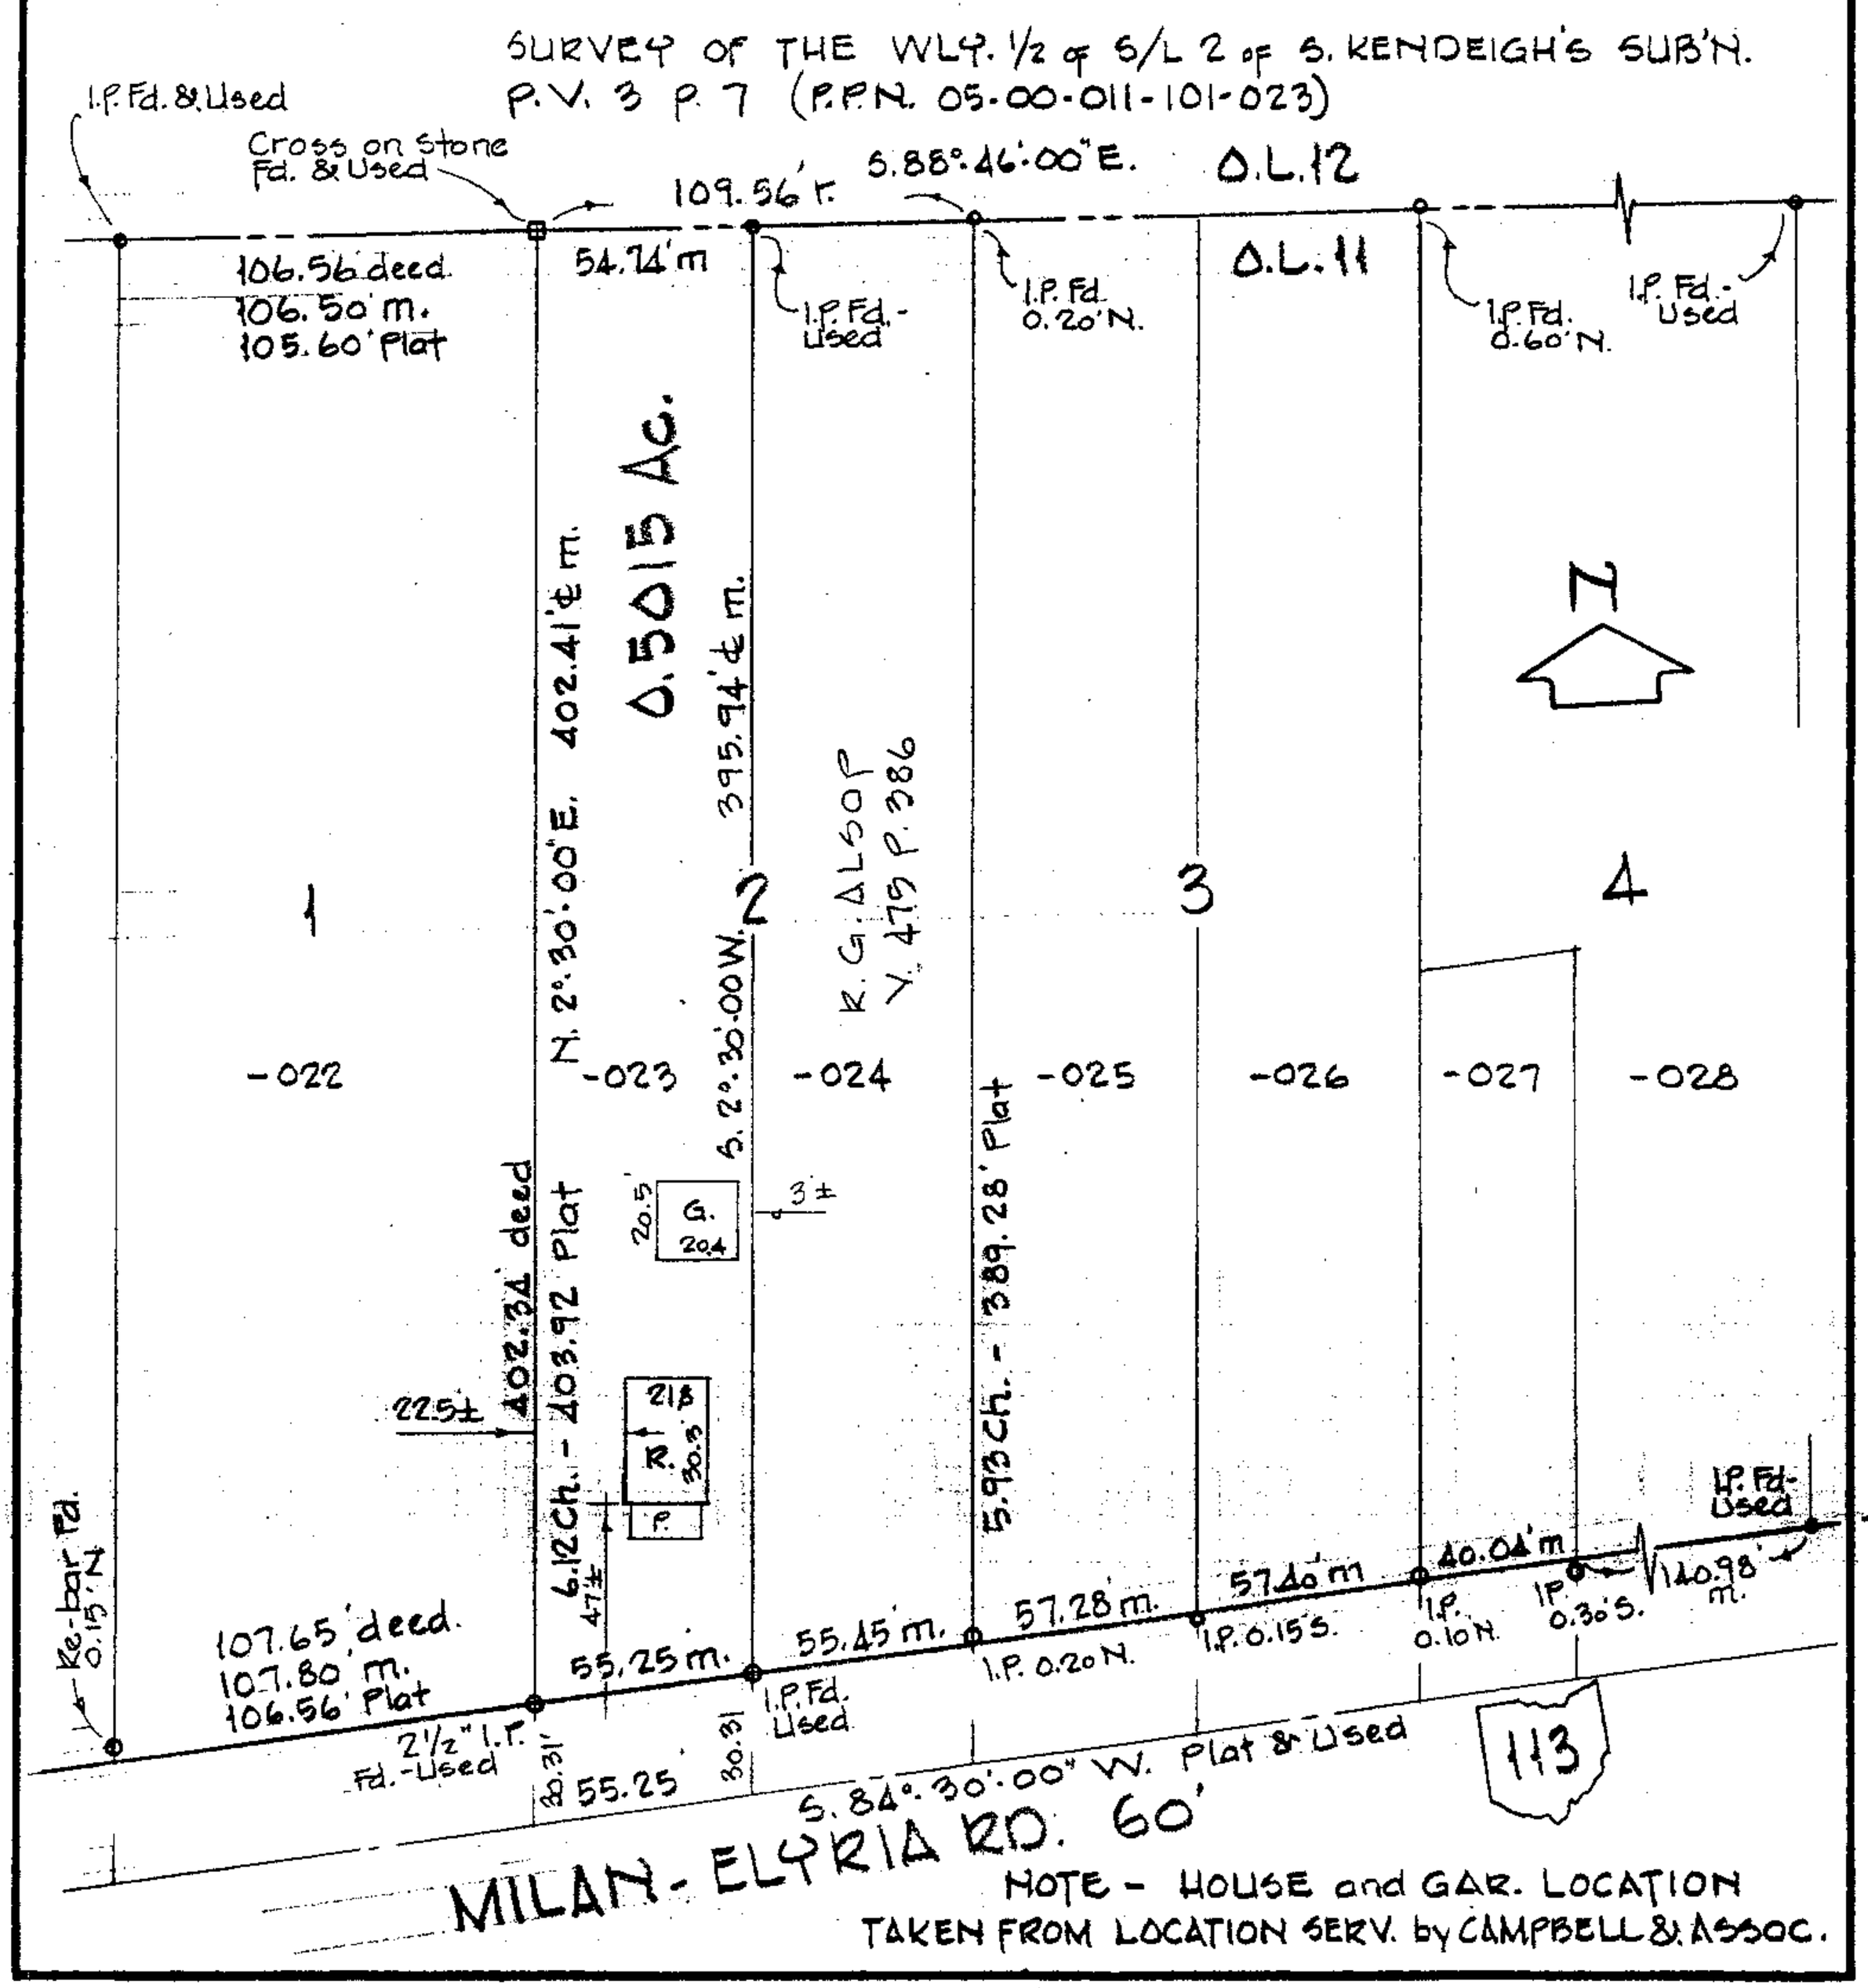

NOTE - HOUSE and GAR. LOCATION TAKEN FROM LOCATION SERV. by CAMPBELL & ASSOC.