44833

10-00-003-121-014
016

LAUNDON • SIMON • CAHL & ASSOC., INC.
CONSULTING ENGINEERS & SURVEYORS
110 MIDDLE AVE., ELYRIA, O. 44035

SURVEY FOR: 10-00-003-E

ARTHUR K. DAWSON
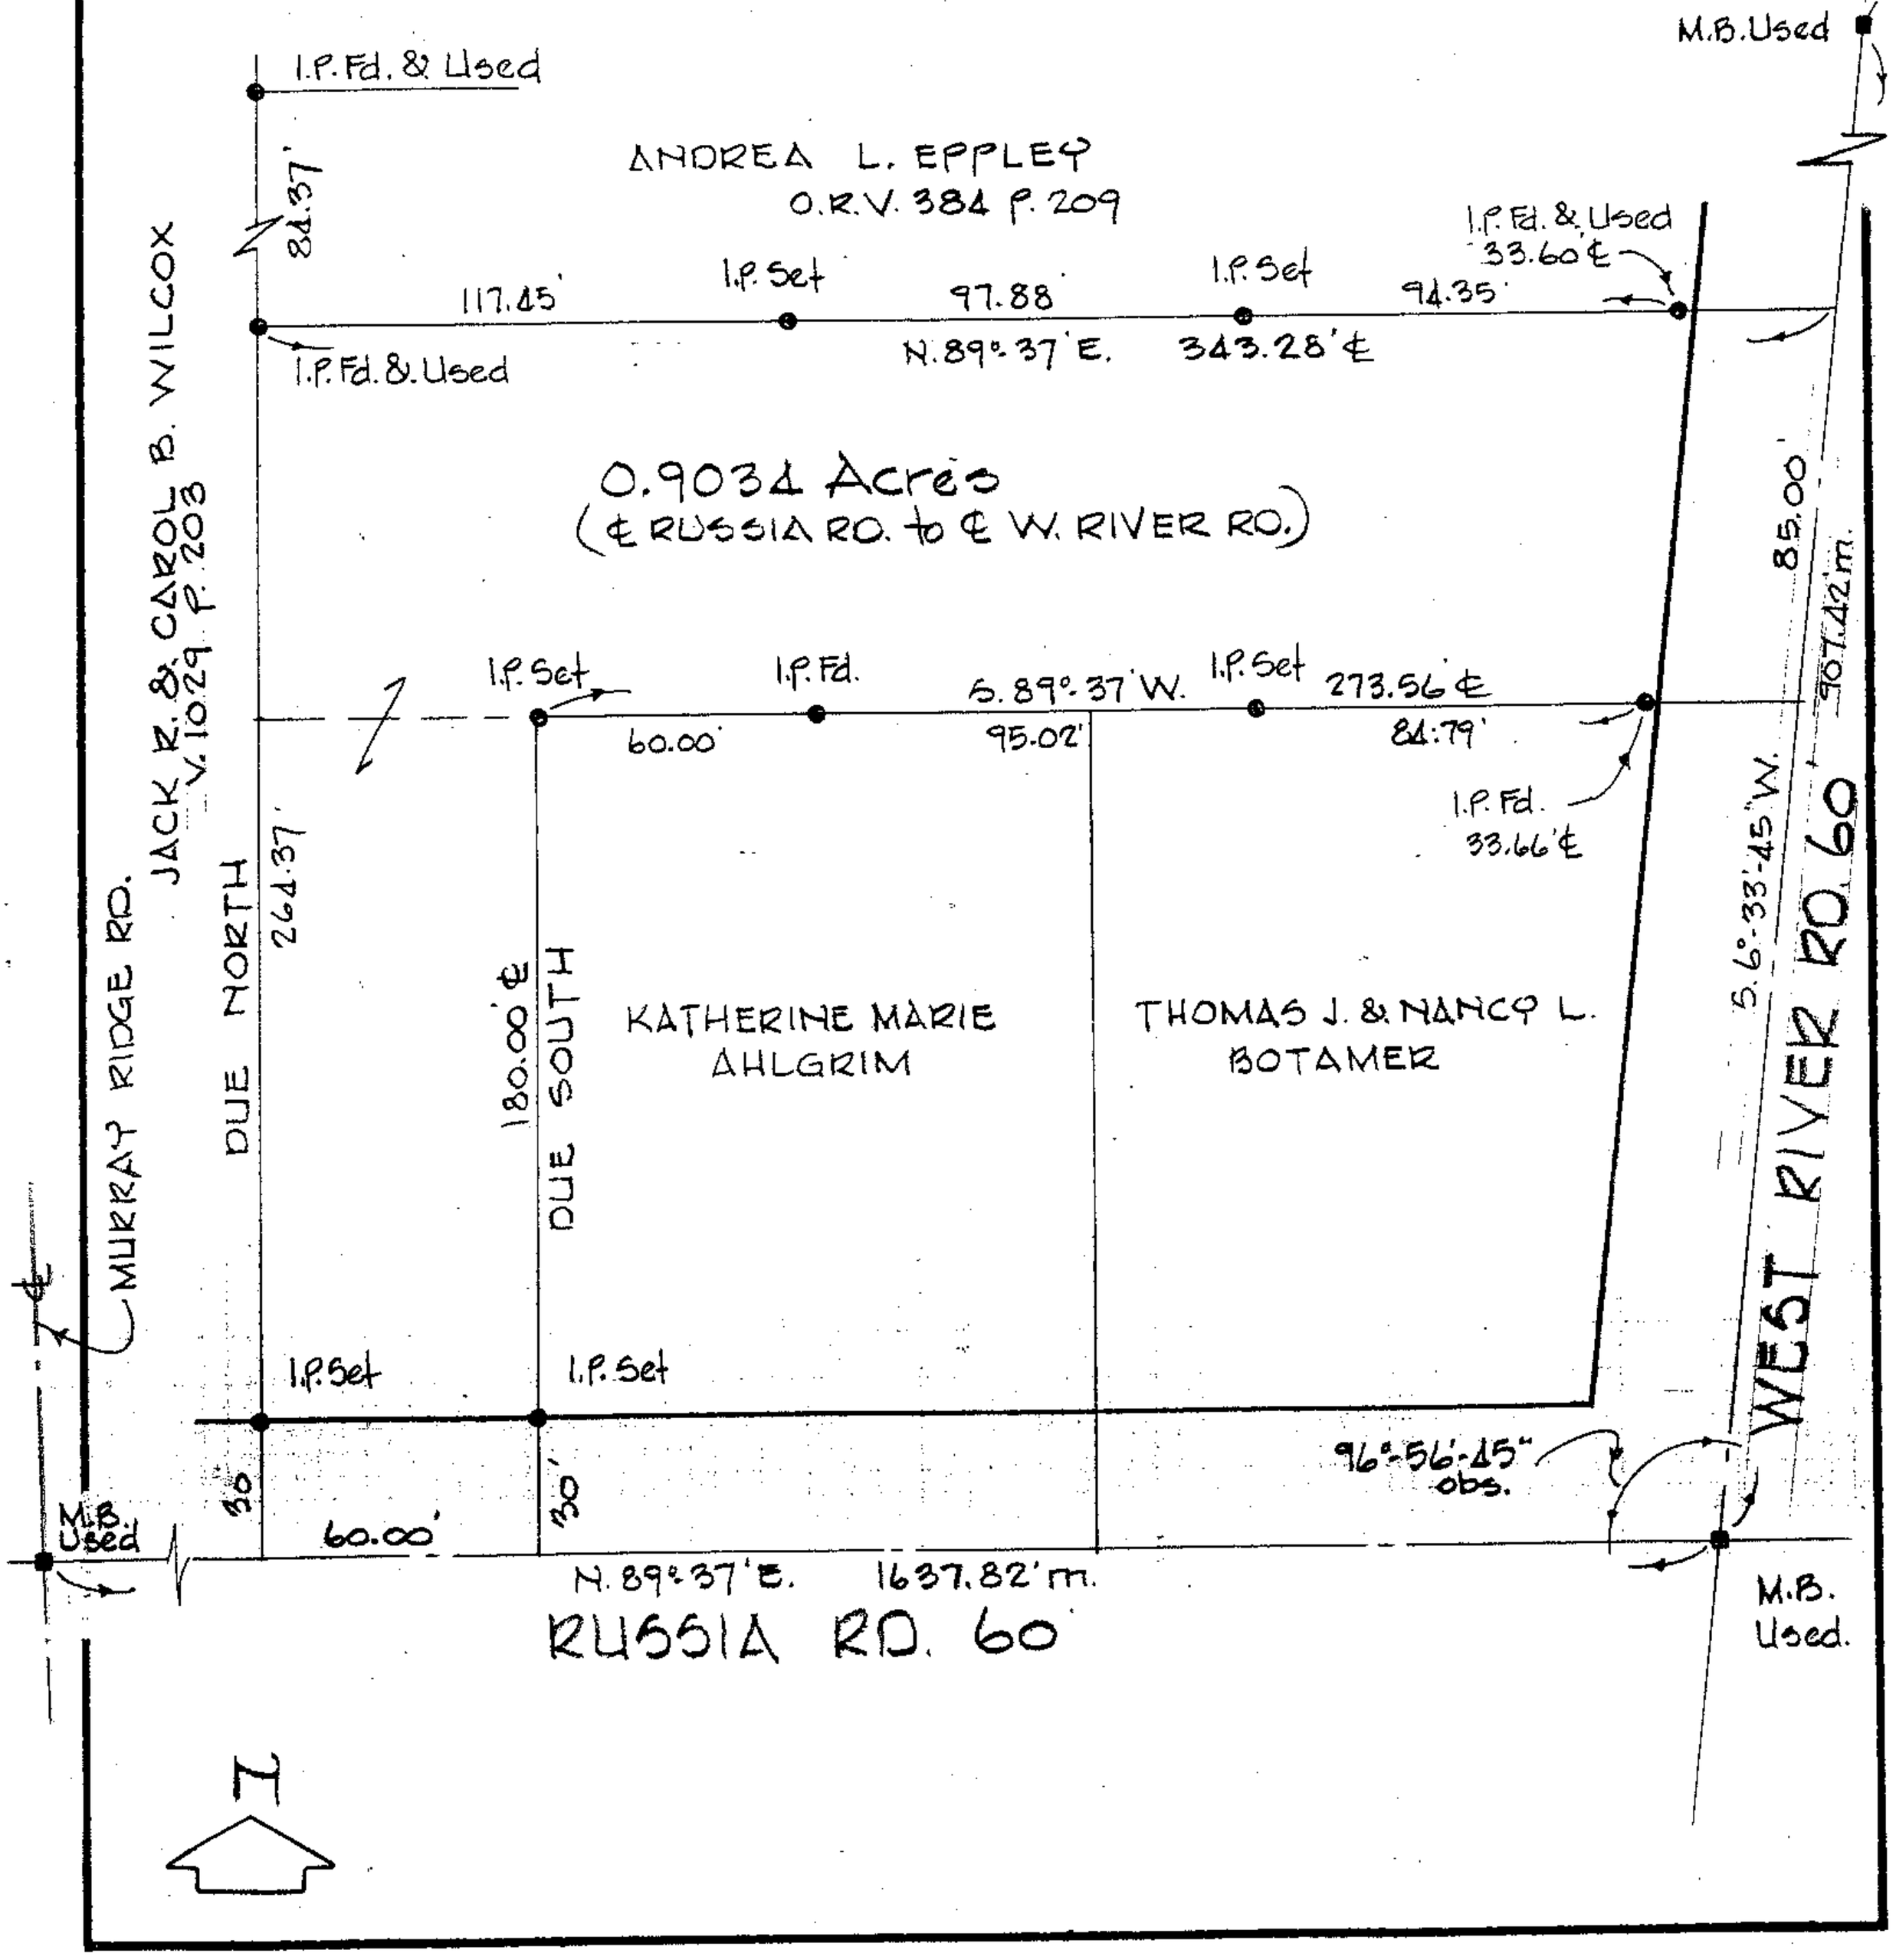
Orig. Lot	City of	Date SEPT. '92 Scale
Orig. Sec 3	Village of	Dwn. by R.G.S. Chkd. by
Tract	County of LORAIN	Job No. 92-2250 F.B. 226/31
Township of CARLISLE	State of OHIO	Printed