44837

06-24-026-121-002

LAUNDON • SIMON • CAHL & ASSOC., INC.
CONSULTING ENGINEERS & SURVEYORS
1100 MIDDLE AVE., ELYRIA, O. 44035

SURVEY FOR: 6-79

ROBT. A. SR. & GAYLE S. JOHNSON

Orig. Lot	City of ELYRIA	Date OCT. '92 Scale 1" = 20'
Orig. Sec	Village of	Dwn. by R.G.S. Chkd. by R.C.
Tract	County of LORAIN	Job No. 92-2238 F.B. 226/42
Township of ELYRIA	State of OHIO	Printed

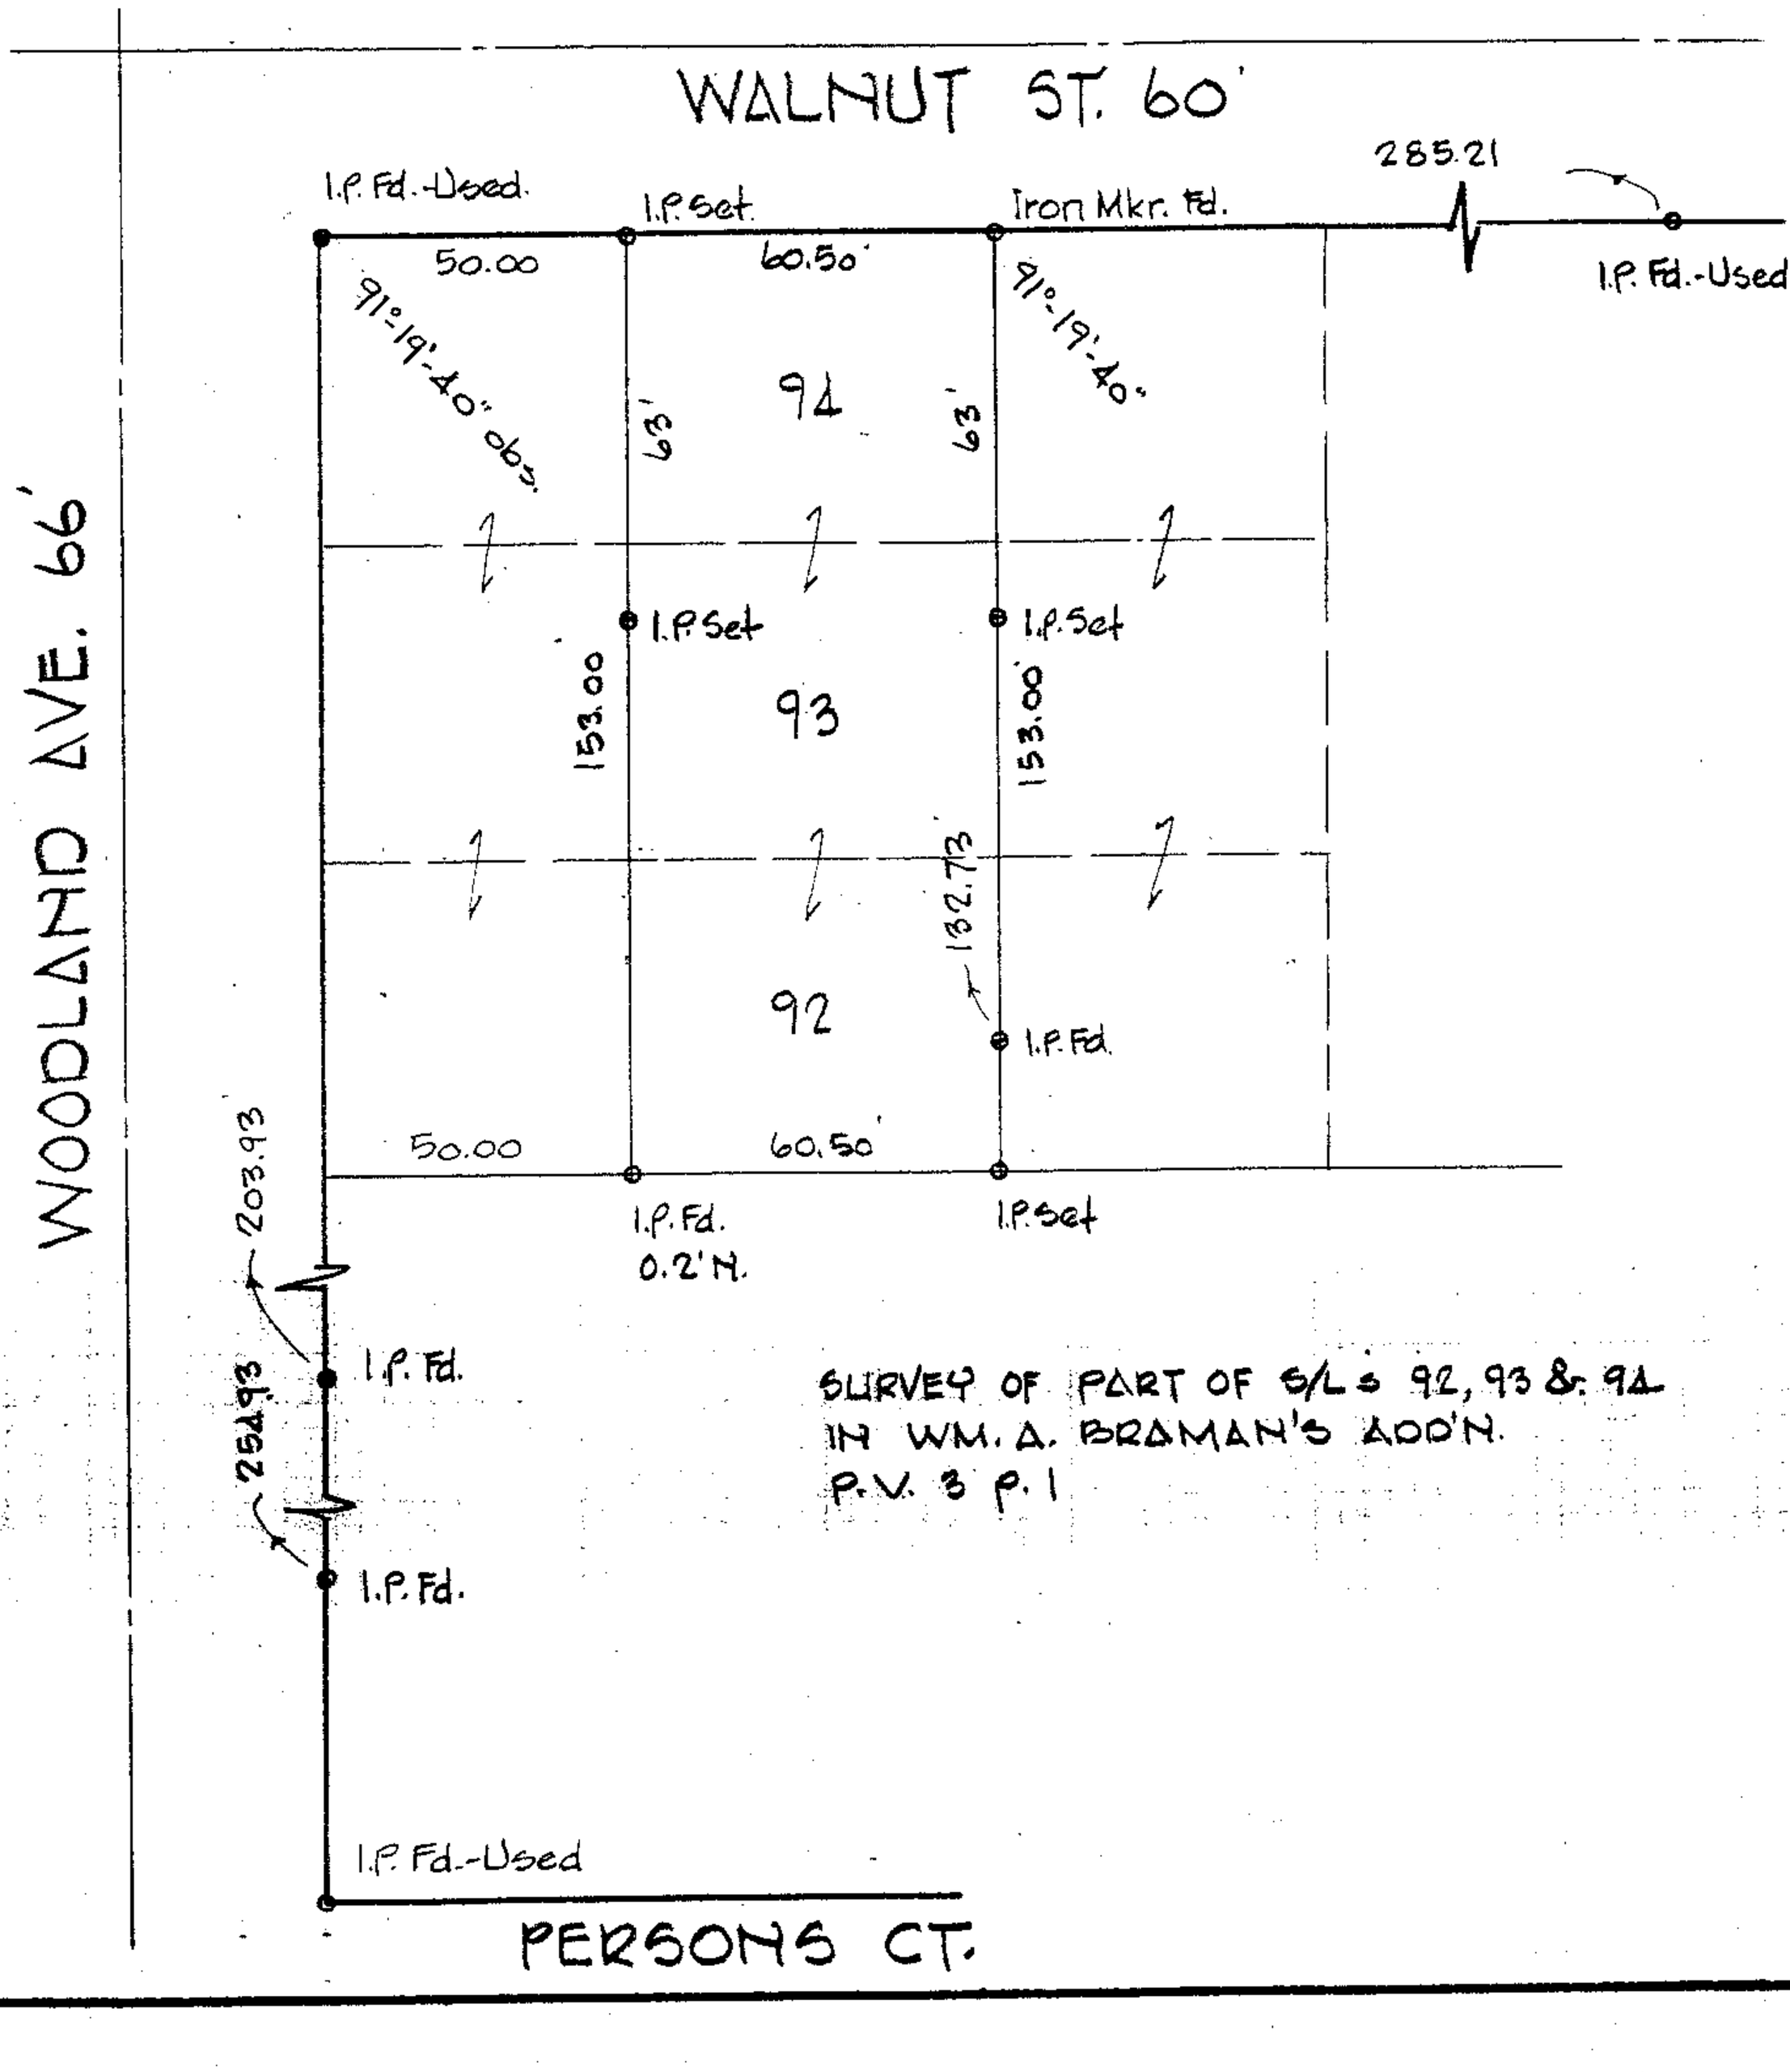

SURVEY OF PART OF S/L's 92, 93 & 94
IN WM. A. BRAMAN'S ADD'N.
P.V. 3 P. 1