#44843

06-24-032-101-007

LAUNDON • SIMON • CAHL & ASSOC., INC.
CONSULTING ENGINEERS & SURVEYORS
1110 MIDDLE AVE., ELYRIA, O. 44035

SURVEY FOR Lo-44
RUBY OAKES
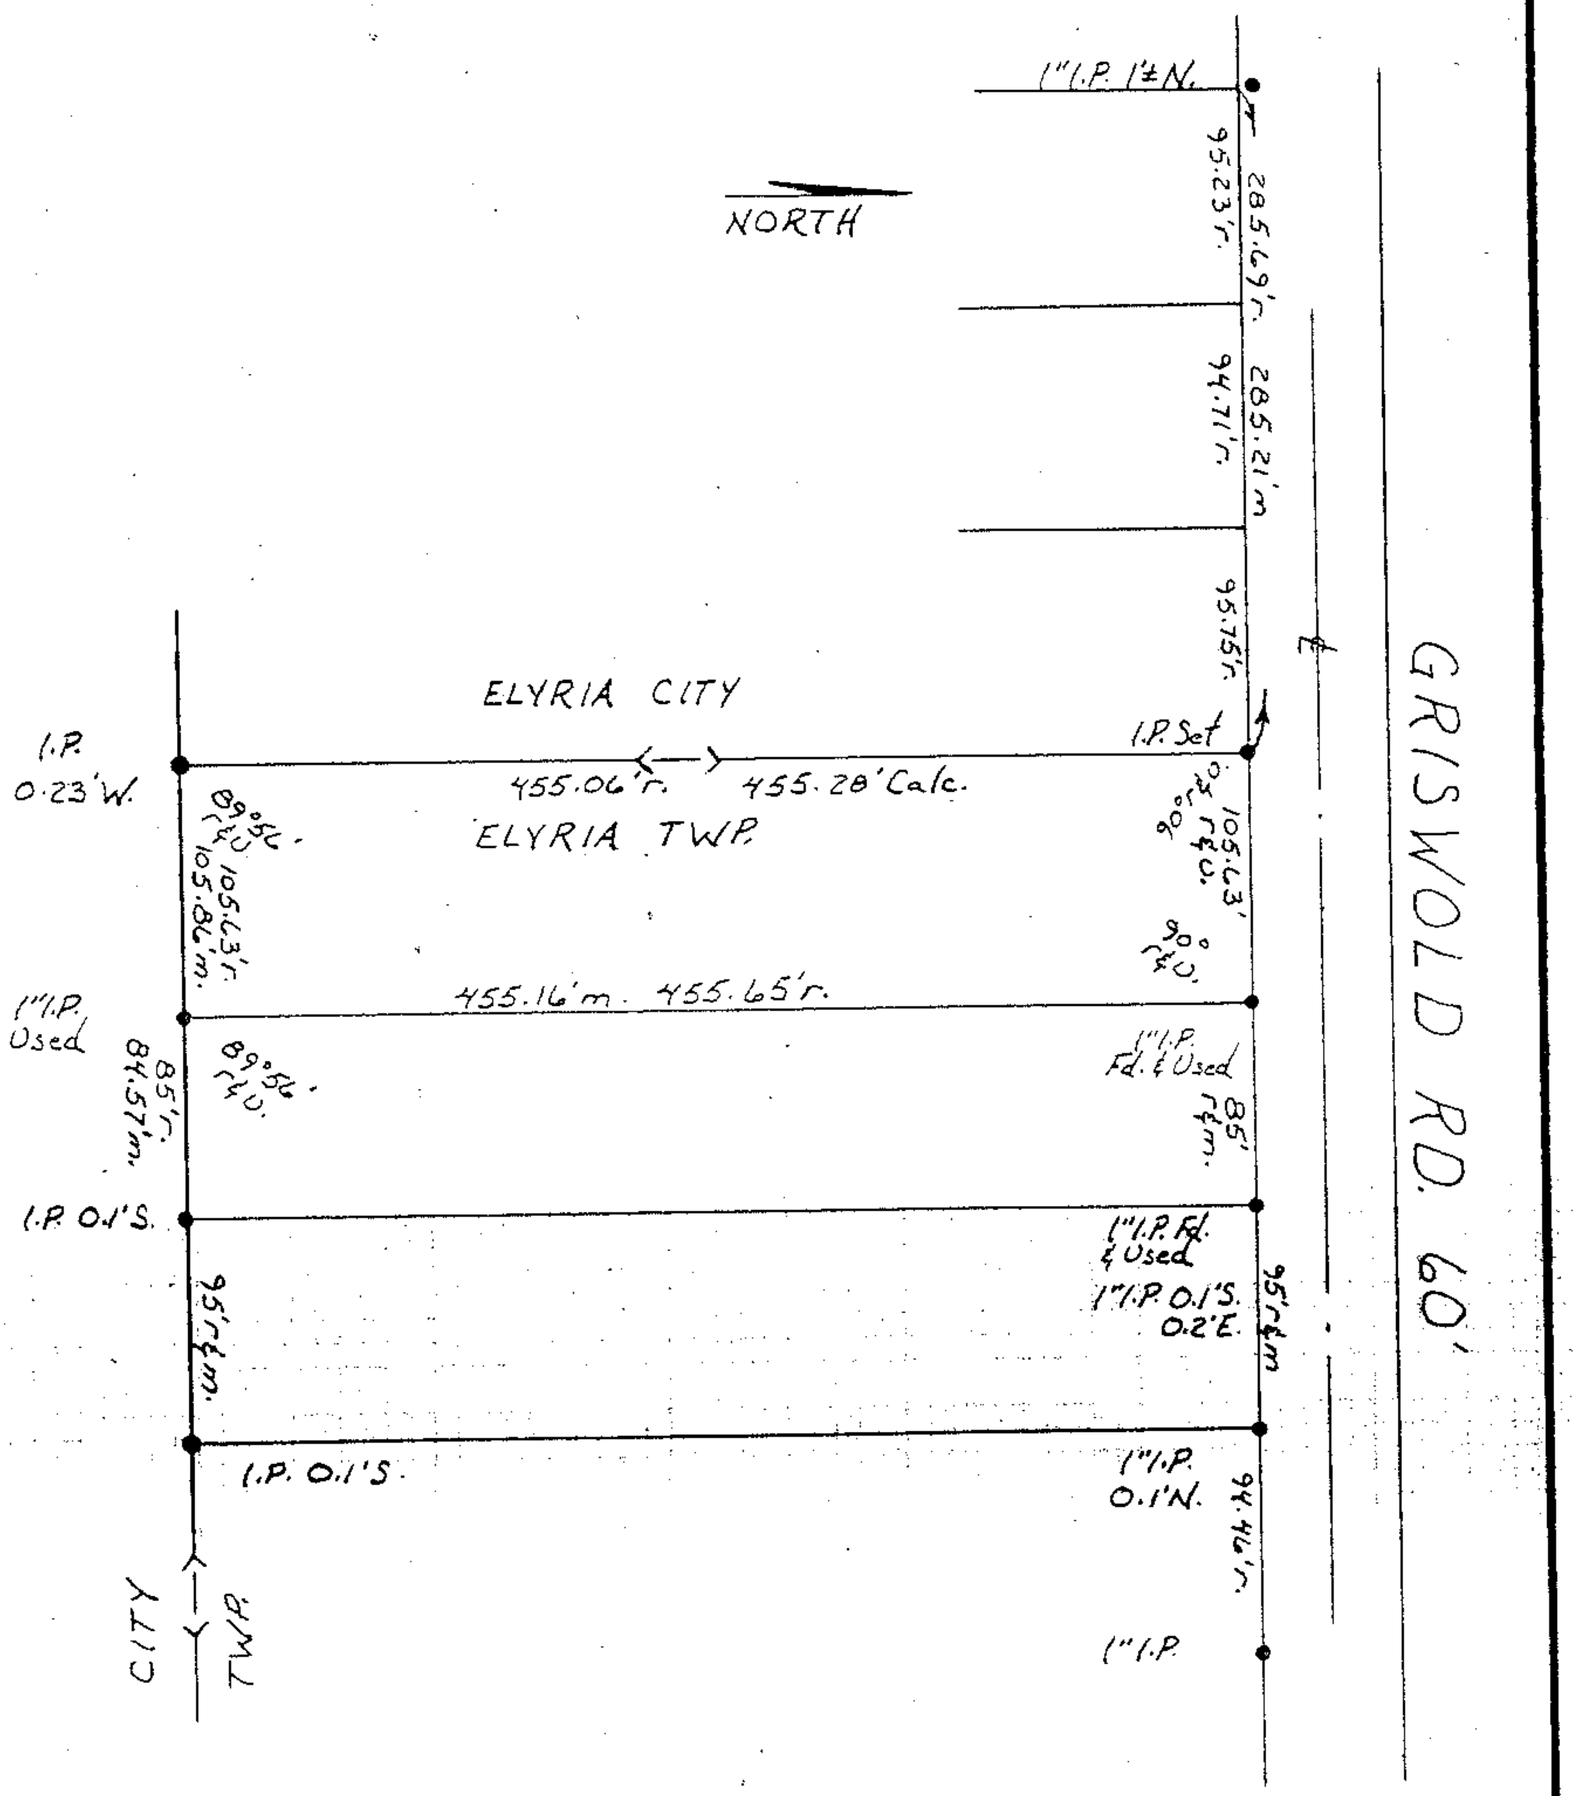
Orig. Lot 32	City of	Date 10-22-92 Scale
Orig. Sec	Village of	Dwn. by RC Chkd. by RS
Tract	County of LORAIN	Job No. 92-2211 F.B. 226-49
Township of ELYRIA	State of OHIO	Printed