#44846

6-120 06-26-035-000-008
06-26-030-000-004

LAUNDON • SIMON • CAHL & ASSOC., INC.
CONSULTING ENGINEERS & SURVEYORS
110 MIDDLE AVE., ELYRIA, O. 44035

SURVEY FOR:

MATT KROSSE
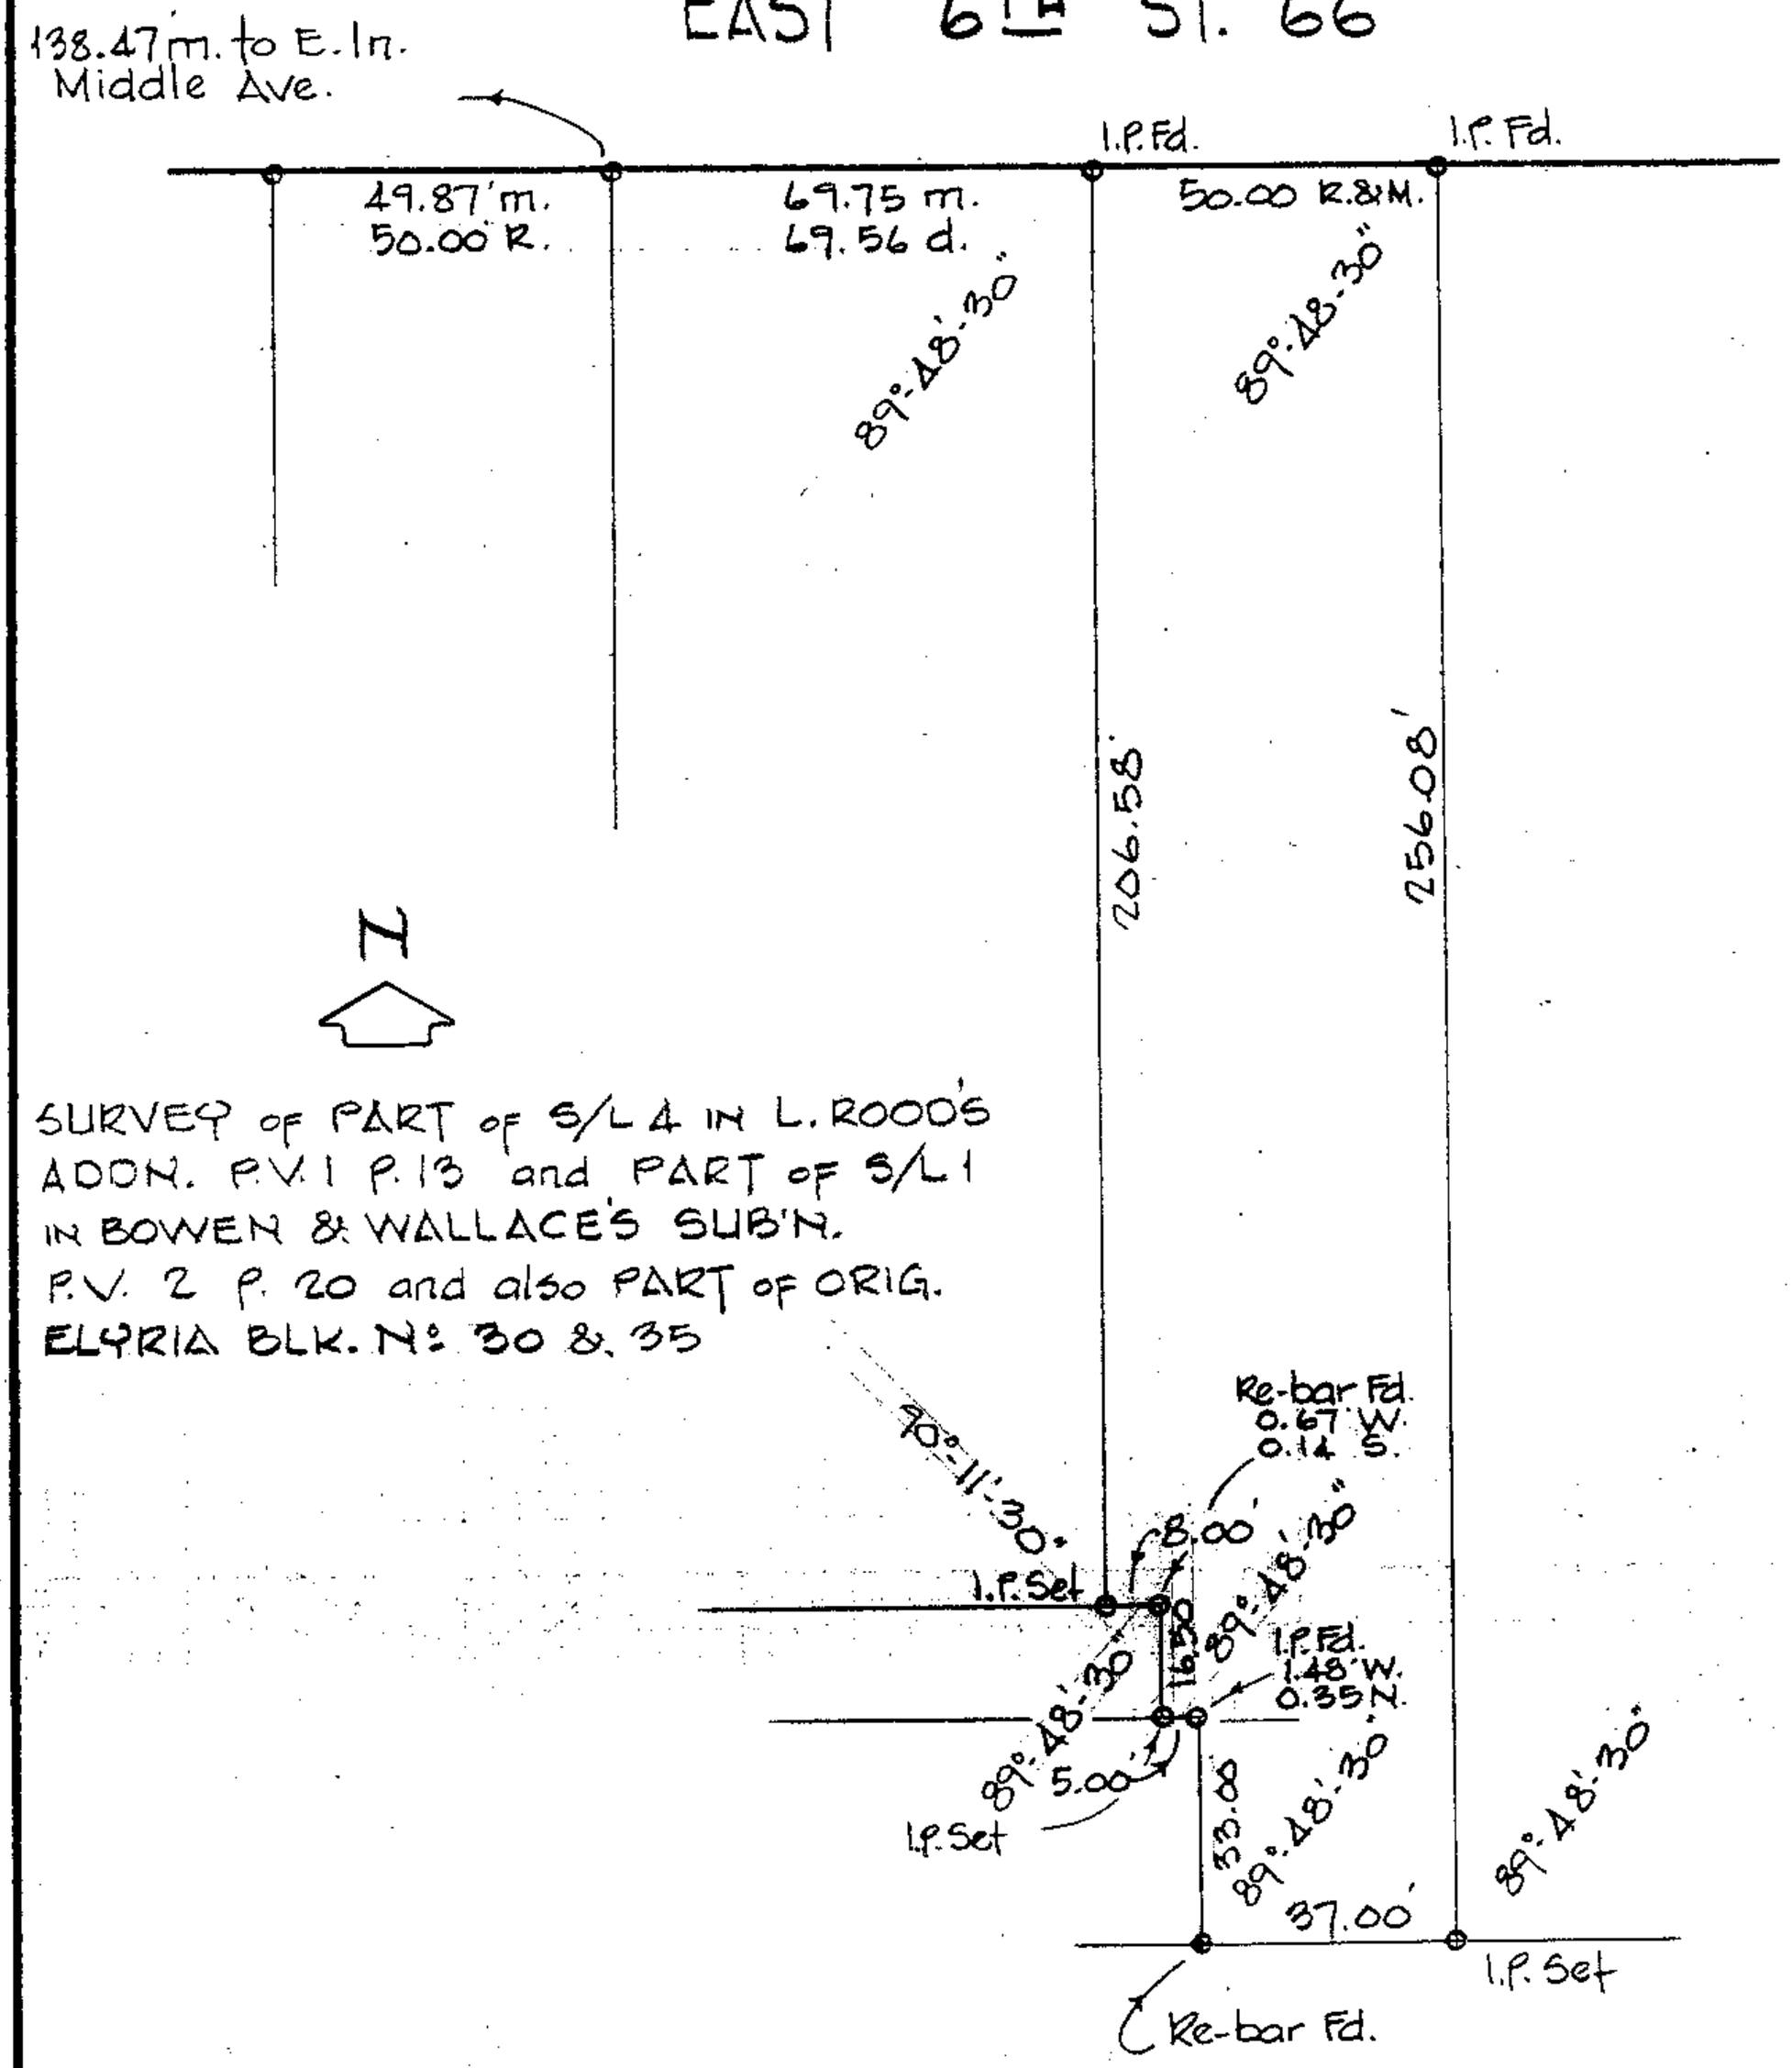
Orig. Lot 30 & 35	City of ELYRIA	Date JUNE '92 Scale 1"=40'
Orig. Sec	Village of	Dwn. by R.G.S. Chkd. by
Tract BETWEEN THE RIVERS	County of LORAIN	Job No. 92-2206 F.B.
Township of ELYRIA	State of OHIO	Printed