44855

16-00-057-000-004

LAUNDON • SIMON • CAHL & ASSOC., INC.
CONSULTING ENGINEERS & SURVEYORS
1110 MIDDLE AVE. ELYRIA, O. 44035

SURVEY FOR 16-F

DONNA MARIE WAKEFIELD
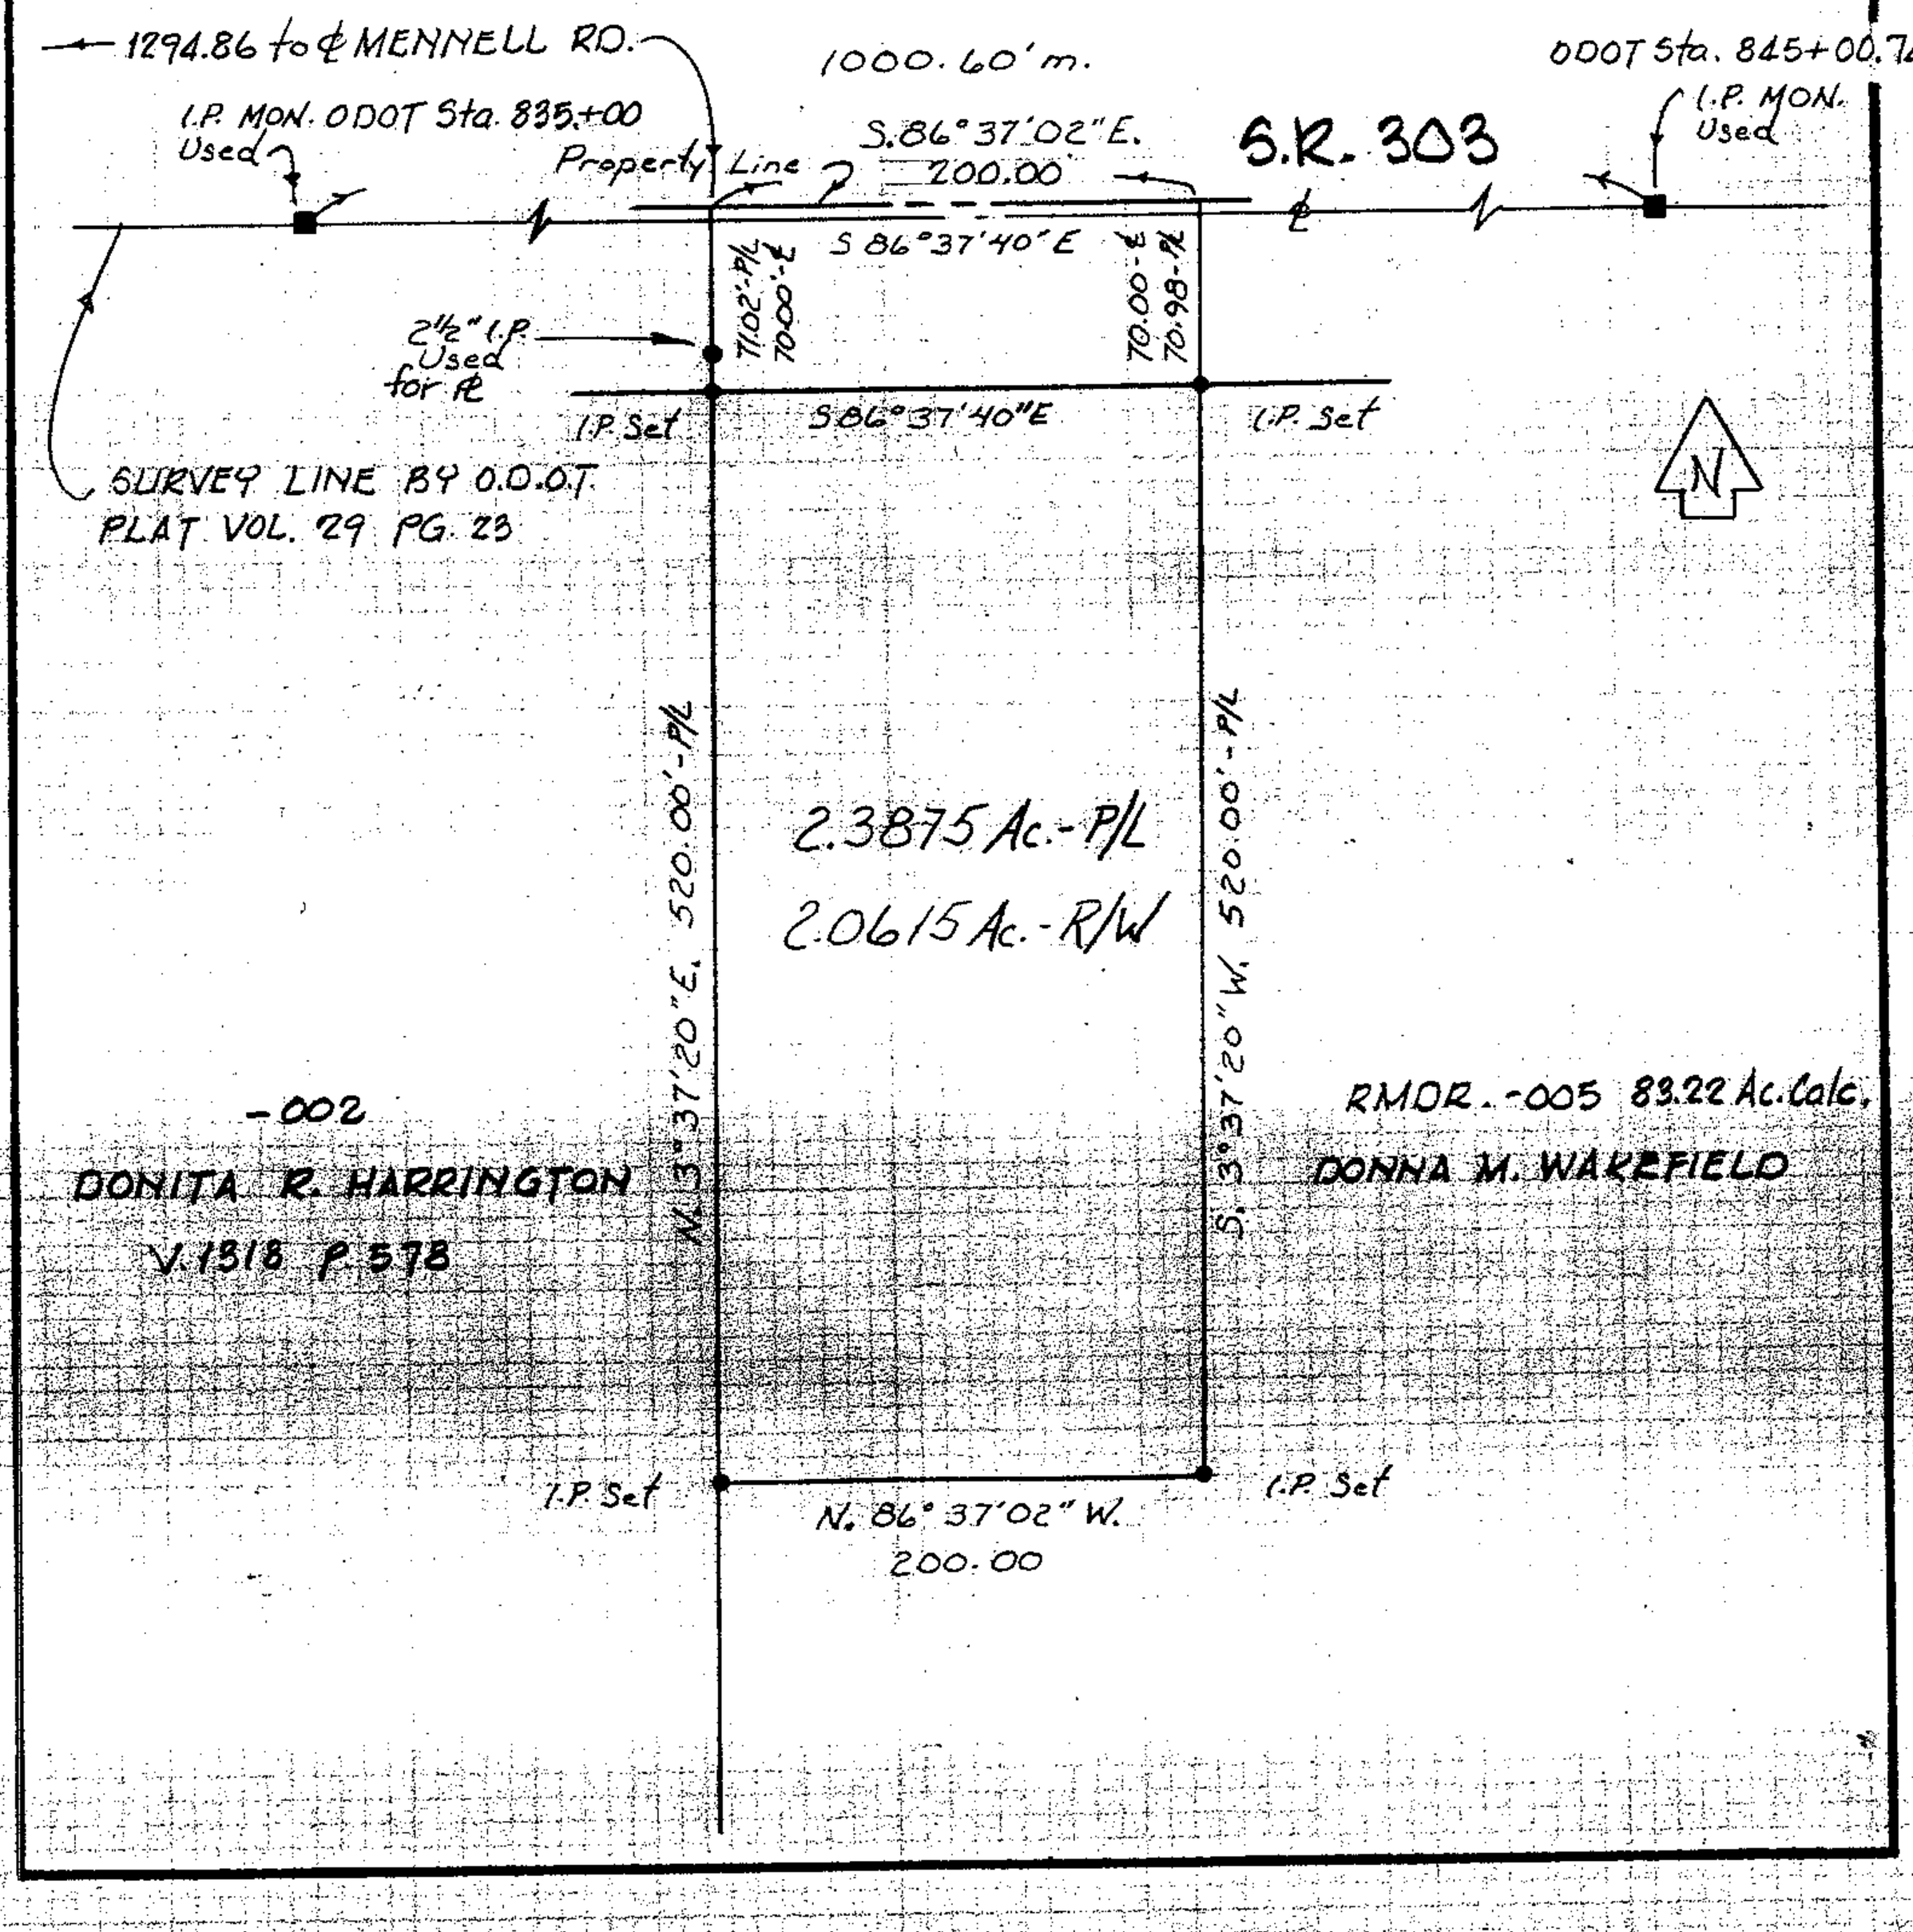
Orig. Lot 57	City of	Date APRIL 1992 Scale 1"=100'
Orig. Sec	Village of	Dwn. by RC Chkd. by RGS
Tract	County of LORAIN	Job No. 92-2175 F.B.
Township of GRAFTON	State of OHIO	Printed